


GRUNNMYND 1. HÆÐ 1:50

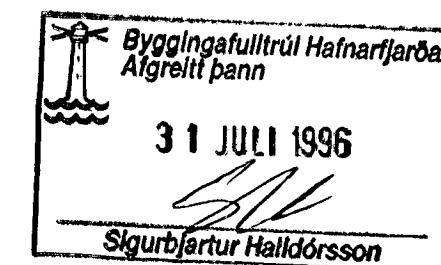

BR:      DAGS      EDLI BR.      SIGN.

LINDARBERG 98  
HAFNARFIRÐI

HITA- OG VATNSLAGNIÐ

DAGS: JULI 96  
VERK NR. 9611  
TEIKN NR. 2-03  
HANNAD: d.h. g.m.  
TEIKNAD: d.h.  
YFIRFARIÐ



STRANDGÖTU 11 - 220 HAFNARFJÖRDUR - SIMI 555 4255 - FAX 565 2875