
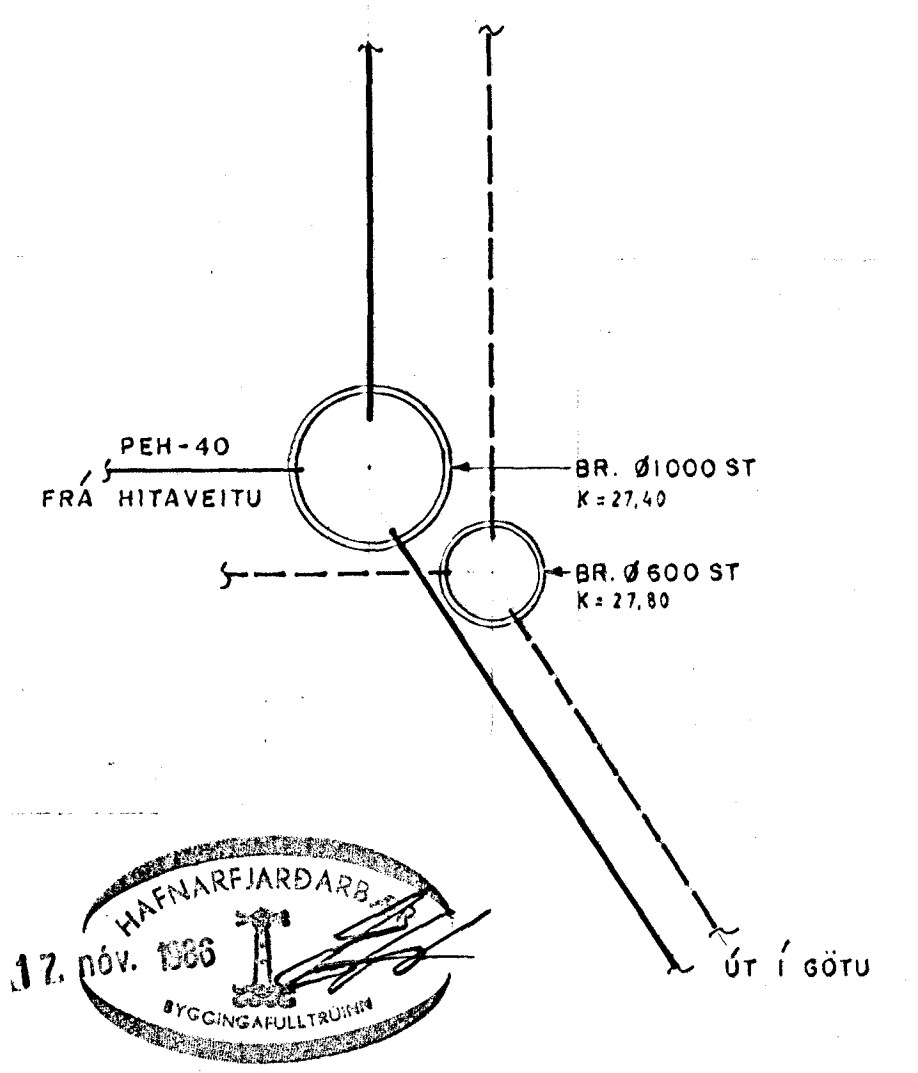


GRUNNMYND
1:50

Ø100 P, 15‰

BR. Ø600 ST
K=28,10

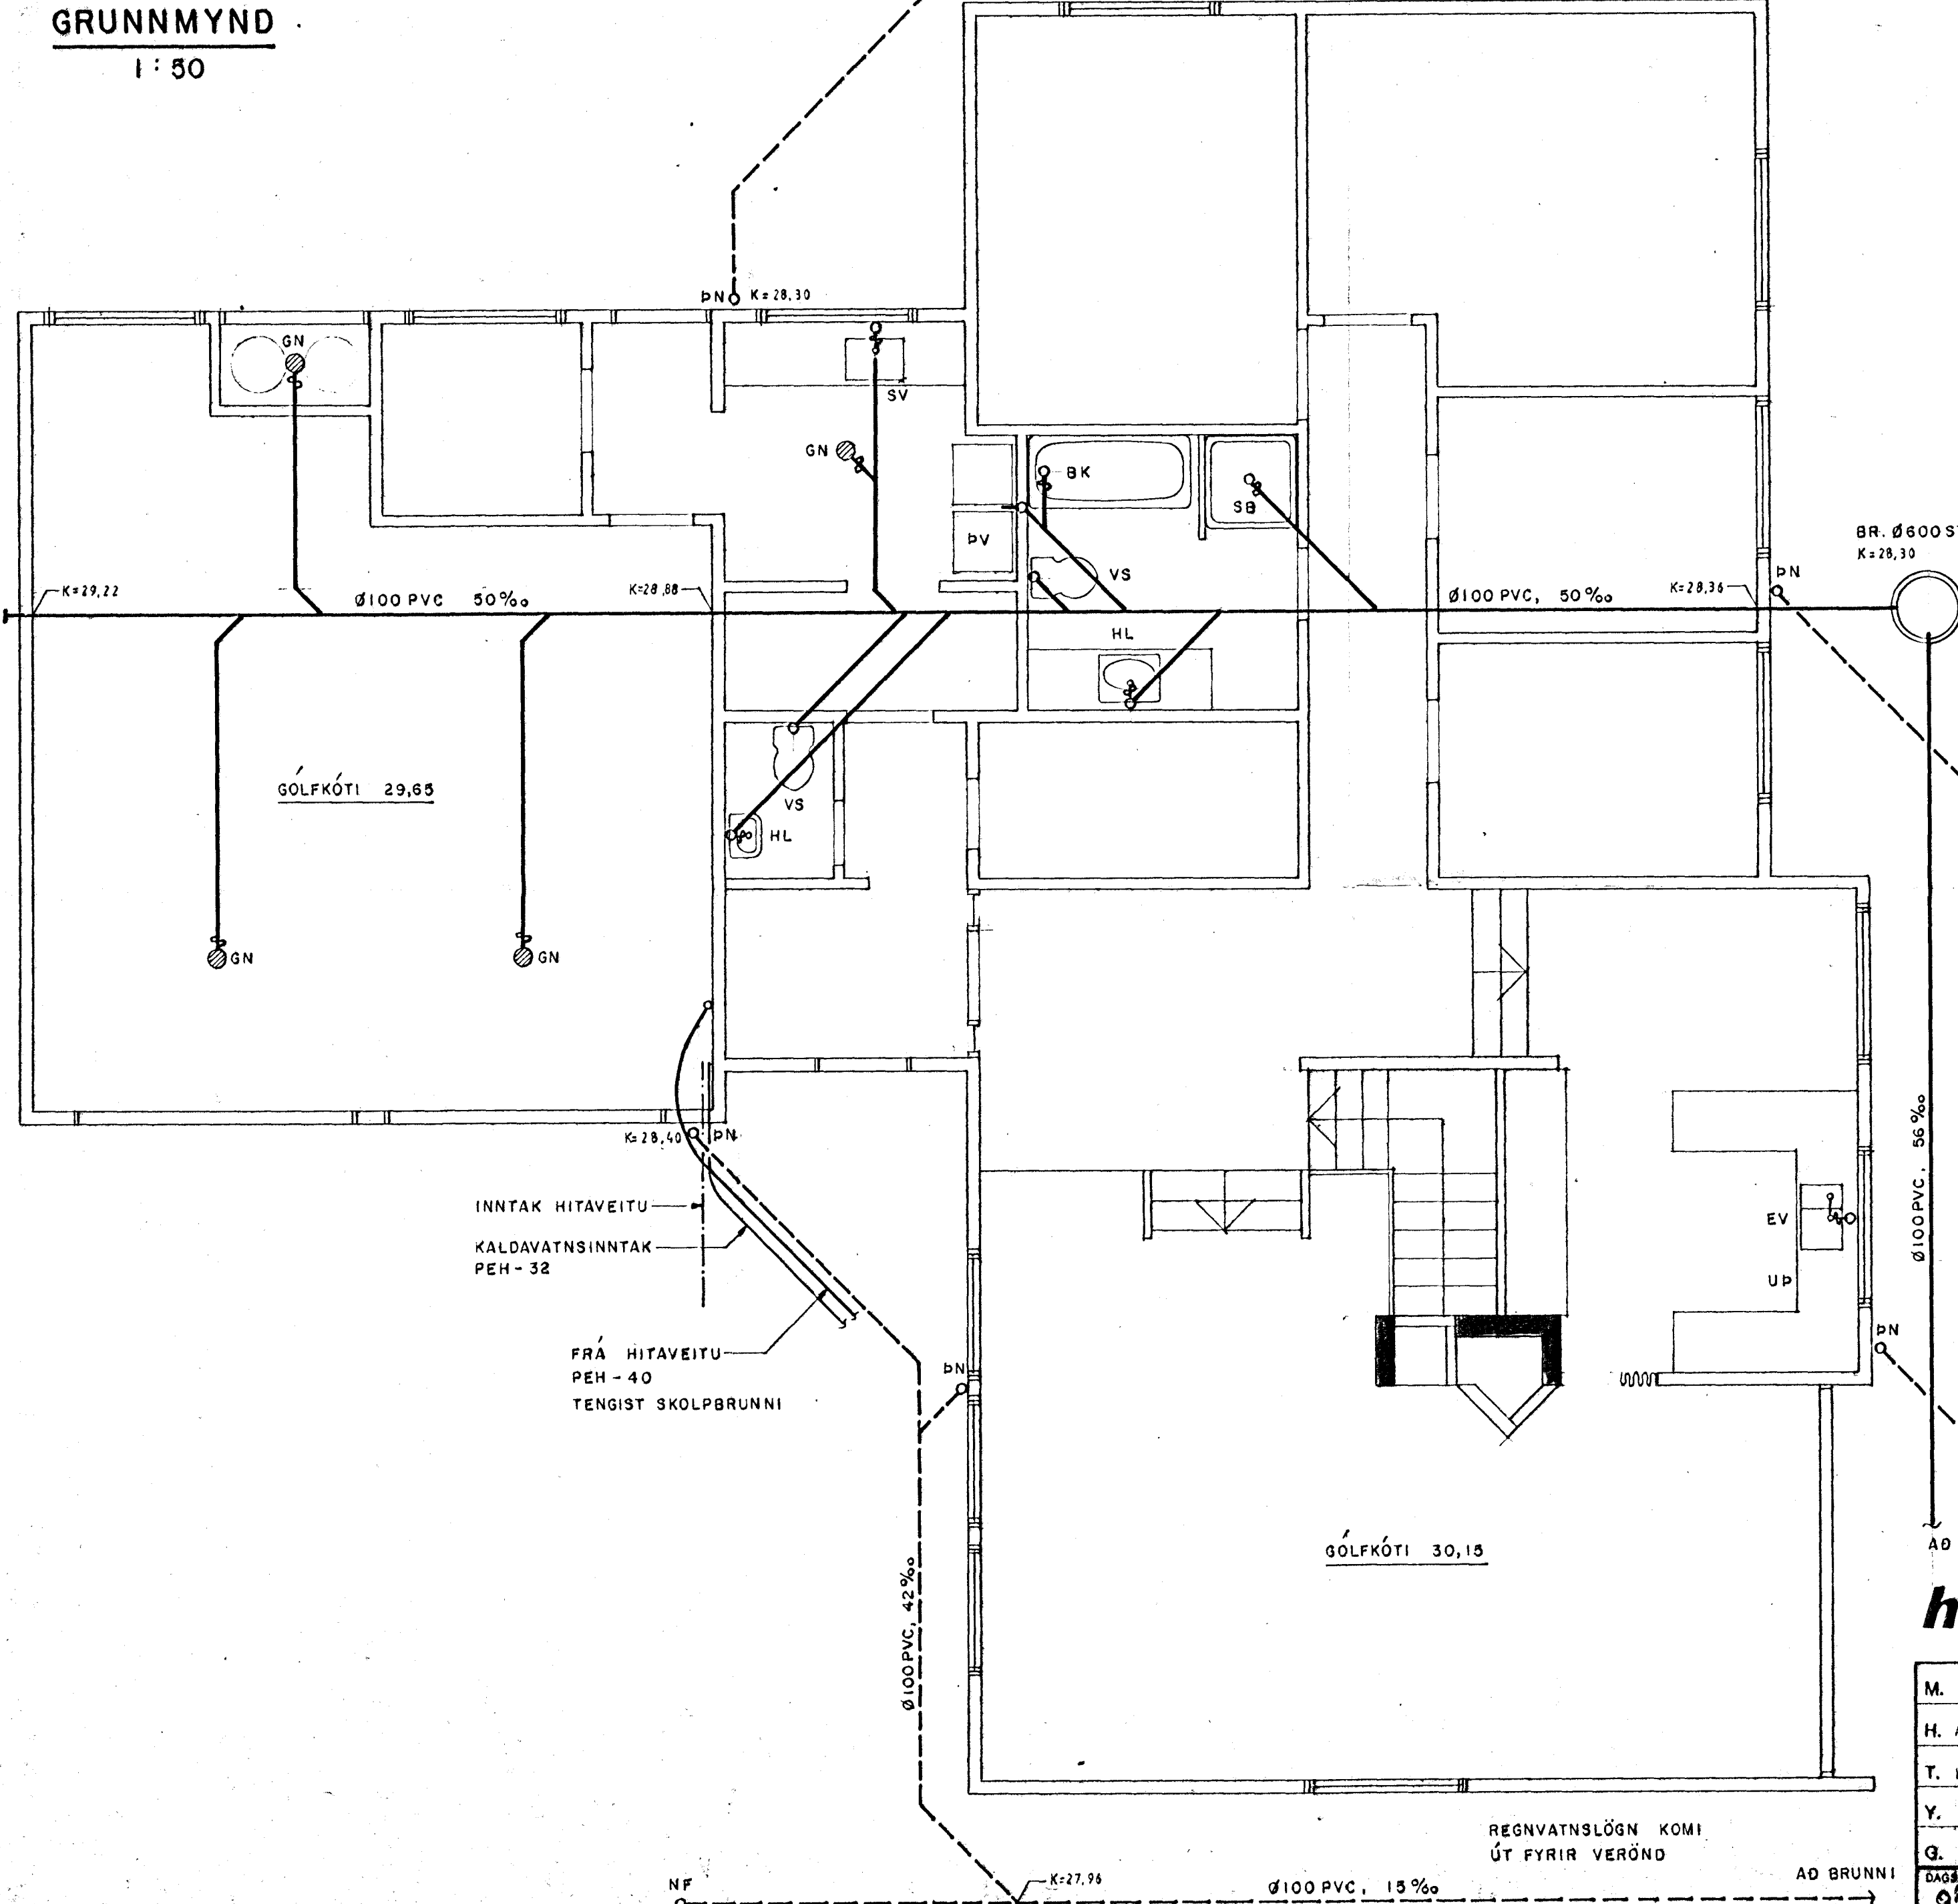

INNTAK HITAVEITU
KALDAVATNSINNTAK
PEH-32
FRÁ HITAVEITU
PEH-40
TENGIST SKOLPBRUNNI

SKÝRINGAR: SJÁ TEIKN. NR. - 201

hönnun hf Ráðgjafarverkefndingur FRV · Síðumúla 1 · 108 Reykjavík
Sími (91)84311 · Utíbú: Reyðarfjörður · Hvolsvöllur

M.	LJÓ SABERG 40, HAFN.F.	E
H. A. B.		D
T. Kaþo		C
Y.		B
G.		A INNTÖKUM BATT INN Á NÓV'86 140
DAGS OKT. '86	SAHM Sveinur A. Gudman	MKV. 1:50
		86384 - 202

REGNVATNSLÖGN KOMI
ÚT FYRIR VERÖND
AD BRUNNI

Ø100 PVC, 15‰