


Sambykkt á fundi bygginga-
24/10 '93
nefndar þ. 16.13.1994


BYGGINGAFULLTRÚNNI
Í HAFNARFIRDI

fl. G.Ö


mylpa skal ábendingum
byggingafulltrúa.

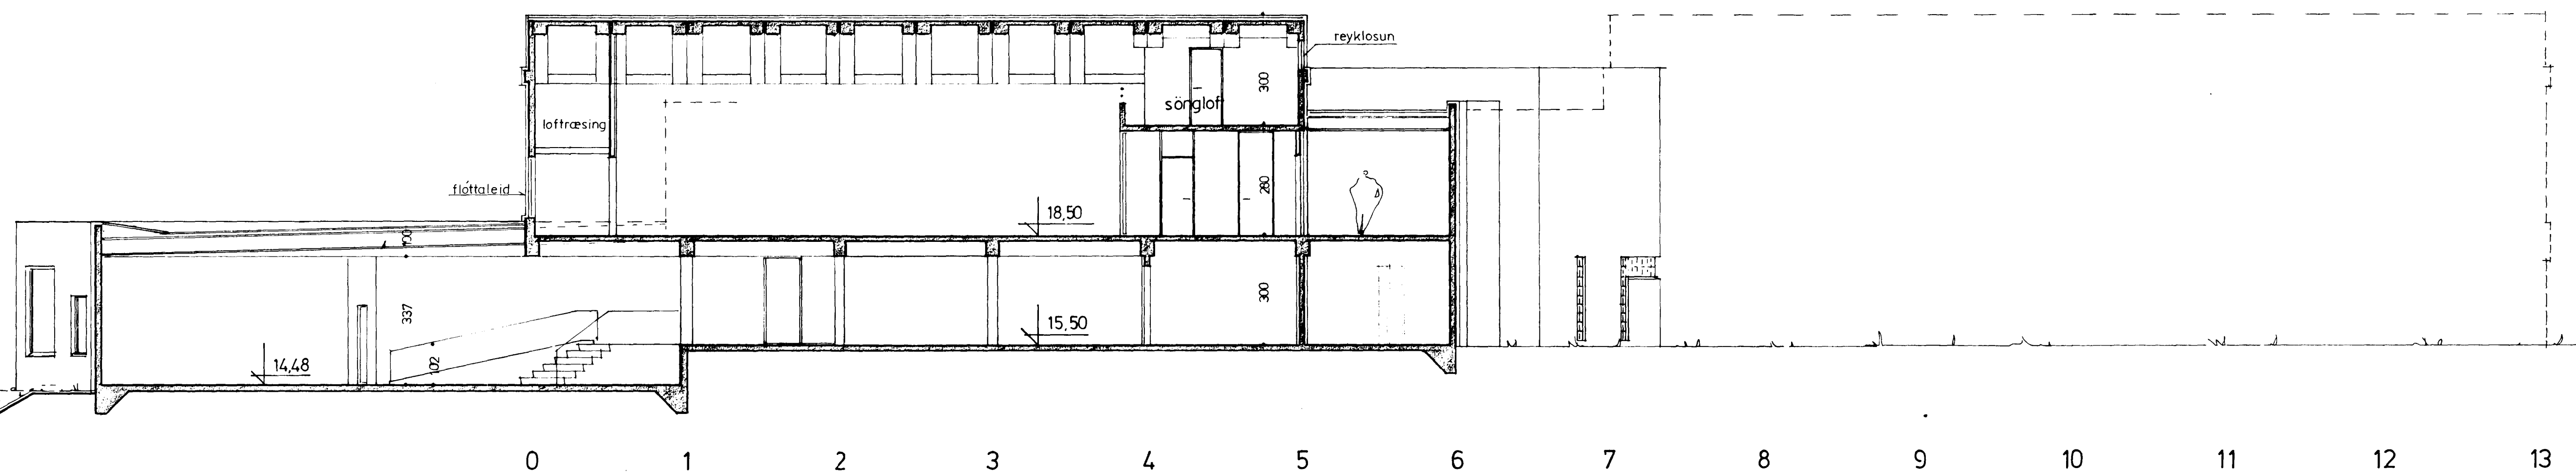

sneiding b - b

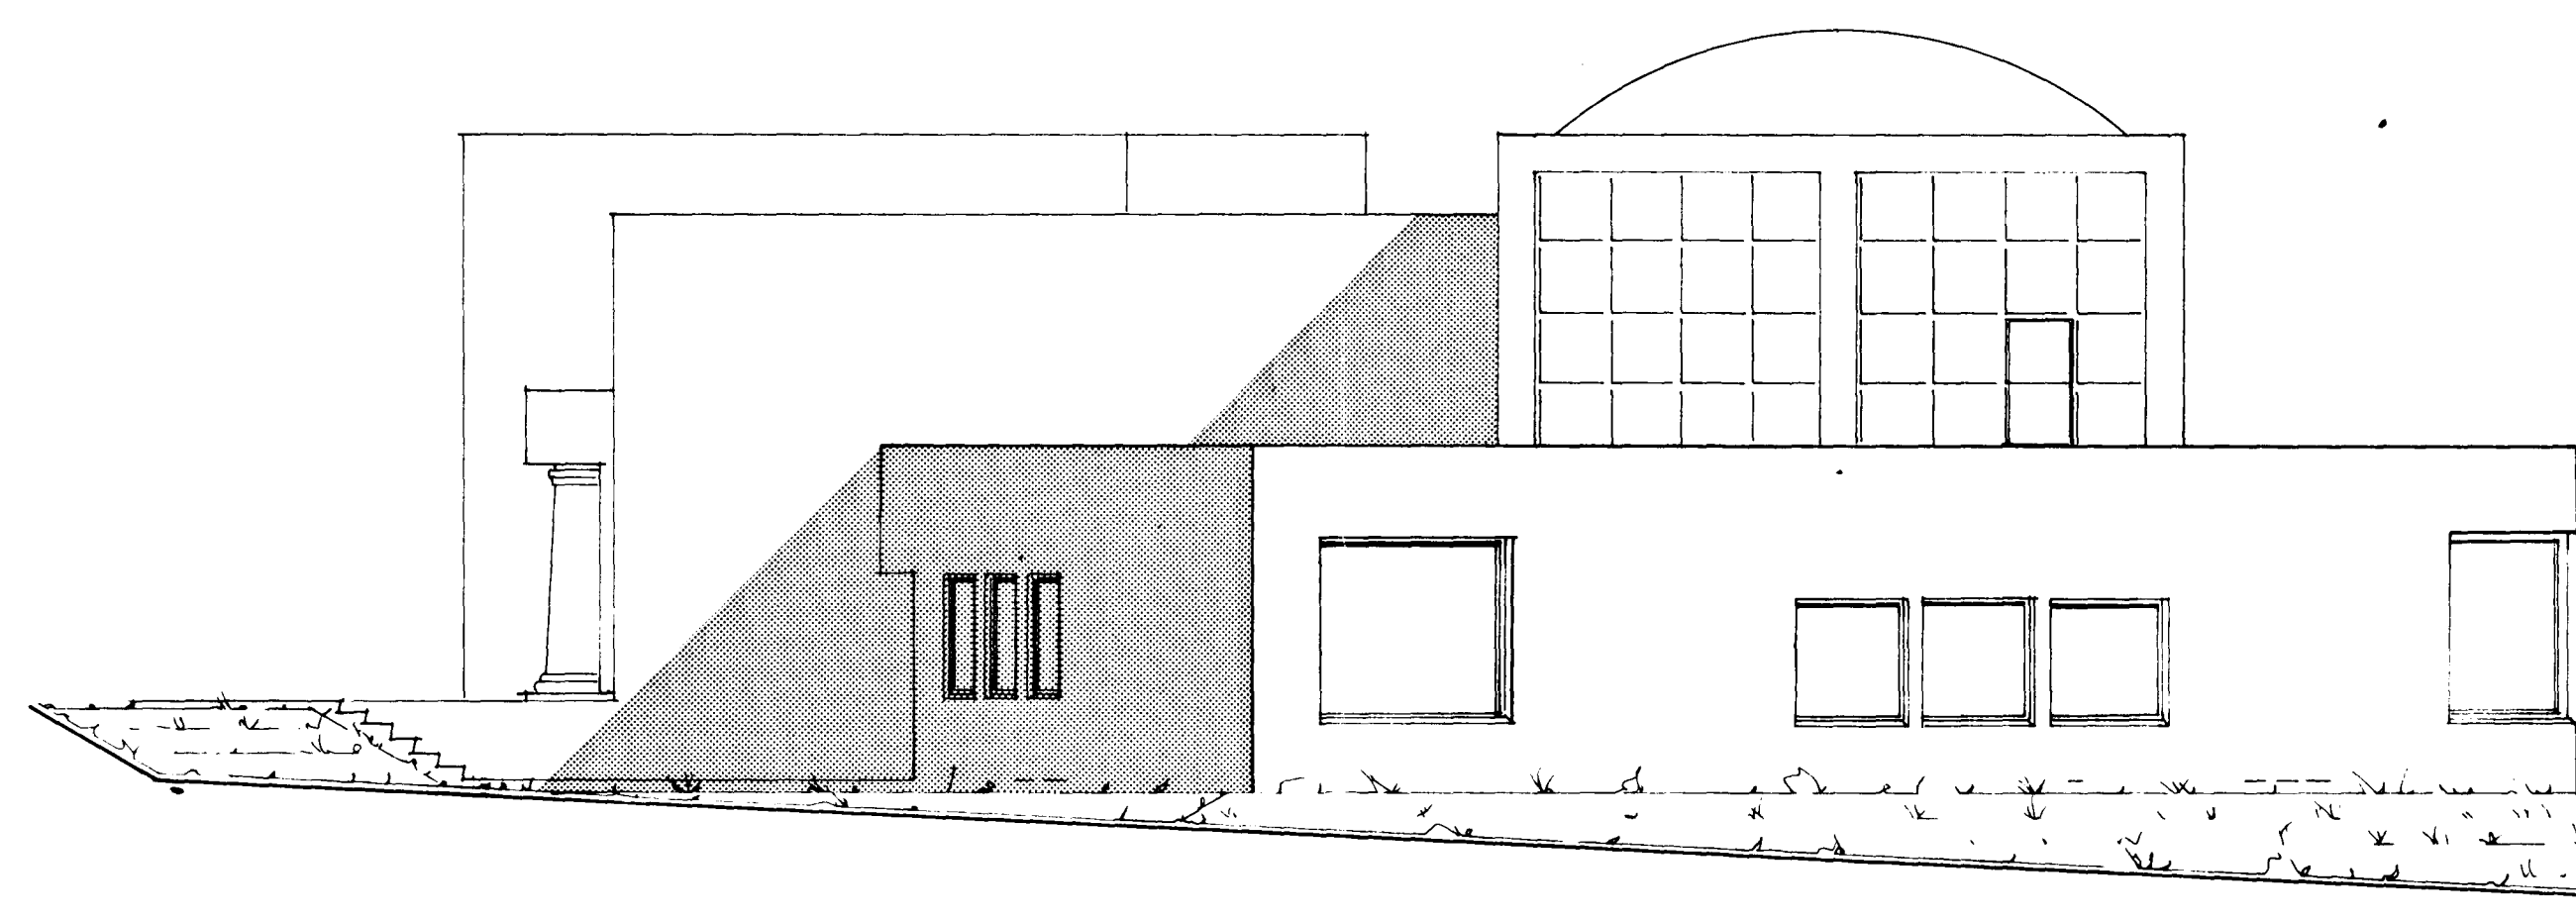


útlit nord vestur

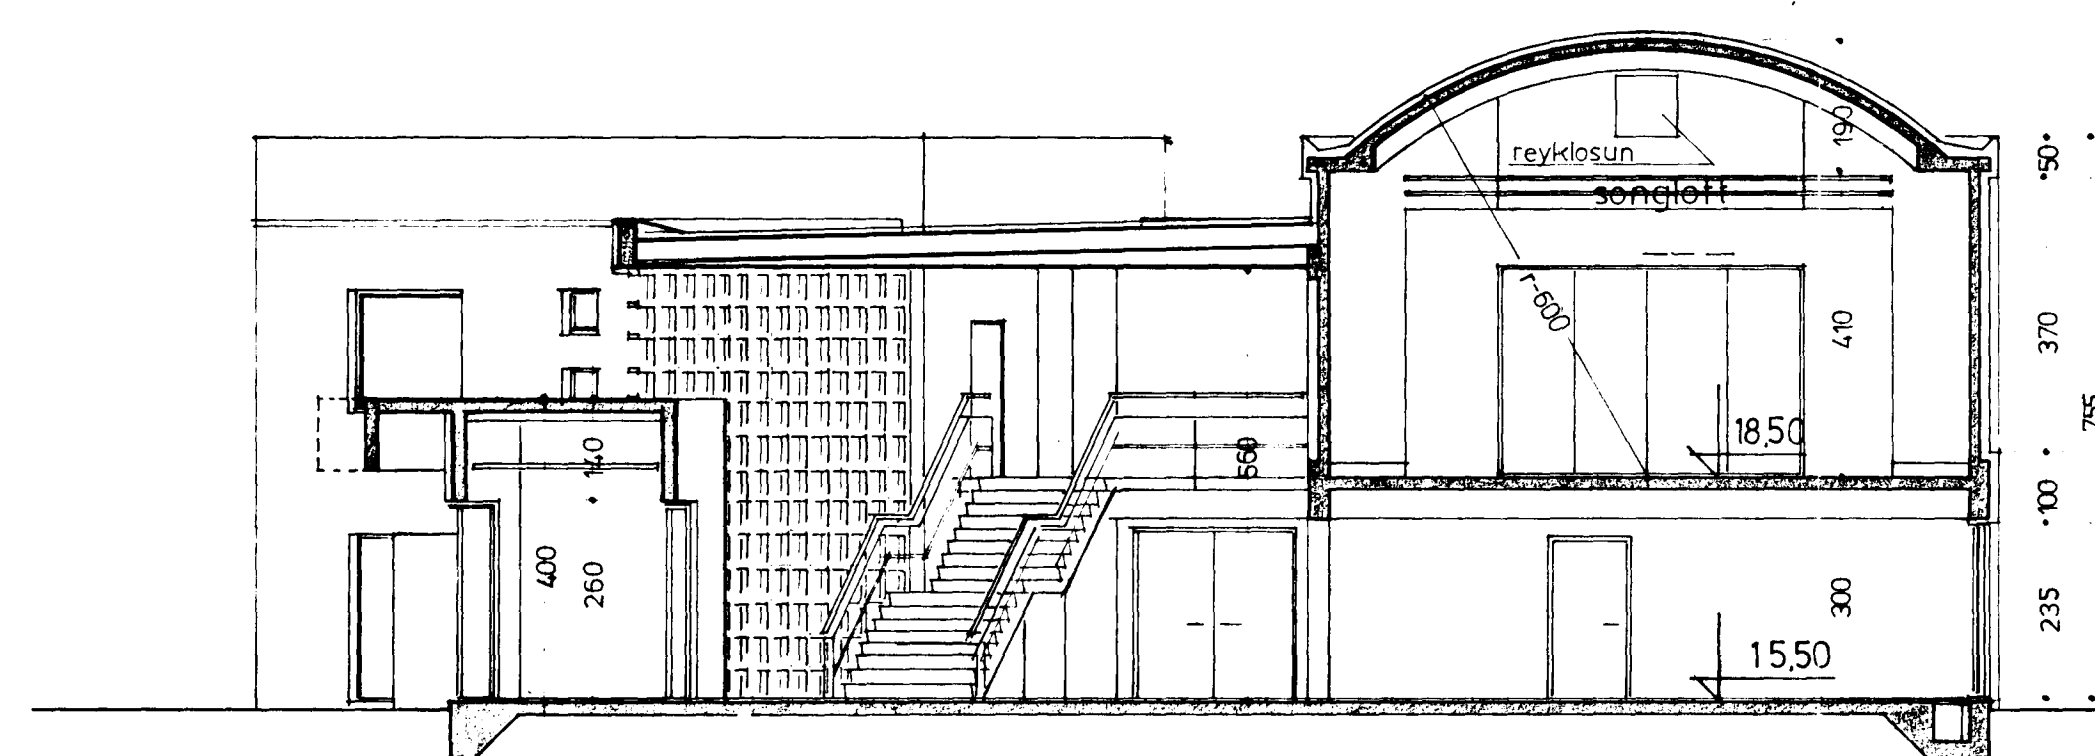

sneiding a - a

stífluveggur koti 14,90
vatnsyfriborð ca 14,15

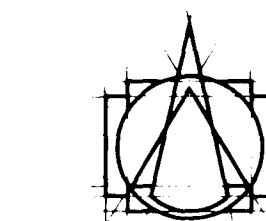

TEIKNISTOFAN HI
ARMÚLAC
108 REYKJAVÍK 4 SÍMI 38750

GISLI HALLDÓRSSON ARKITEKT FAI
JÓSEF REYNIS ARKITEKT FAI
LJUVISLASON BYGGINGAFRÁÐINGUR FAI
HALDÓR GUÐMUNDSSON ARKITEKT FAI

Jóhanna Guðrún Guðjónsdóttir

Félagshemili á
Efri Hörduvöllum

sneidingar og útlit

VERK

SAMP.

MÁL 1:100 NR. A - 3

DAGS 29.10.'93

BR TEIKN bj.snæ.

04.03.94