




9999-9370  
"REYKHOLT"

LJÓSATRÖÐ 4  
5760-0040

Landm. 123208

Fastarr.

208-1208

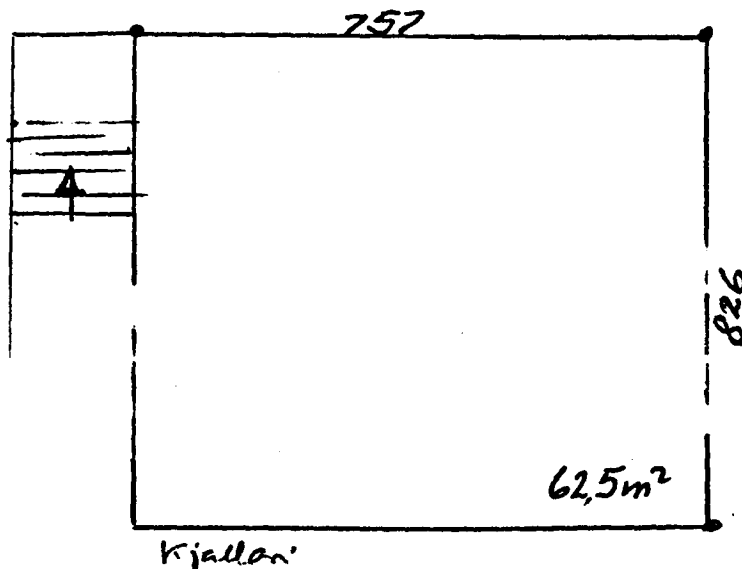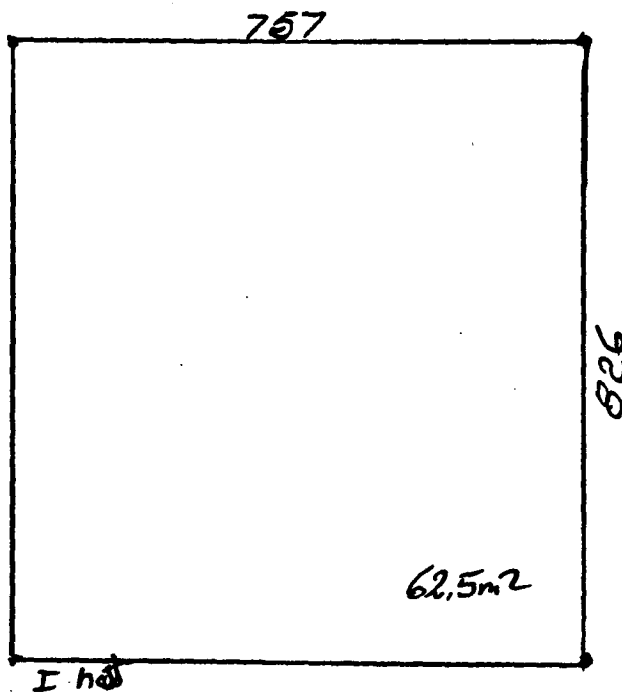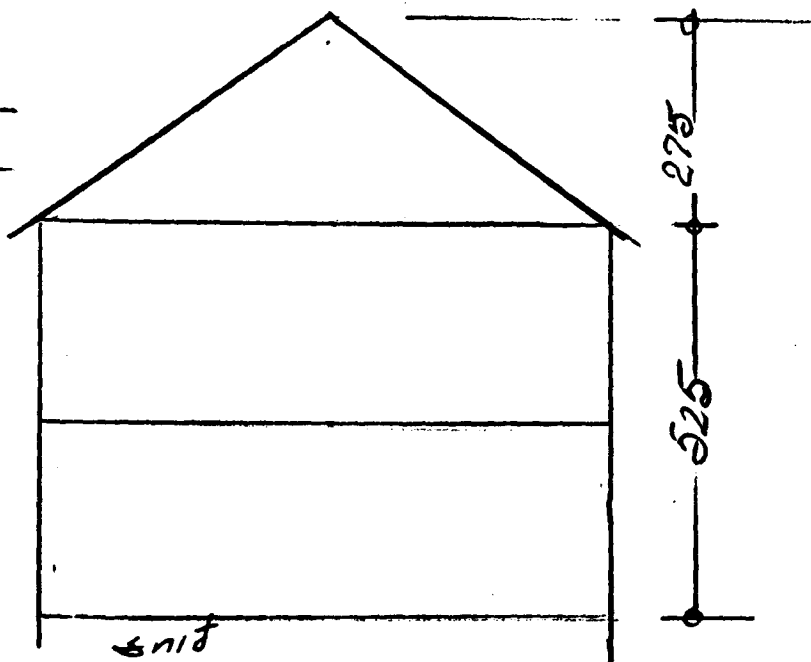


jömvand timburhús  
e' steyplum kjallan.

Rúmmal 328 m<sup>3</sup>

metallhúð 6,6m

metallummal 31,6m

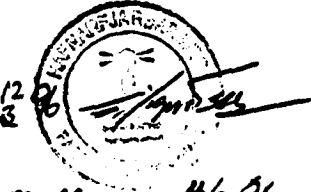12 28  
18  
  
malt upp. 4/3 96  
SH / SN.