


MARK	LENGTH	THK	DEPTH
6ZP141	8228	1.9 mm	216 mm
6ZP91	8228	3.0 mm	216 mm
6ZP89	8228	3.0 mm	216 mm
ZP120	7401	1.9 mm	216 mm
ZP121	8228	3.0 mm	216 mm
ZP162	6982	3.0 mm	216 mm
ZP167	7161	1.9 mm	216 mm
ZP168	7580	1.9 mm	216 mm
ZP185	8228	2.3 mm	216 mm
ZP189	8228	1.9 mm	216 mm
ZP94	7401	3.0 mm	216 mm
ZP96	7580	3.0 mm	216 mm

All Dimensions are millimeters [mm.] -Unless Noted

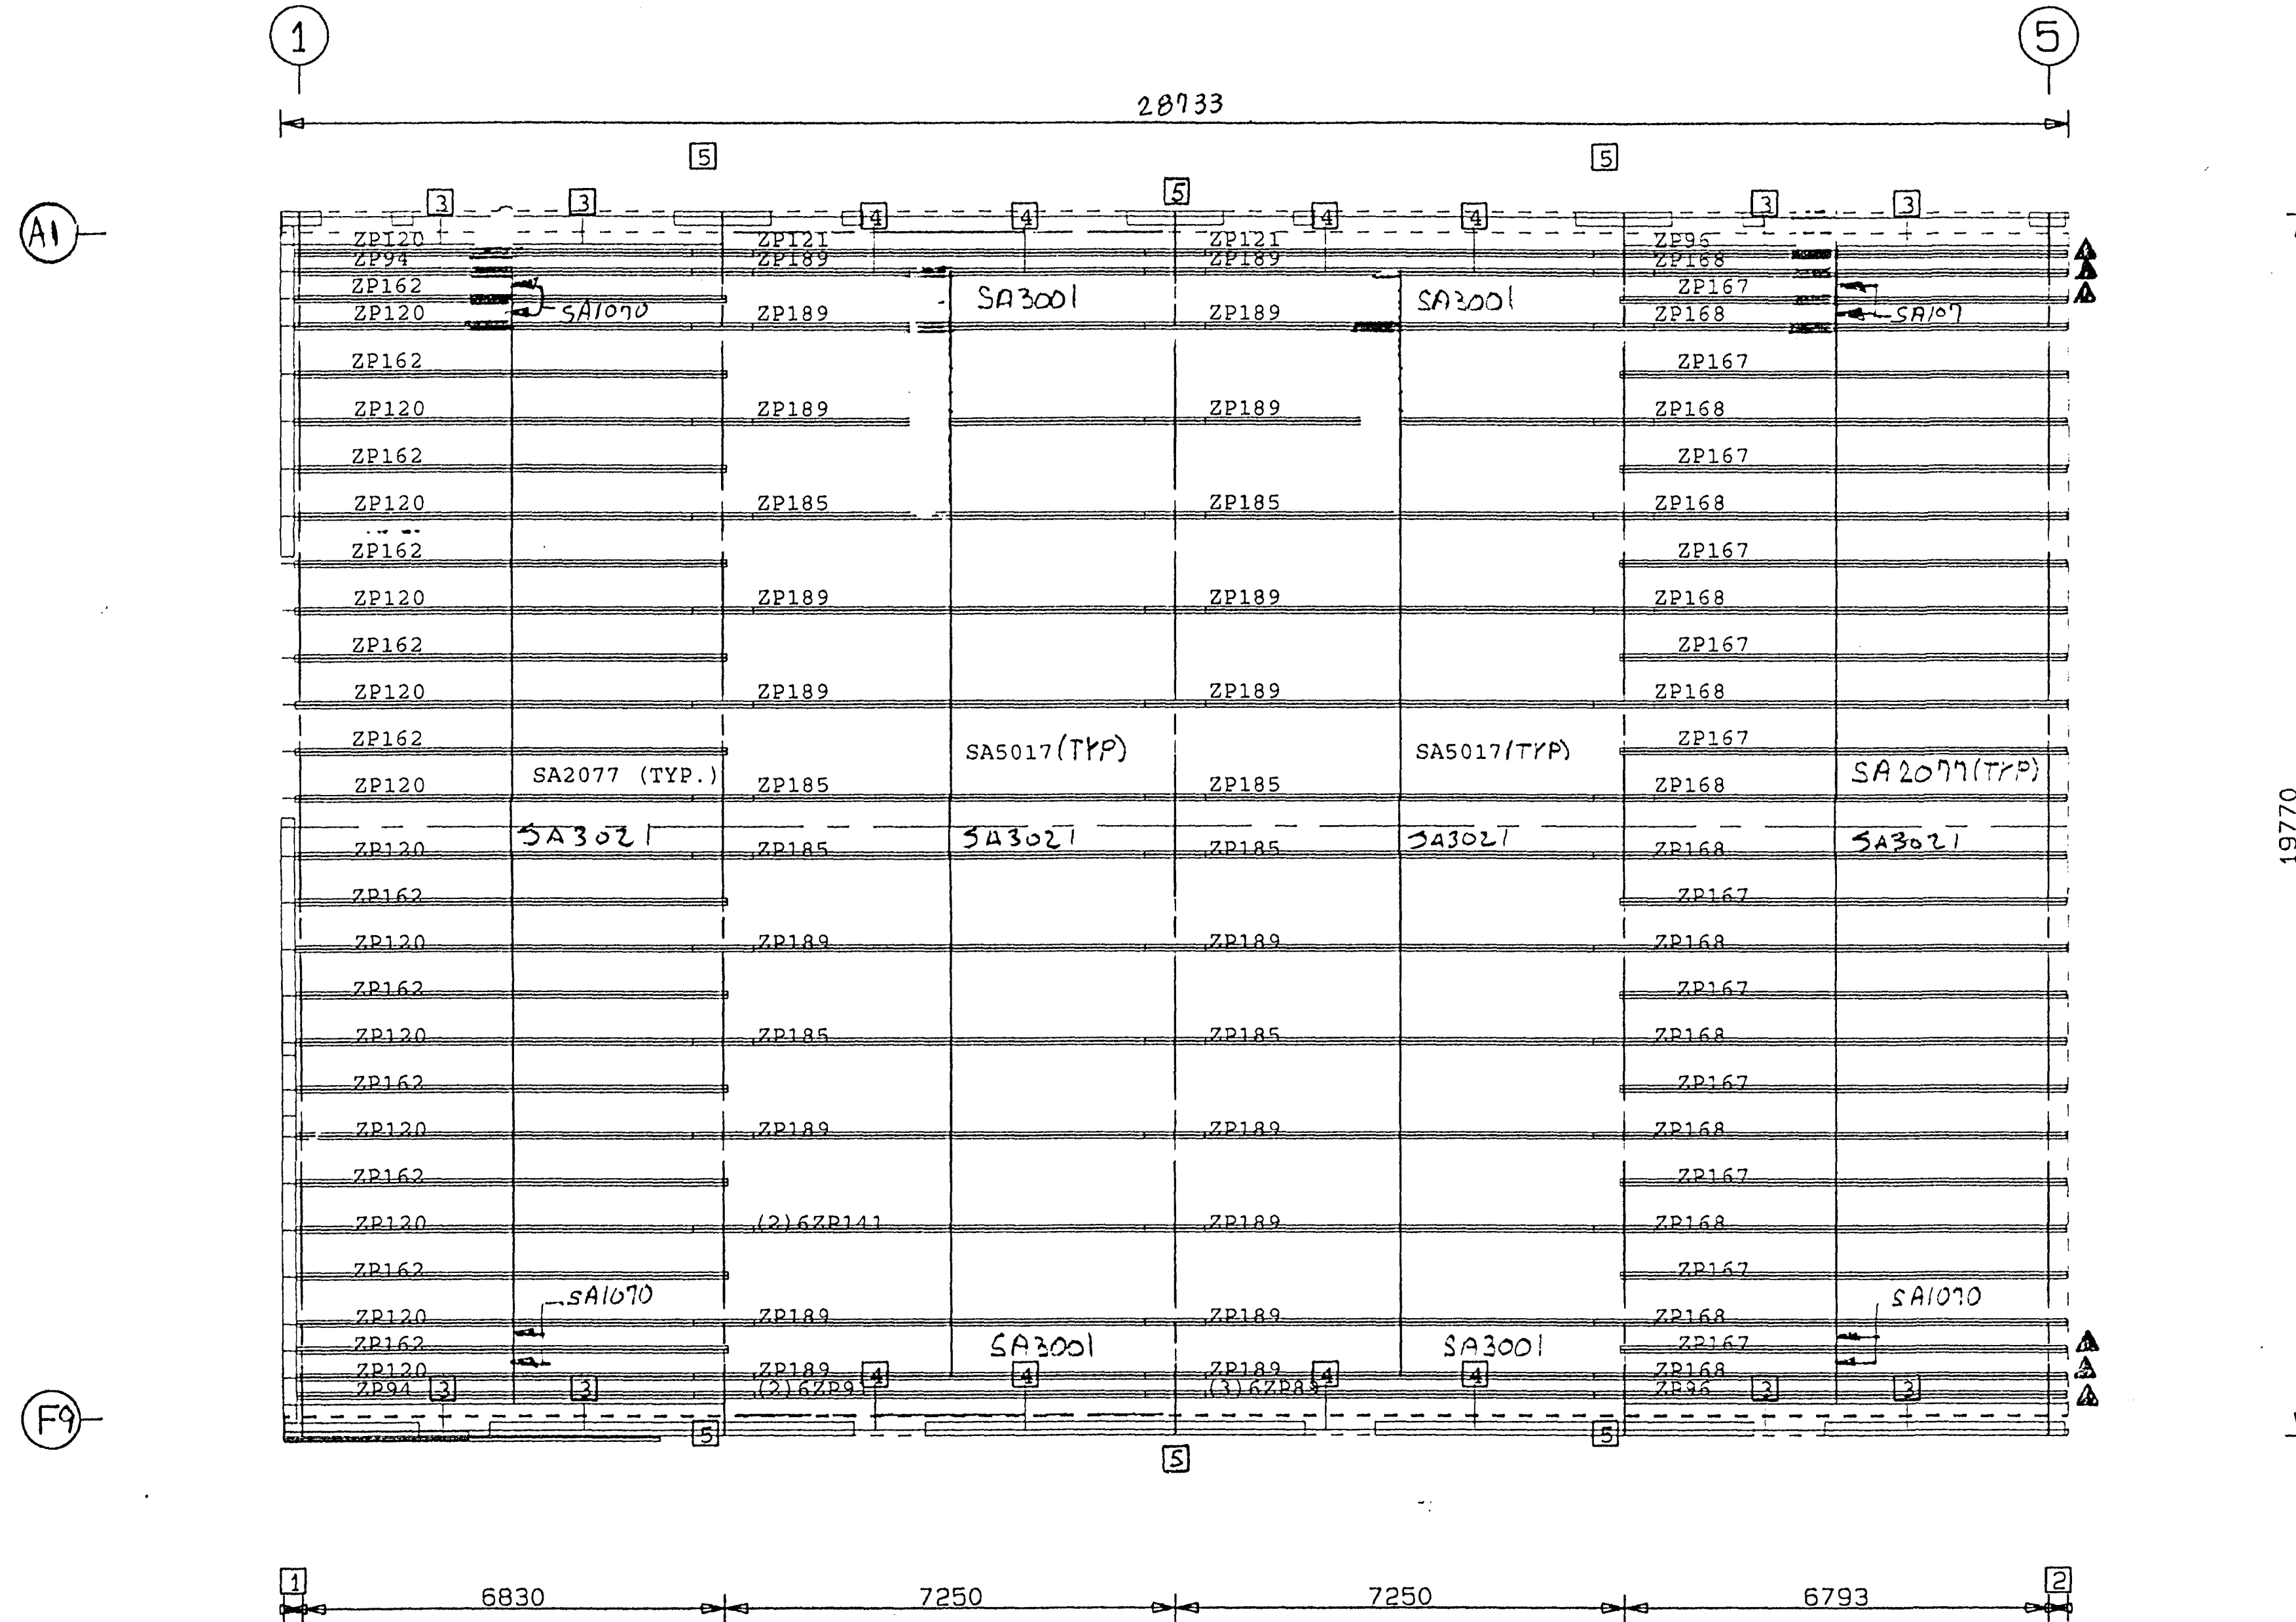

▲ SSR FIXED CLIPS

- 5 JCP052050
- 4 PSM02090
- 3 PSM01037
- 2 314
- 1 305

On: filesrv Projky: 38890 Bldg: 1 Plane: 6.7

This Drawing is Sealed only as to the Components furnished by VP Buildings

- UNLESS NOTED, USE 1/2" DIAMETER A-307 BOLTS FOR PURLIN LAP, PURLIN TO FRAME, FLANGE BRACE TO FRAME, AND FLANGE BRACE TO PURLIN CONNECTIONS. SEE JOB DETAILS FOR BOLT LENGTHS.
- WIND, FLANGE, AND PURLIN BRACING ARE AN INTEGRAL PART OF THE ROOF STRUCTURAL SYSTEM AND SHOULD BE PROPERLY INSTALLED PRIOR TO ERECTION OF WALL AND ROOF SHEETS. REMOVAL OR ALTERATION OF ROOF BRACING WITHOUT PRIOR AUTHORIZATION IS PROHIBITED.
- WHEN SAG ANGLE SLOTS IN ADJACENT PURLINS DO NOT ALIGN OR ARE OMITTED, FIELD-BEND A SAG ANGLE TAB AND ATTACH TO PURLIN WITH A SELF-DRILLING STRUCTURAL FASTENER.
- SAG ANGLES ARE NOT REQUIRED IN BAYS THAT ARE 16' OR LESS.

Building Code:	86MBMA	This Drawing, including the information hereon, remains the property of VP Buildings. It is provided for Erecting the Building described in the applicable Purchase Order and shall not be modified, reproduced or used for any other purpose without prior Written Approval of VP Buildings. The General Contractor and/or Erector is solely responsible for accurate, good Quality Workmanship in erecting this Building in conformance with this Drawing, Details referenced in this Drawing, all applicable VP Buildings Erection Details and all Industry Standards pertaining to proper erection, including the correct use of temporary bracing.
Live Ld (W/Trib Red)	102.5 kgsm	
Coll. Ld (gravity):	24.4 kgsm	
Coll. Ld (uplift):	0.0 kgsm	
Wind Speed:	170.6 kmph	
Wind Exp. Cat.:	C	
Ground Snow:	146.5 kgsm	
Roof Snow:	102.5 kgsm	
Snow Exp. Cat.:	3	
Seismic Zone:	3	
Building Use Cat.:	1	
Auxiliary Loads	NONE	

REV	DATE	BY	DESC.	BUILCER
				Varco-Pruden Exports
				Sindri
				Iceland,
				Sindri Workshop
				workshop 1

QUOTE #	ME99012531-001	ME99	JOB #	70314-01-0E
			DATE	08/16/99
			TIME	00:19
			DRAW/CHECK	DHG
			PAGE	13

Verkfærðistofa Norðurlands ehf.
Höfðabót 4 600 Akureyri. kt. 560175-0869

Byggingafræðingur Eiríkur Jónsson byggingaverkf.
kt. 051045-4679

2 U MANS COO
Sigurbjartur Halldórsson

VERKFRÆÐISTOFA NORÐURLANDS ehf.