



FO#	MARK	LENGTH	TRIM COLOR (FINISH)
BWA0207	6096	Match Color (PRIMER)	
BWT110	3124	Match Color (GALVM)	
RCPOL	0	Patrician Bronze (KXL)	
RCPOR	0	Patrician Bronze (KXL)	
RFR10	3048	Patrician Bronze (KXL)	
RHF010	3124	Match Color (GALVM)	
SMGB1	0	Match Color (GALV)	
SMGCL	0	Match Color (GALV)	
SMGCR	0	Match Color (GALV)	

All Dimensions are millimeters [mm.] -Unless Noted

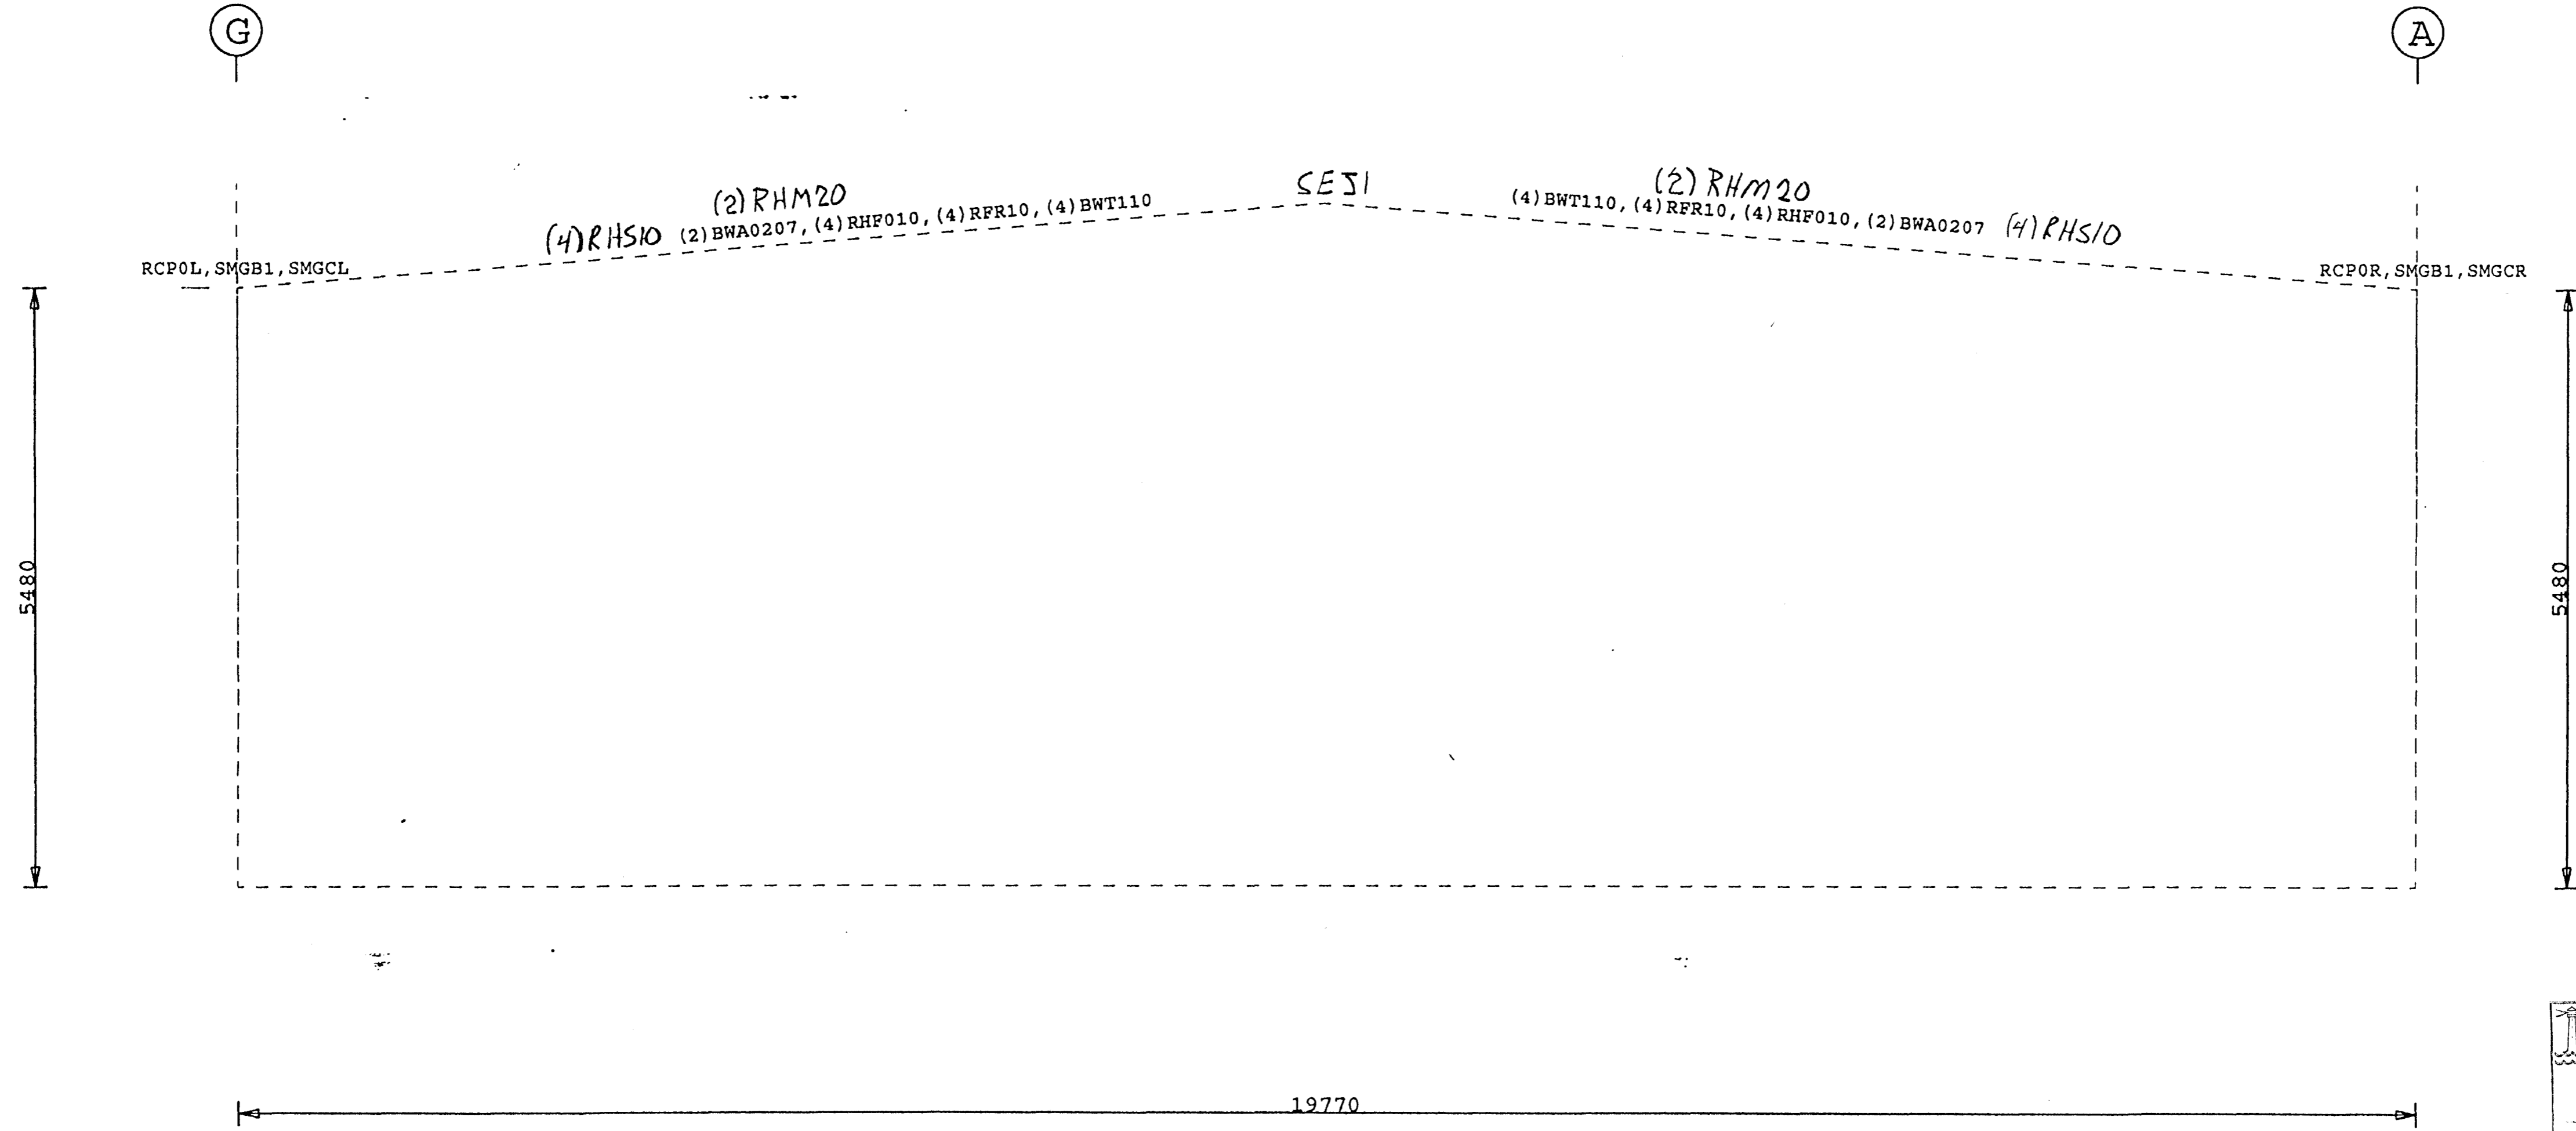

WALL ELEVATION AT WR

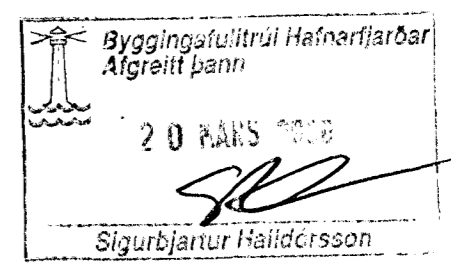

Verkfæðistofa Norðurlands ehf.  
Höfðót 4 600 Akureyri. kt. 560175-0869  
Eiríkur Jónsson byggingaverkf. kt. 051045-4679

VERKFAEÐISTOFANORÐURLANDS ehf.

1 (2)BLK3

On: filesrv Projky: 38890 Bldg: 1 Plane: 4

This Drawing is Sealed only as to the Components furnished by VP Buildings

1. Install Sheeting From High Point(s) to Low Point(s) 2. WALL SHEETS ARE AN INTEGRAL PART OF THE STRUCTURAL SYSTEM. REMOVAL OR ALTERATION WITHOUT PRIOR AUTHORIZATION IS PROHIBITED. 3. SEE JOB DETAILS FOR SHEETING AND TRIM FASTENER SPECIFICATION. 2. PRE-DRILLING 1/8" DIAMETER HOLES FOR WALL STRUCTURAL FASTENERS MAY BE REQUIRED AT 11 GAGE GIRTS, NESTED GIRTS, GIRT LAP LOCATIONS, AND/OR SECONDARY STRUCTURAL BEAMS	Building Code: 86MBMA Live Ld(W/Trib Red): 102.5 kgsm Coll. Ld (gravity): 24.4 kgsm Coll. Ld (uplift): 0.0 kgsm Wind Speed: 170.6 kmph Wind Exp. Cat.: C Ground Snow: 146.5 kgsm Roof Snow: 102.5 kgsm Snow Exp. Cat.: 3 Seismic Zone: 3 Building Use Cat.: 1 Auxiliary Loads: NONE	This Drawing, including the information hereon, remains the property of VP Buildings.  It is provided for Erecting the Building described in the applicable Purchase Order and shall not be modified, reproduced or used for any other purpose without prior Written Approval of VP Buildings.  The General Contractor and/or Erector is solely responsible for accurate, good Quality Workmanship in erecting this Building in conformance with this Drawing. Details referenced in this Drawing, all applicable VP Buildings Erection Details and all industry standards pertaining to proper erection, including the correct use of temporary bracing.	<b>Wall Sheeting</b>		QUOTE # ME99012531-001 ME9970314-01-OE-	JOB # 70314-01-OE-															
			<table border="1"> <thead> <tr> <th>REV</th> <th>DATE</th> <th>BY</th> <th>DESC.</th> </tr> </thead> <tbody> <tr> <td> </td> <td> </td> <td> </td> <td> </td> </tr> </tbody> </table>	REV	DATE	BY	DESC.					<table border="1"> <tr> <td>BUILDER</td> <td>Varco-Pruden Exports</td> </tr> <tr> <td>CUSTOMER</td> <td>Sindri</td> </tr> <tr> <td>LOCATION</td> <td>Iceland,</td> </tr> <tr> <td>PROJECT</td> <td>Sindri Workshop</td> </tr> <tr> <td>BUILDING</td> <td>workshop 1</td> </tr> </table>	BUILDER	Varco-Pruden Exports	CUSTOMER	Sindri	LOCATION	Iceland,	PROJECT	Sindri Workshop	BUILDING
REV	DATE	BY	DESC.																		
BUILDER	Varco-Pruden Exports																				
CUSTOMER	Sindri																				
LOCATION	Iceland,																				
PROJECT	Sindri Workshop																				
BUILDING	workshop 1																				