


SECTION A-A

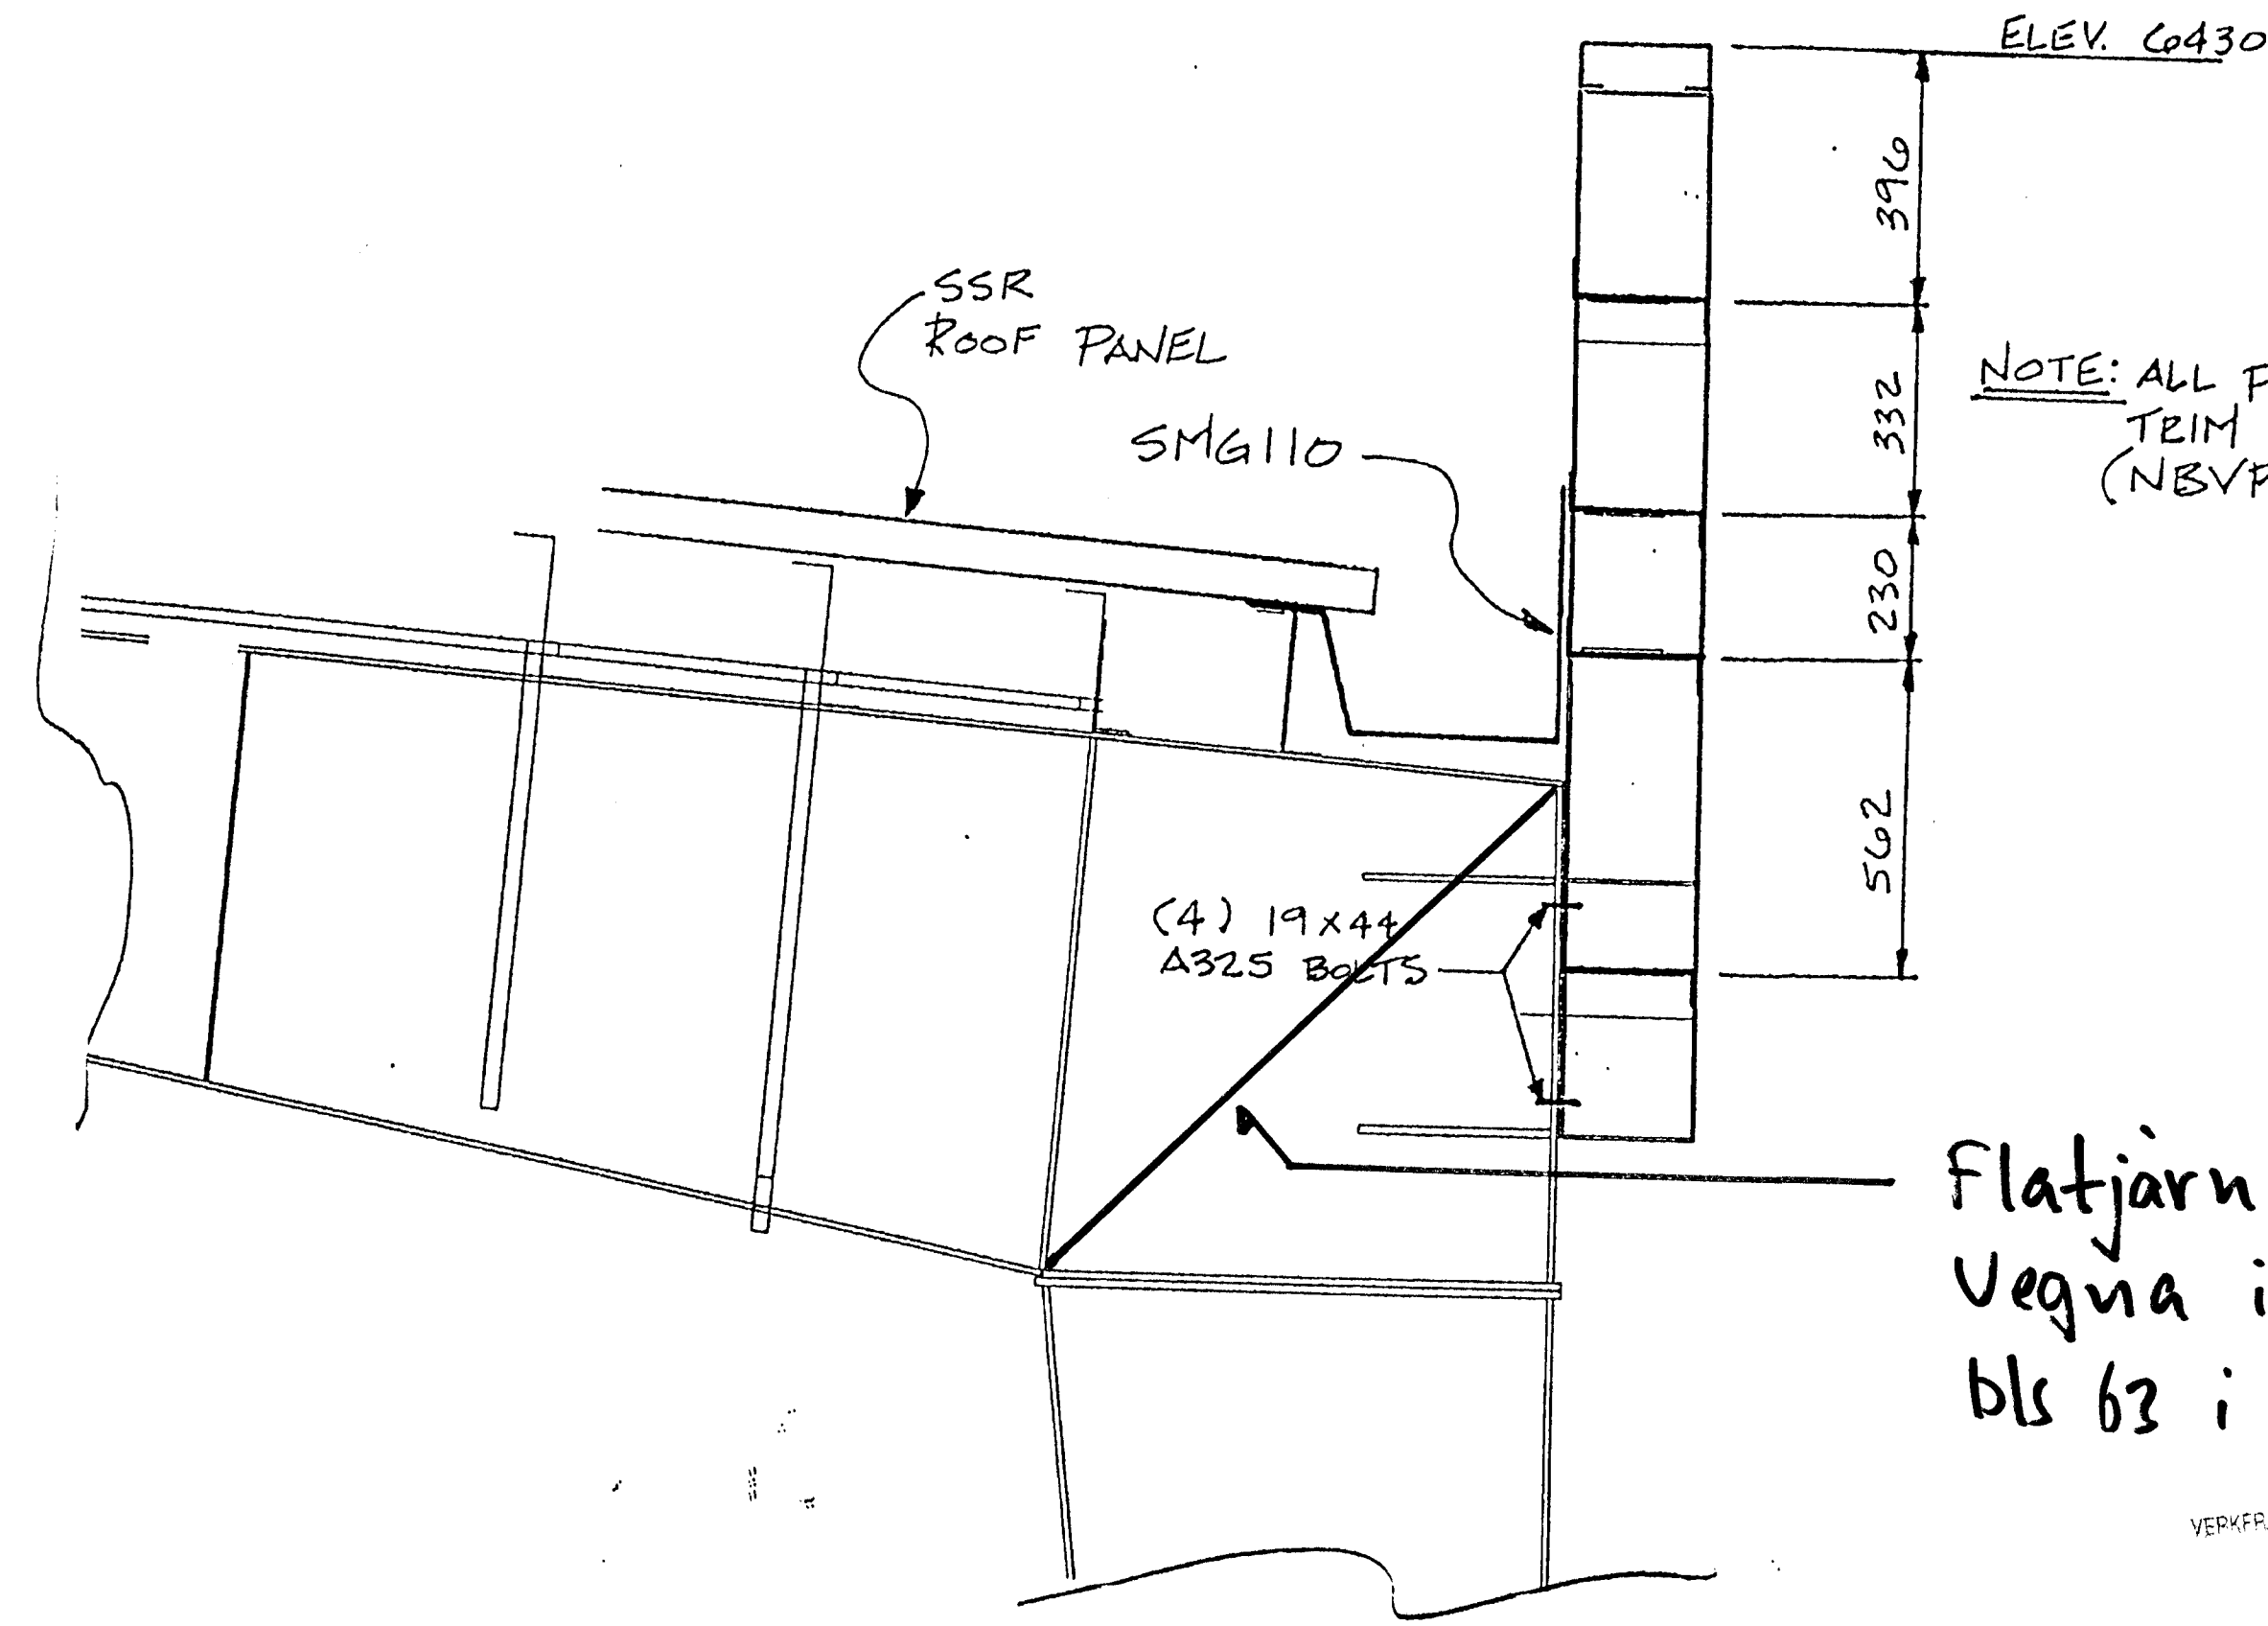


NOTE: ALL PANEL & TRIM @ PARAPET (NEVP)

Flatjárn 8x60 beggja
vegna i horn. sjá
bls 63 i skýrsku V.N.

VERKFRÆÐISTOFA NORDURLANDS ehf.
63.

PARAPET DETAIL

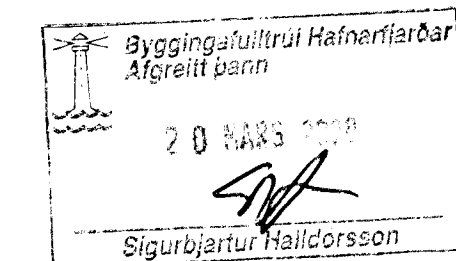

Verkfræðistofa Norðurlands ehf.
Höfðabót 4 600 Akureyri, kt. 560175-0869
Eiríkur Jónsson byggingaverkfr.
kt. 051045-4679

VERKFRÆÐISTOFA NORDURLANDS ehf.

Building Code: 86MBMA Live Ld (w/Trib Red): 102.5 kgsm Coll. Ld (gravity): 24.4 kgsm Coll. Ld (uplift): 0.0 kgsm Wind Speed: 170.6 kmph Wind Exp. Cat.: C Ground Snow: 146.5 kgsm Roof Snow: 102.5 kgsm Snow Exp. Cat.: 3 Seismic Zone: 3 Building Use Cat.: 1 Auxiliary Loads: NONE	THIS DRAWING, INCLUDING THE INFORMATION HEREON, REMAINS THE PROPERTY OF VP BUILDINGS. IT IS PROVIDED SOLELY FOR ERECTING THE BUILDING DESCRIBED IN THE APPLICABLE PURCHASE ORDER AND SHALL NOT BE MODIFIED, REPRODUCED OR USED FOR ANY OTHER PURPOSE WITHOUT PRIOR WRITTEN APPROVAL OF VP BUILDINGS. THE GENERAL CONTRACTOR AND/OR ERECTOR IS SOLELY RESPONSIBLE FOR ACCURATE, GOOD QUALITY WORKMANSHIP IN ERECTING THIS BUILDING IN CONFORMANCE WITH THIS DRAWING, DETAILS REFERENCED IN THIS DRAWING, ALL APPLICABLE VP BUILDINGS ERECTION GUIDES, AND INDUSTRY STANDARDS PERTAINING TO PROPER ERECTION, INCLUDING THE CORRECT USE OF TEMPORARY BRACING.	ME99012531-001	JOB NO. --1
		BUILDER: Varco-Pruden Exports CUSTOMER: Sindri LOCATION: Iceland. PROJECT NAME: Sindri Workshop BLDG. NAME: workshop 2	