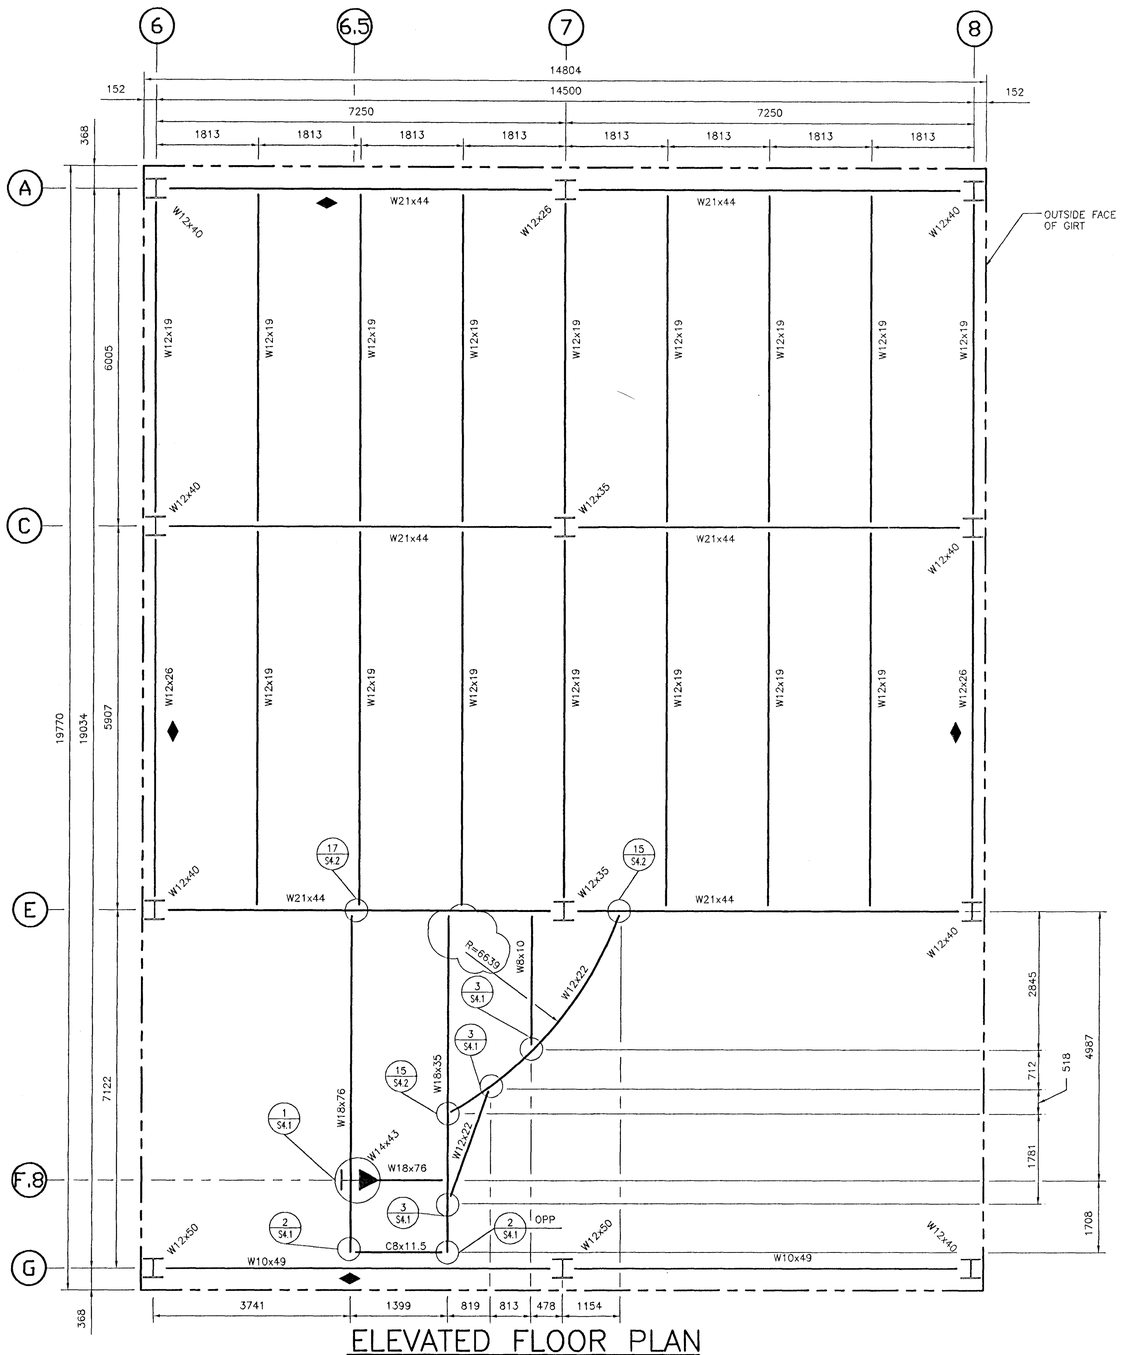

ELEVATED FLOOR PLAN

T.O.S. ELEVATION 13,084

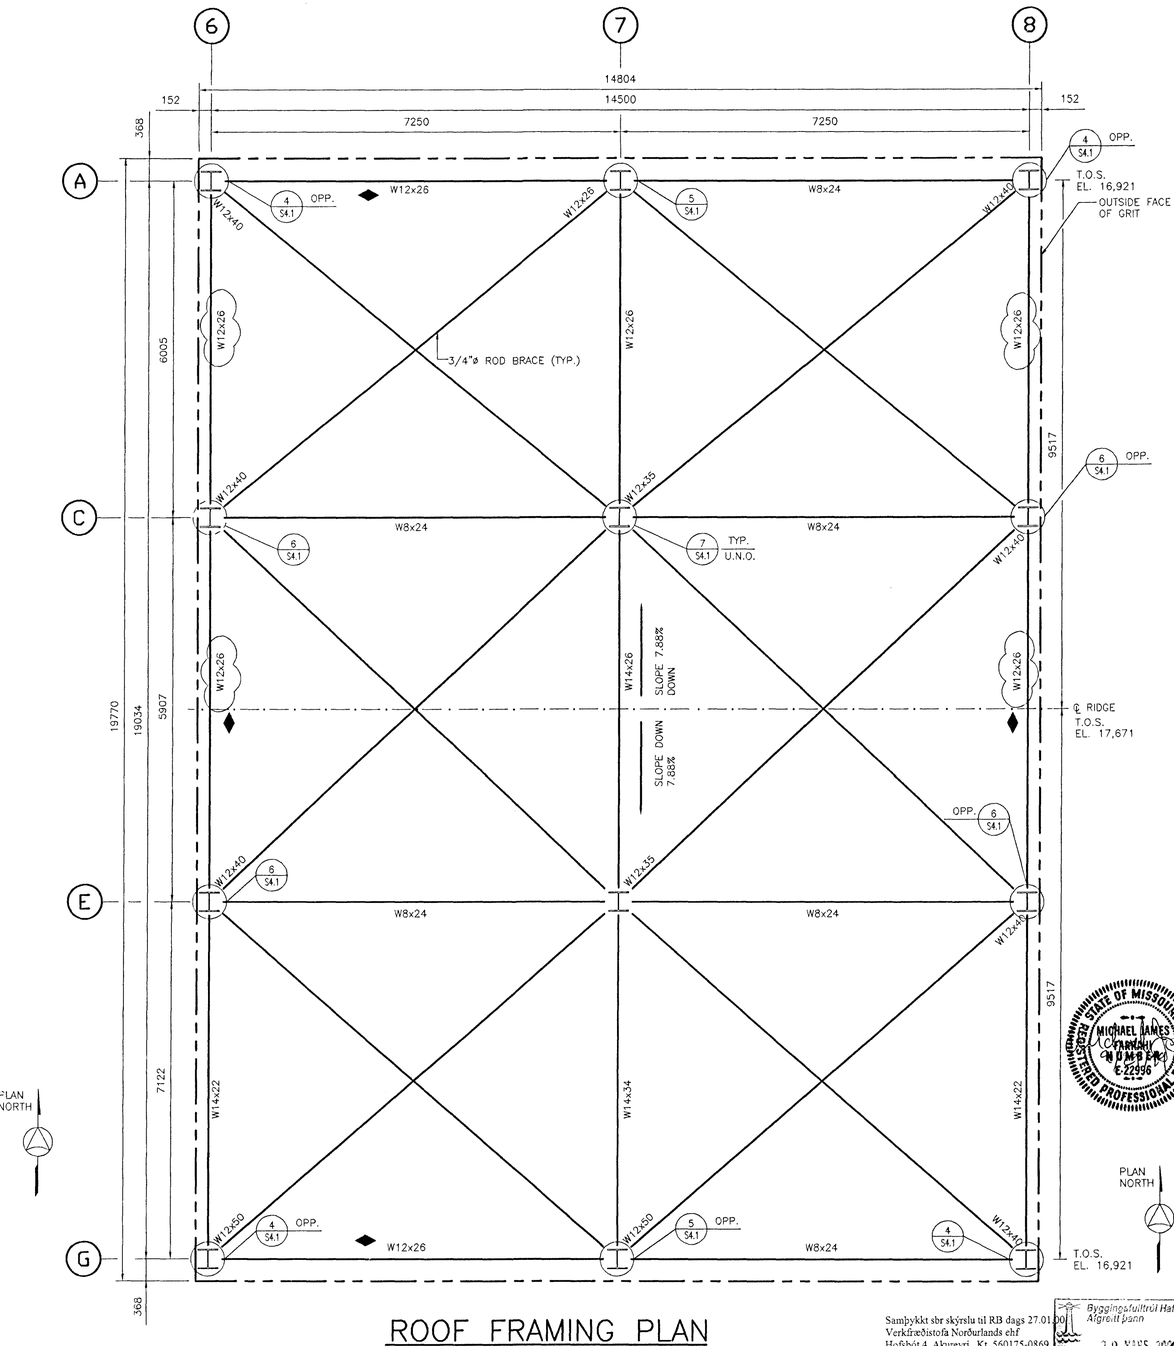

ROOF FRAMING PLAN

Samþykkt sbr skýrslu til RB dags 27.01.00
Verkfræðistofa Norðurlands ehf
Hofsbót 4, Akureyri. Kt. 560175-0869

Eirikur Jónsson byggingaverkfr.
Kt 051045-4679

Byggingafulltrúi Hafnarfjarðar
Afgreitt þann
20 MARS 2000
Sigurgeir Halldórsson

NOTES:

1. SEE SHEET S0.1 FOR GENERAL STRUCTURAL NOTES.
2. REFER TO SHEET S4.1 FOR ALL SIMPLE SHEAR CLIP ANGLE CONNECTIONS, U.N.O.
3. ◆ DENOTES LOCATIONS OF VERTICAL BRACING
4. FOR FLOOR SLAB PLAN, REFER TO SHEET S5.1.

Constructive Engineering Design Inc.
Consulting Structural Engineers
222 W. Gregory Blvd., Suite 340
Kansas City, Missouri 64114-1127

Building Code:	86MBMA
Live Ld(W/O Trib Red)	205 kgsm
Coll. Ld (gravity):	24.4 kgsm
Coll. Ld (uplift):	0.0 kgsm
Wind Speed:	193 kmph
Wind Exp. Cat.:	C
Ground Snow:	178.6 kgsm
Roof Snow:	100.0 kgsm
Snow Exp. Cat.:	3
Seismic Zone:	3
Building Use Cat.:	4
Auxiliary Loads	NONE

This Drawing, including the information hereon, remains the property of VP Buildings.

It is provided for Erecting the Building described in the applicable Purchase Order and shall not be modified, reproduced or used for any other purpose without prior Written Approval of VP Buildings.

The General Contractor and/or Erector is solely responsible for accurate, good Quality Workmanship in erecting this Building in conformance with this Drawing. Details referenced in this Drawing, all applicable VP Buildings Erection Details and all Industry Standards pertaining to proper erection, including the correct use of temporary bracing.

ELEVATED FLOOR AND ROOF FRAMING PLANS

REV	DATE	BY	DESC.
1	9/1	ME	CLOUDED

SCALE: NTS

BUILDER: International Client
CUSTOMER: Sindri
LOCATION: Reykjavik, Iceland
PROJECT: Sindri Workshop
BUILDING: Office

QUOTE #

VP BUILDINGS
VARCO-PRUDEN

JOB # P9924127
DATE 07/20/99
TIME XX:XX
DRAW/CHECK CW/ME
PAGE S2.1