
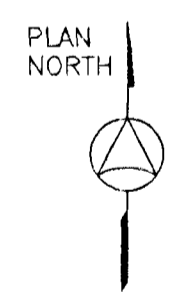


**ELEVATED FLOOR SLAB PLAN**  
SCALE 1:50

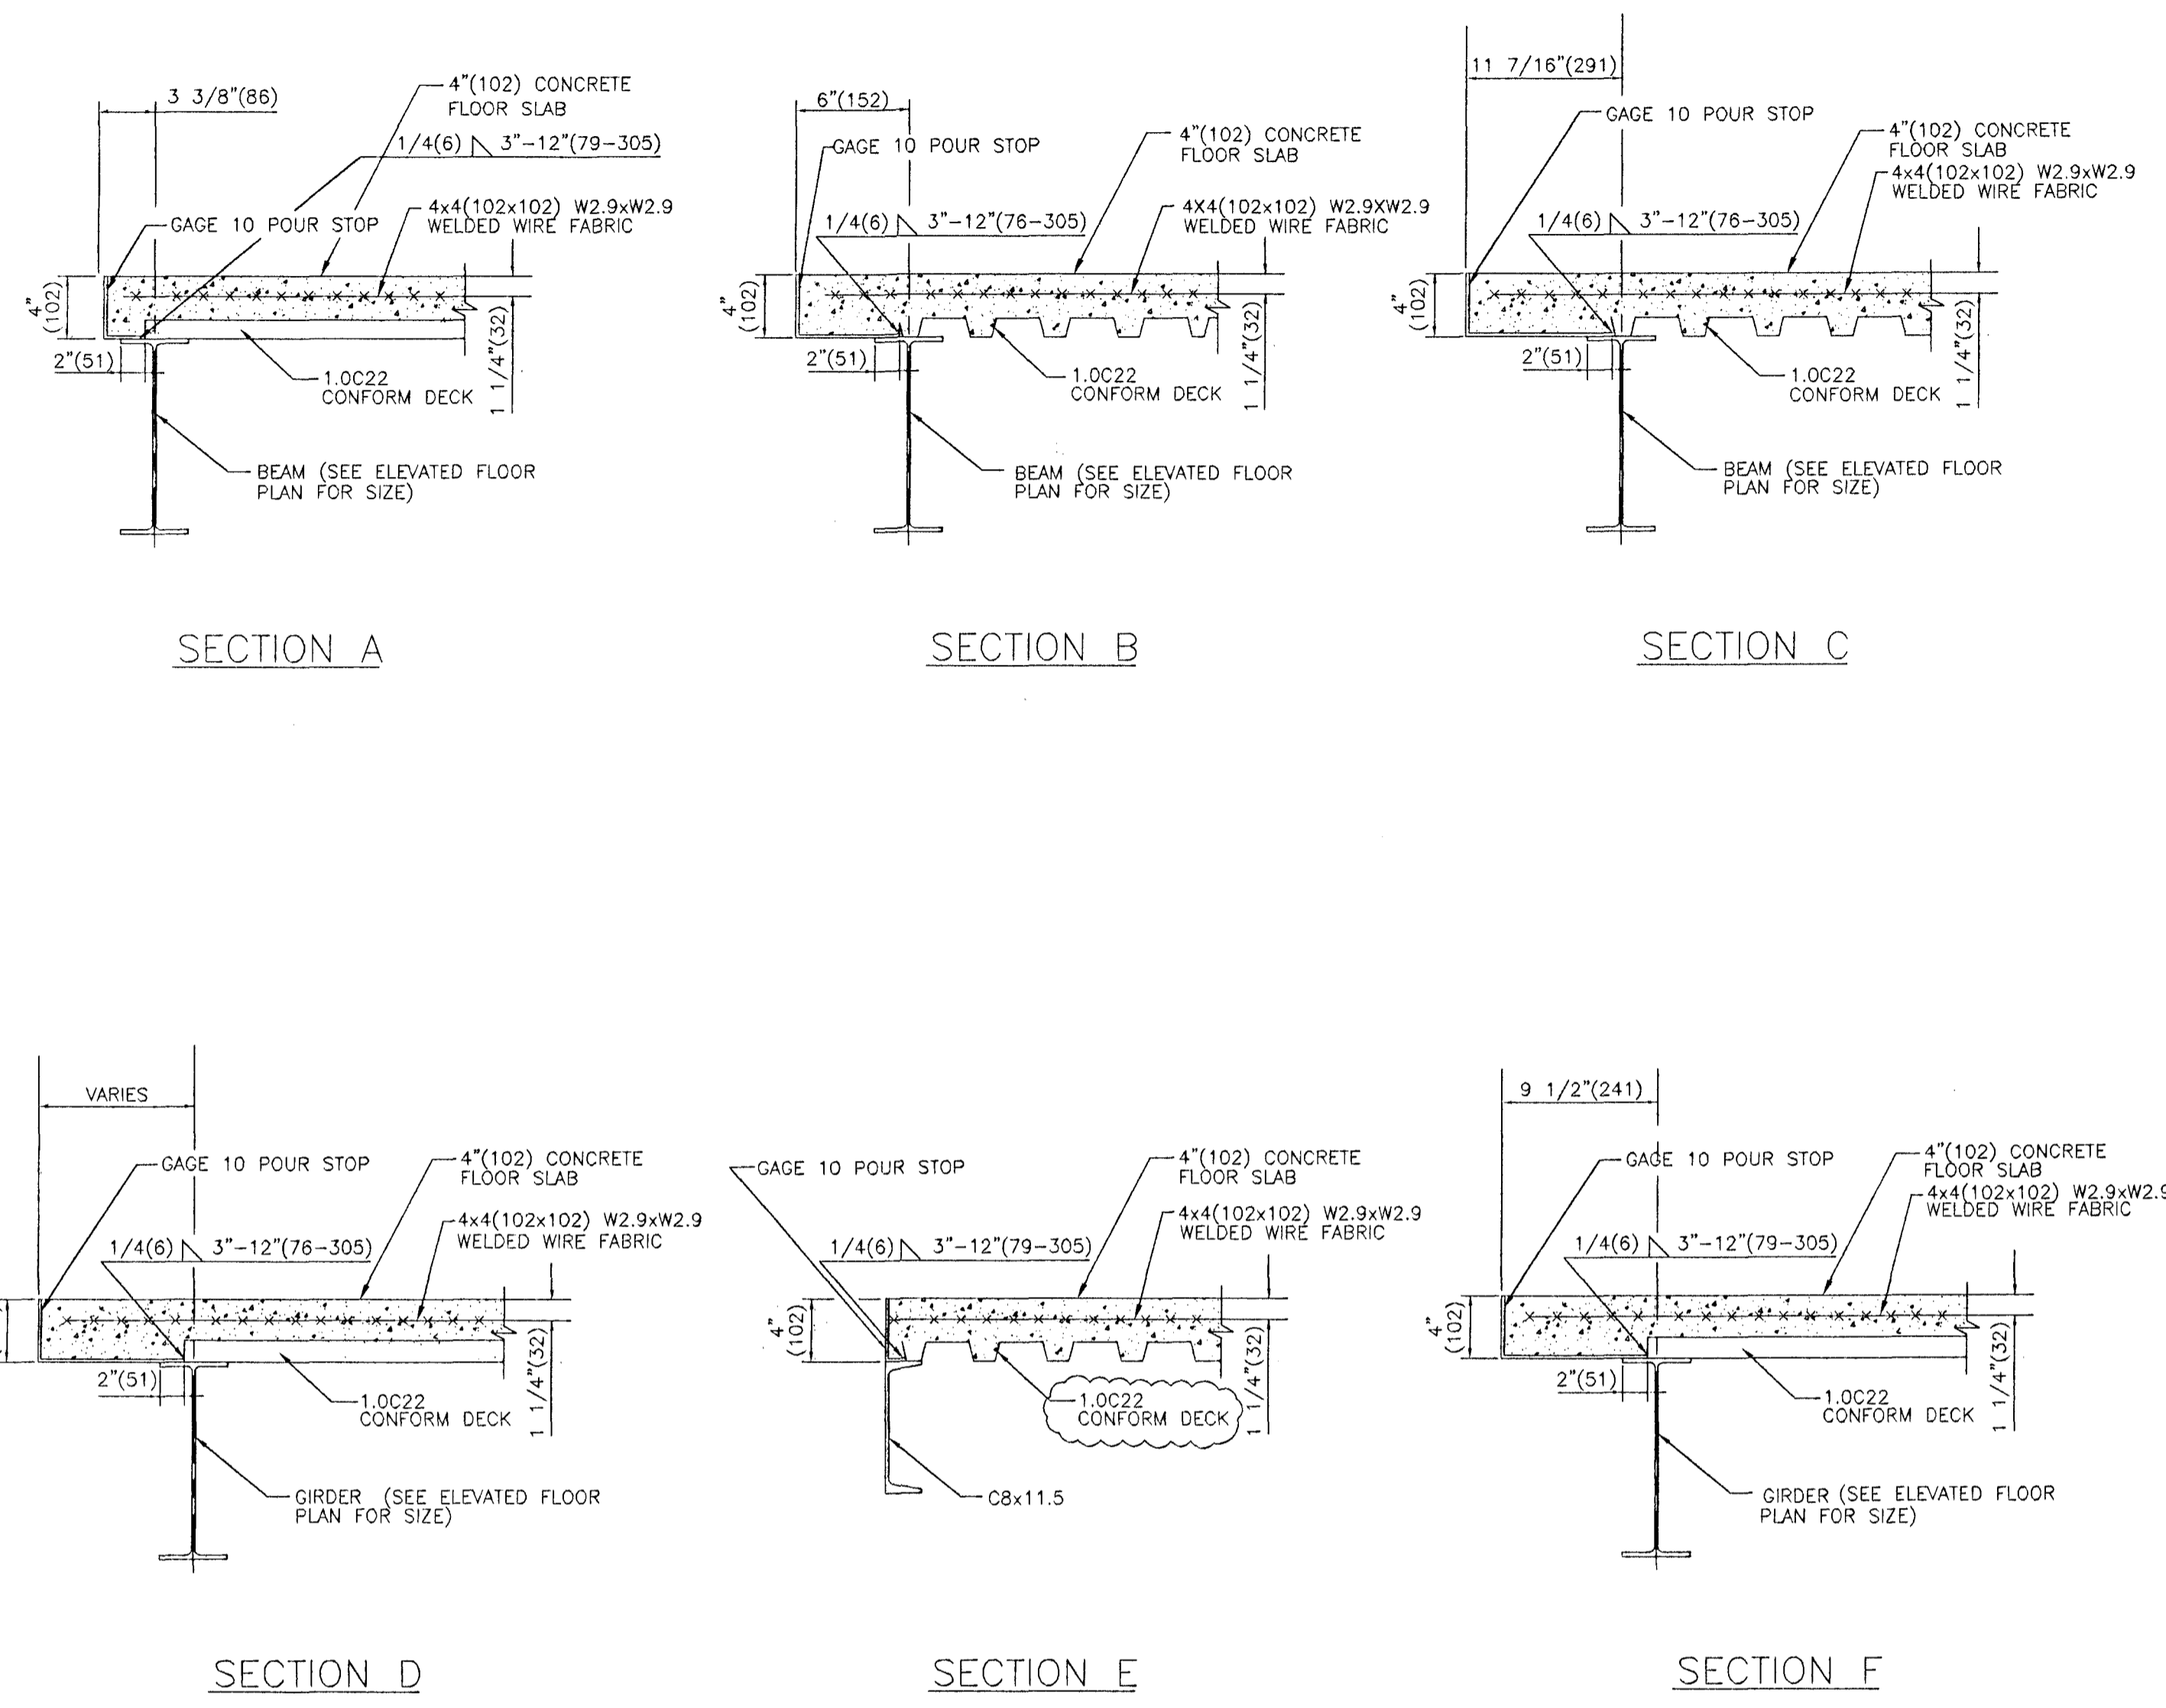

Samplykkur sér skýrslu til kús dags 21.04.00  
 Verkfræðistofa Norðurlands ehf.  
 Hofsbót 4, Akureyri. Kt. 560175-0866  
 Eiríkur Jónsson byggingaverkfr.  
 Kt 051045-4679

- NOTES:**
- SEE SHEET S0.1 FOR GENERAL STRUCTURAL NOTES.
  - DIMENSIONS IN PARENTHESIS ARE THE EQUIVALENT IN mm.

**Constructive Engineering Design Inc.**  
 Consulting Structural Engineers  
 222 W. Gregory Blvd., Suite 340  
 Kansas City, Missouri 64114-1127

Building Code: 86MBMA  
 Live Ld(W/D Trib Red) 205 kgsm  
 Coll. Ld (gravity): 24.4 kgsm  
 Coll. Ld (uplift): 0.0 kgsm  
 Wind Speed: 193 kmph  
 Wind Exp. Cat.: C  
 Ground Snow: 178.6 kgsm  
 Roof Snow: 100.0 kgsm  
 Snow Exp. Cat.: 3  
 Seismic Zone: 3  
 Building Use Cat.: 4  
 Auxiliary Loads: NONE

This Drawing, including the information hereon, remains the property of VP Buildings.  
 It is provided for Erecting the Building described in the applicable Purchase Order and shall not be modified, reproduced or used for any other purpose without prior Written Approval of VP Buildings.  
 The General Contractor and/or Erector is solely responsible for accurate, good quality workmanship in erecting this Building in conformance with this Drawing. Details referenced in this Drawing, all applicable VP Buildings Erection Details and all industry standards pertaining to proper erection, including the correct use of temporary bracing.

ELEVATED SLAB PLAN AND DETAILS			
REV	DATE	BY	DESC.
1	9/1	ME	CLOUDED
SCALE:		NTS	
BUILDER	International Client		
CUSTOMER	Sindri		
LOCATION	Reykjavik, Iceland		
PROJECT	Sindri Workshop		
BUILDING	Office		

QUOTE #	JOB #
	P9924127
DATE	07/20/99
TIME	XX:XX
DRAW/CHECK	CW/ME
PAGE	S5.1