


----- SECONDARY -----			
MARK	LENGTH	THK	DEPTH
BWA0207	6096	1.5 mm	
ZG0	6373	1.5 mm	216 mm
ZG1	929	1.5 mm	216 mm
ZG11	7508	1.5 mm	216 mm
ZG12	4754	1.5 mm	216 mm
ZG2	7490	1.5 mm	216 mm
ZG4	5907	1.5 mm	216 mm
ZG7	6268	1.5 mm	216 mm
ZG9	7385	1.5 mm	216 mm

All Dimensions are millimeters [mm.] -Unless Noted

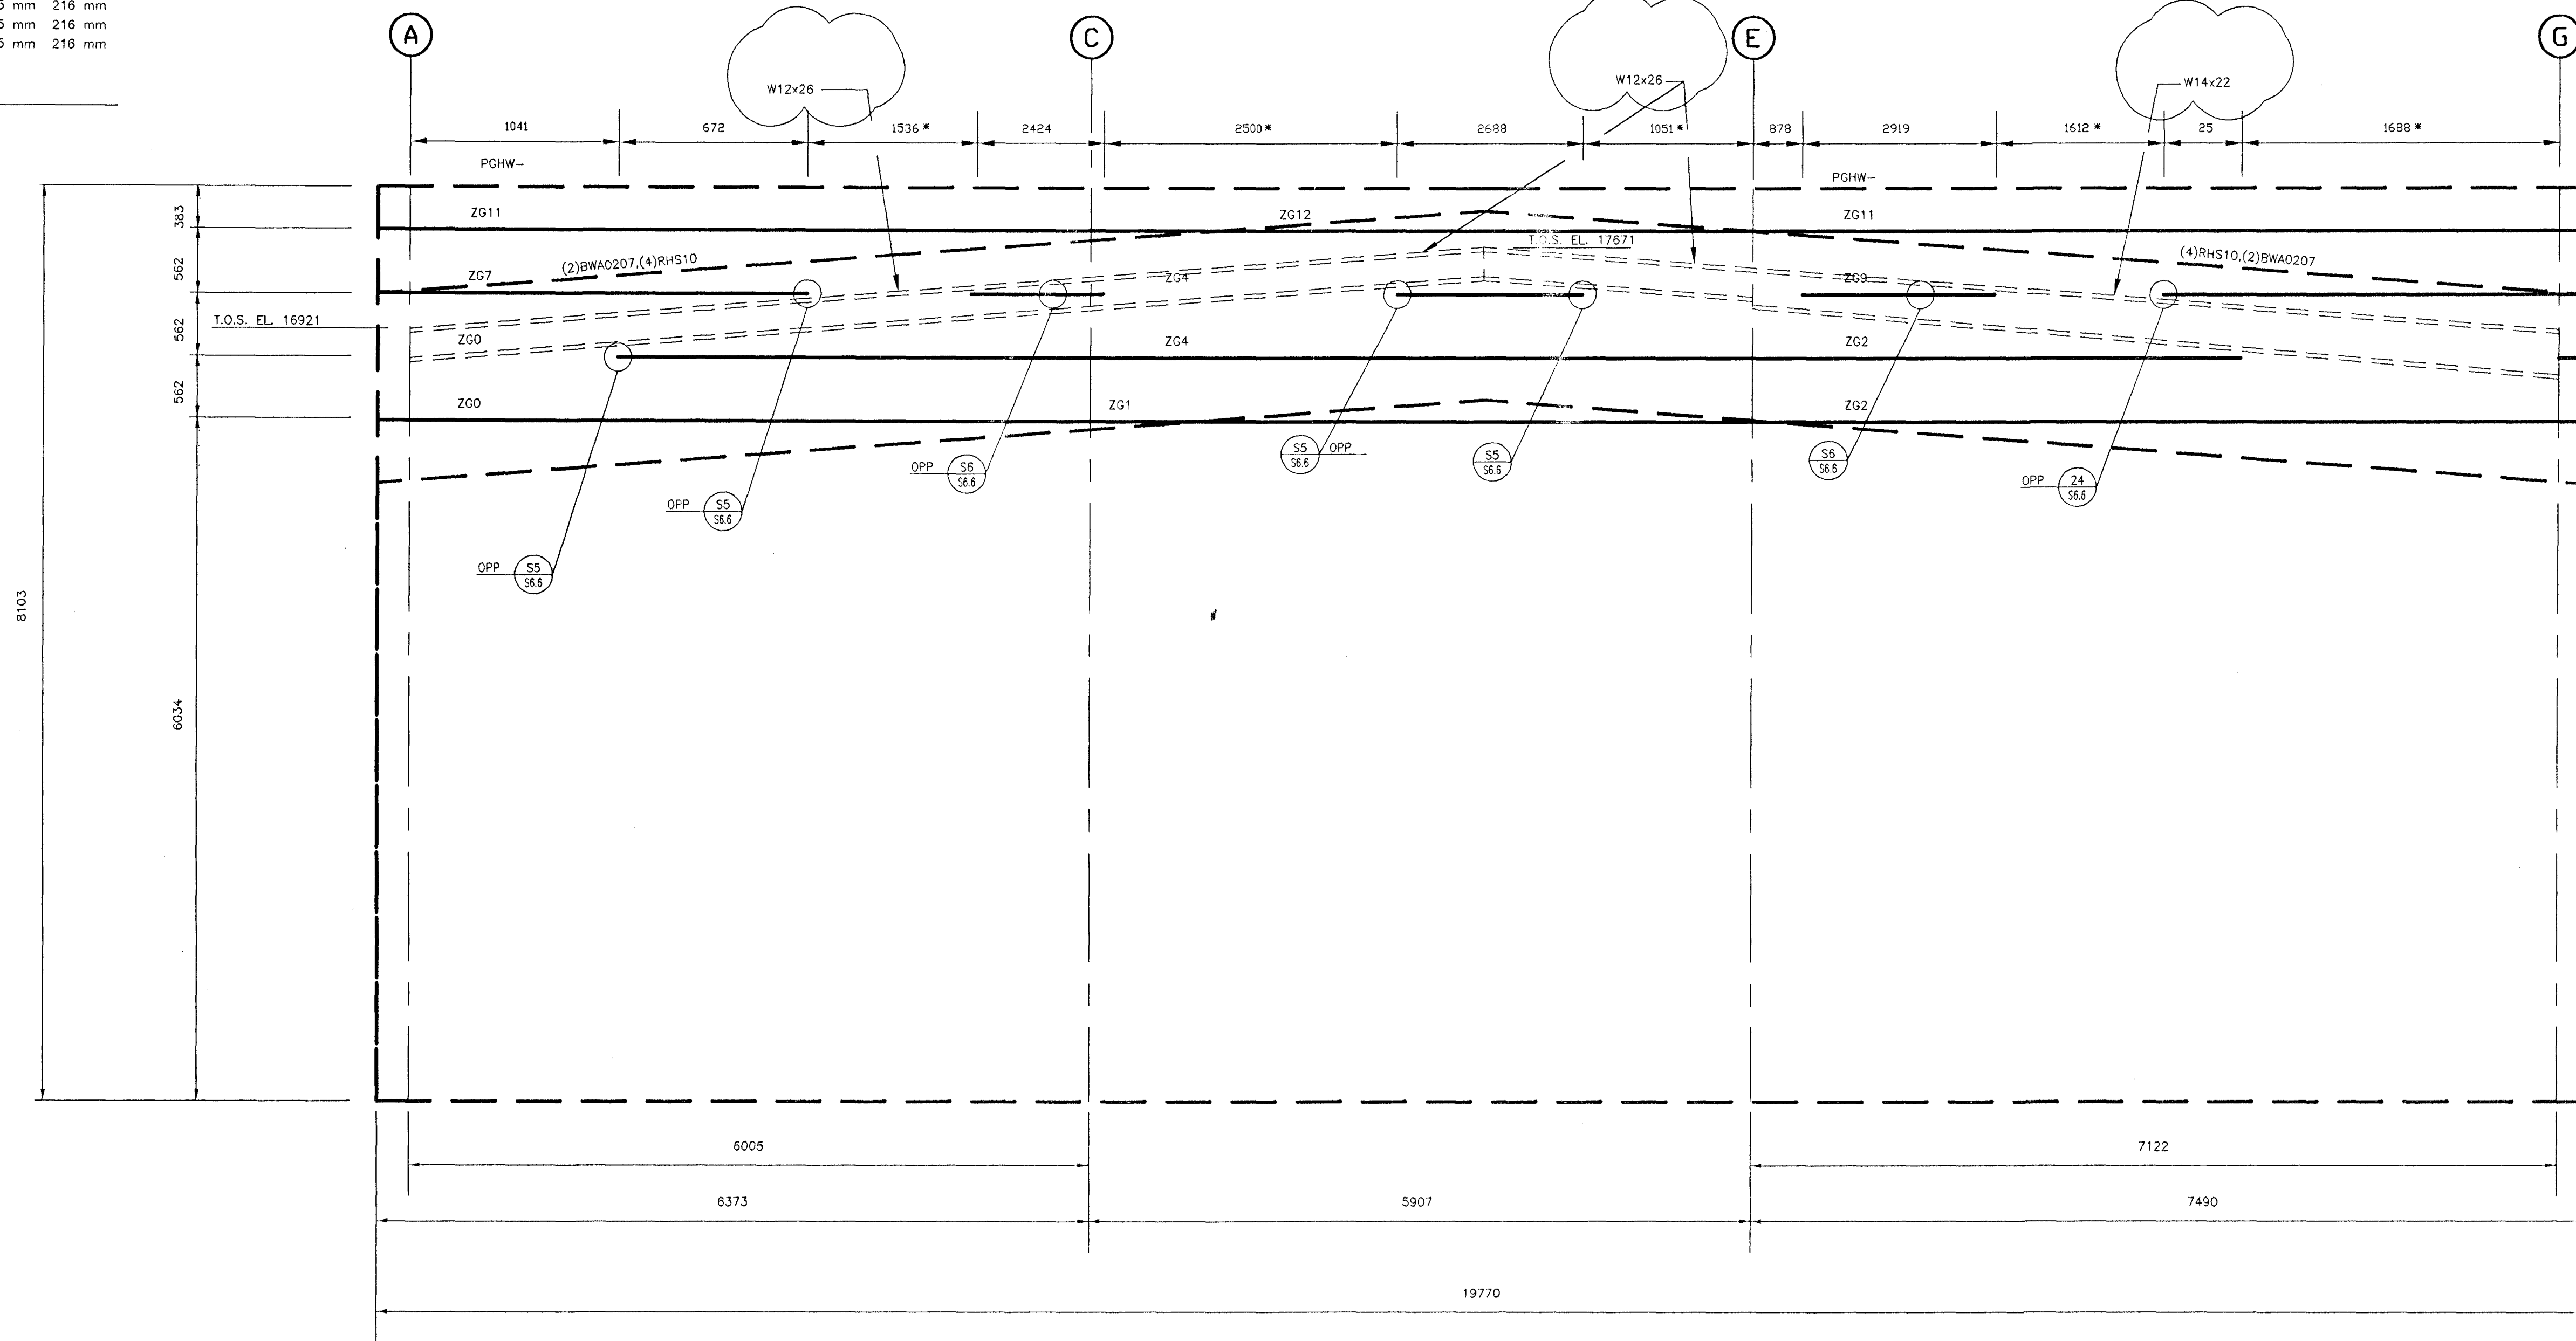

WEST WALL ELEVATION

SEE DETAIL S3 FOR GIRT CONNECTION TO COLUMNS
 SEE DETAIL S4 FOR GIRT CONNECTION TO CORNERS
 SEE DETAIL S8 FOR PARAPET DETAIL
 * SEE DETAIL S7 FOR FILL ANGLE TO BE FIELD LOCATED

This Drawing is Sealed only as to the Components furnished by VP Buildings

GFA004
 JCP052035

On: nasrv Projky: 4687 Bldg: 6 Plane: 2

- UNLESS NOTED, USE 1/2" DIAMETER A-307 BOLTS FOR GIRT LAP, GIRT TO FRAME, FLANGE BRACE TO FRAME, FLANGE BRACE TO GIRT, JAMB AND HEADER CONNECTIONS. SEE JOB DETAILS FOR BOLT LENGTHS.
- WIND AND FLANGE BRACING ARE AN INTEGRAL PART OF THE WALL STRUCTURAL SYSTEM AND SHOULD BE PROPERLY INSTALLED PRIOR TO ERECTION OF WALL AND ROOF SHEETS. REMOVAL OR ALTERATION OF WALL BRACING WITHOUT PRIOR AUTHORIZATION IS PROHIBITED.

Building Code: 86MBMA
 Live Ld(W/Trip Red) 205 kgsm
 Coll. Ld (gravity): 24.4 kgsm
 Coll. Ld (uplift): 0.0 kgsm
 Wind Speed: 193 kmph
 Wind Exp. Cat.: C
 Ground Snow: 178.6 kgsm
 Roof Snow: 102.5 kgsm
 Snow Exp. Cat.: 3
 Seismic Zone: 3
 Building Use Cat.: 4
 Auxiliary Loads: NONE


This Drawing, including the information hereon, remains the property of VP Buildings.
 It is provided for Erecting the Building described in the applicable Purchase Order and shall not be modified, reproduced or used for any other purpose without prior Written Approval of VP Buildings.
 The General Contractor and/or Erector is solely responsible for accurate, good quality workmanship in erecting this Building in conformance with this Drawing. Details referenced in this Drawing, all applicable VP Buildings Erection Details and all Industry Standards pertaining to proper erection, including the correct use of temporary bracing.

WEST WALL ELEVATION SECONDARY

REV	DATE	BY	DESC.	BUILDER
1	9/1	ME	CLOUDED	Sindri
				ICELAND, NC
				Sindri Workshop
				Office 1

SCALE: NTS

QUOTE #

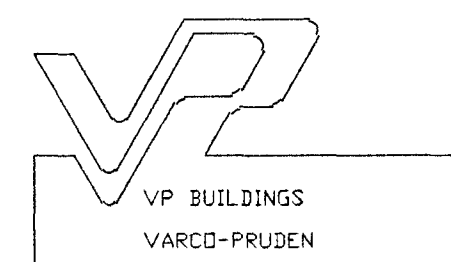

JOB # P9924127

DATE 07/02/99

TIME 16:24

DRAW/CHECK CW/ME

PAGE S6.4

Sampykkt sbr skýrsiu til KB dags 27.07.00
 Verkfæðistofa Norðurlands ehf
 Hofsbót 4, Akureyri. Kt. 560175-0869

20 MARS 2000

Eiríkur Jónsson byggingaverkfr.
 Kt 051045-4679

Sigurbjartur Halldórsson