


Byggingafultrúi Háttæknifélagið
Alfreidd Þórunn
20 MAKS 2000

Sambýkkt sbr skýrslu til RB dags 27.01.00
Verkfæðistofa Norðurlands ehf
Höfðabát 4, Akureyri. Kt. 560175-0869

Eiríkur Jónsson byggingaverkfr.
Kt 051045-4679

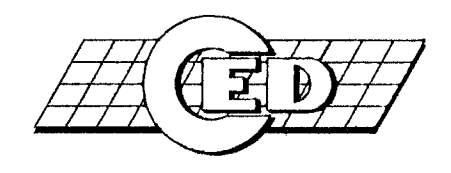

Constructive Engineering Design Inc.
Consulting Structural Engineers
222 W. Gregory Blvd., Suite 340
Kansas City, Missouri 64114-1127

Building Code: 86MBMA
Live Ld(W/D Trib Red) 205 kgsm
Coll. Ld (gravity): 24.4 kgsm
Coll. Ld (uplift): 0.0 kgsm
Wind Speed: 193 kmph
Wind Exp. Cat.: C
Ground Snow: 178.6 kgsm
Roof Snow: 100.0 kgsm
Snow Exp. Cat.: 3
Seismic Zone: 3
Building Use Cat.: 4
Auxiliary Loads: NONE

This Drawing, including the information hereon, remains the property of VP Buildings.
It is provided for Erecting the Building described in the applicable Purchase Order and shall not be modified, reproduced or used for any other purpose without prior Written Approval of VP Buildings.
The General Contractor and/or Erector is solely responsible for accurate, good quality workmanship in erecting this Building in conformance with this Drawing, details referenced in this Drawing, all applicable VP Buildings Erection Details and all Industry Standards pertaining to proper erection, including the correct use of temporary bracing.

DETAIL SHEET (SECONDARY)			
REV	DATE	BY	DESC.
1	9/1	ME	CLOUDED
BUILDER		International Client	
CUSTOMER		Sindri	
LOCATION		Reykjavik, Iceland	
PROJECT		Sindri Workshop	
BUILDING		Office	
SCALE: NTS			

QUOTE #	JOB #
	P9924127
	DATE
	07/20/99
	TIME
	XX:XX
	DRAW/CHECK
	CW/ME
	PAGE
	S6.7

