

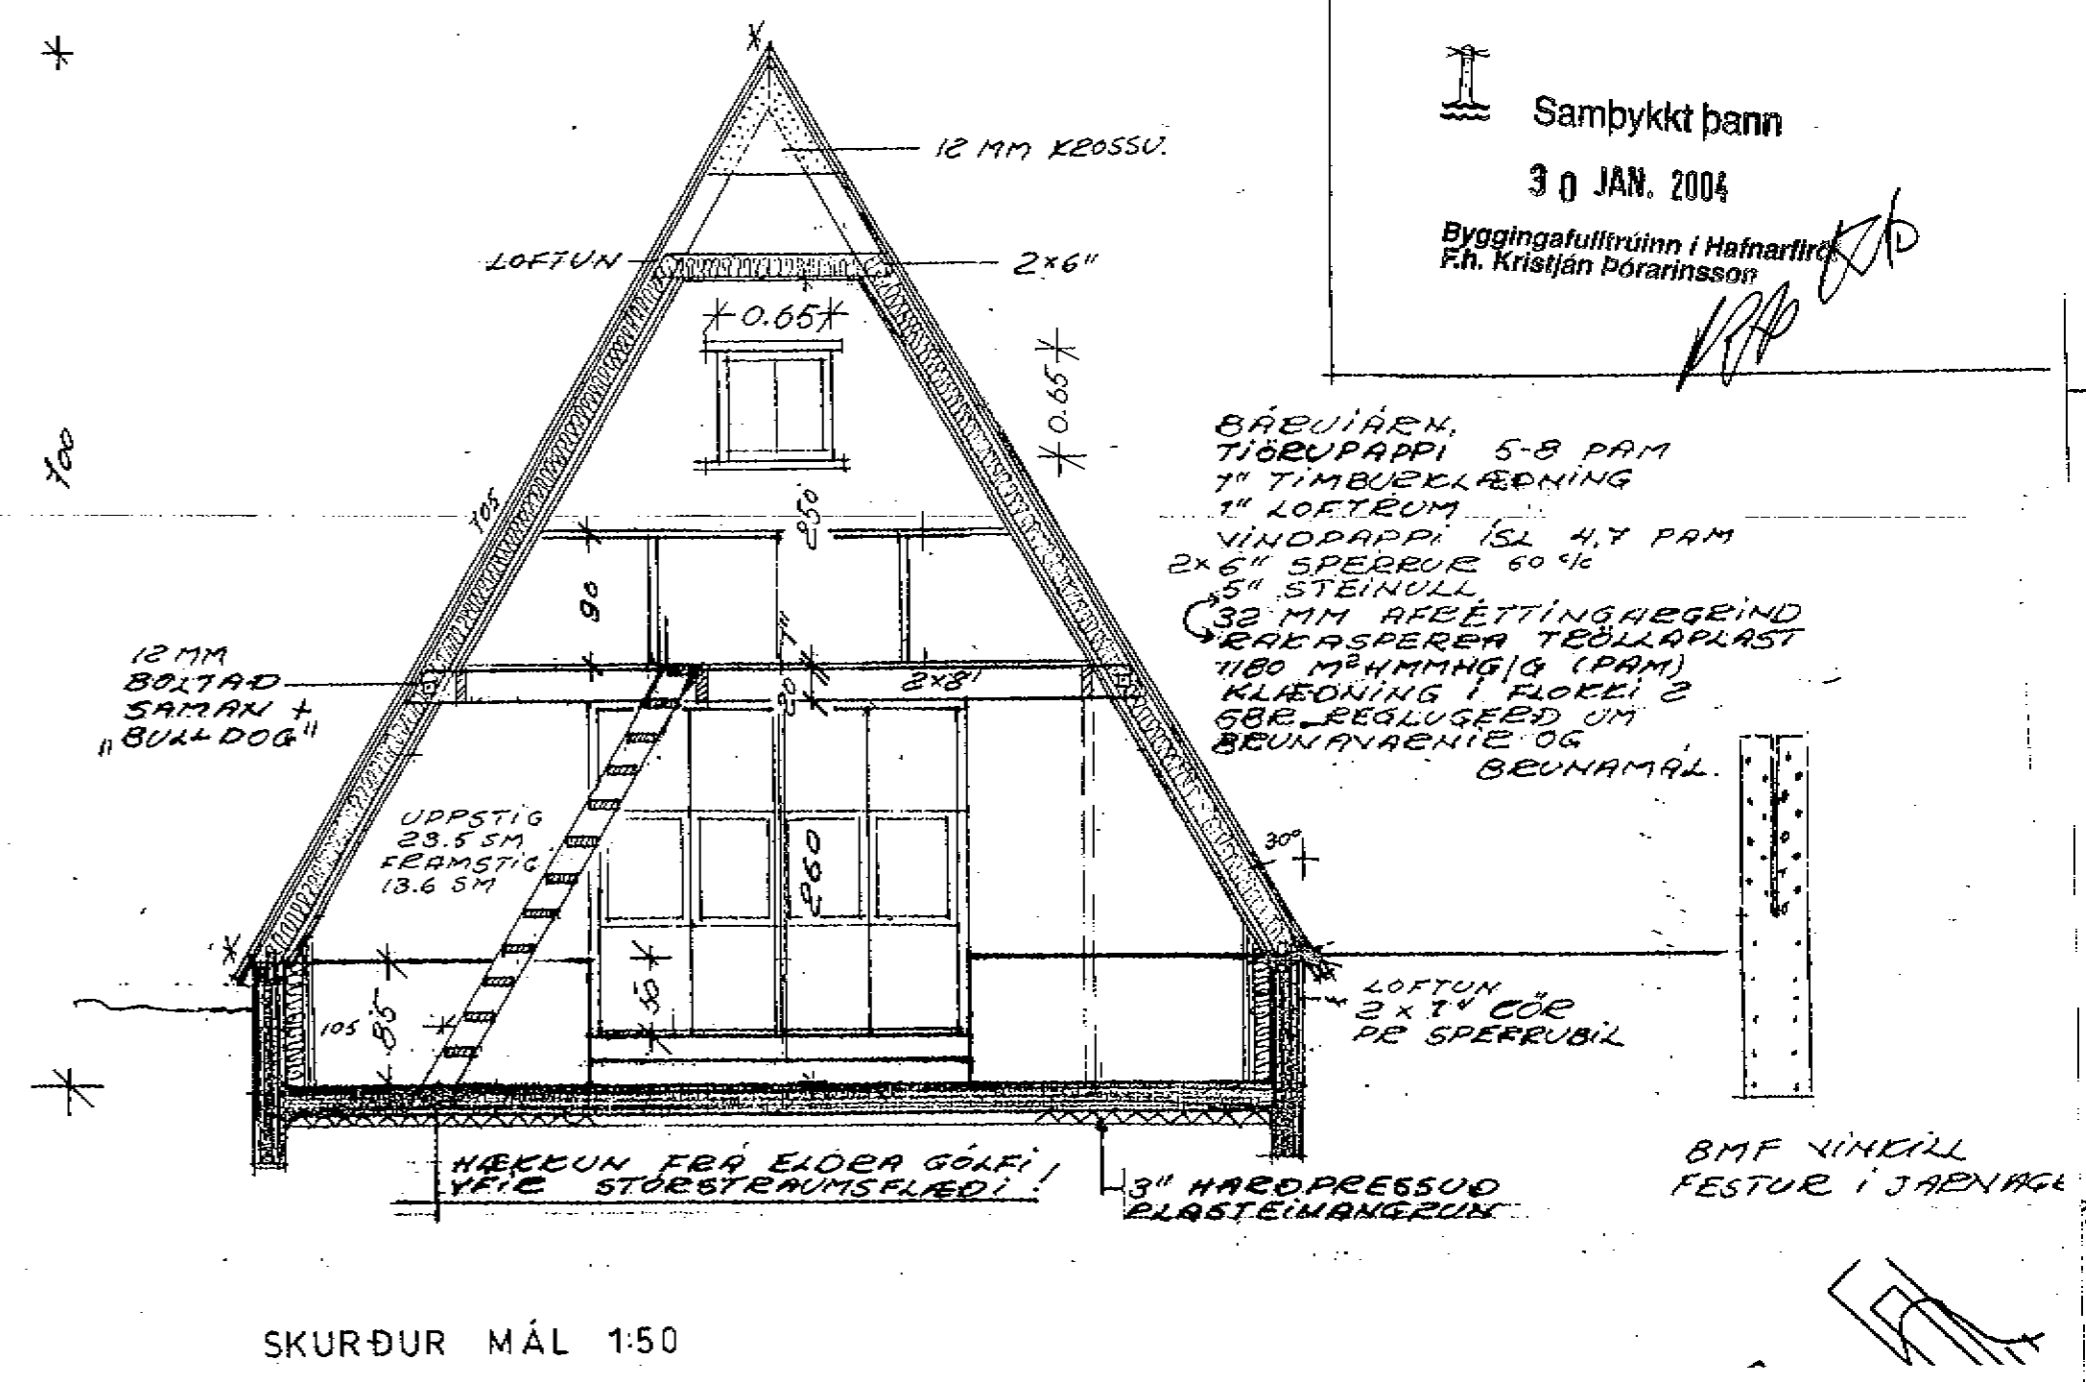
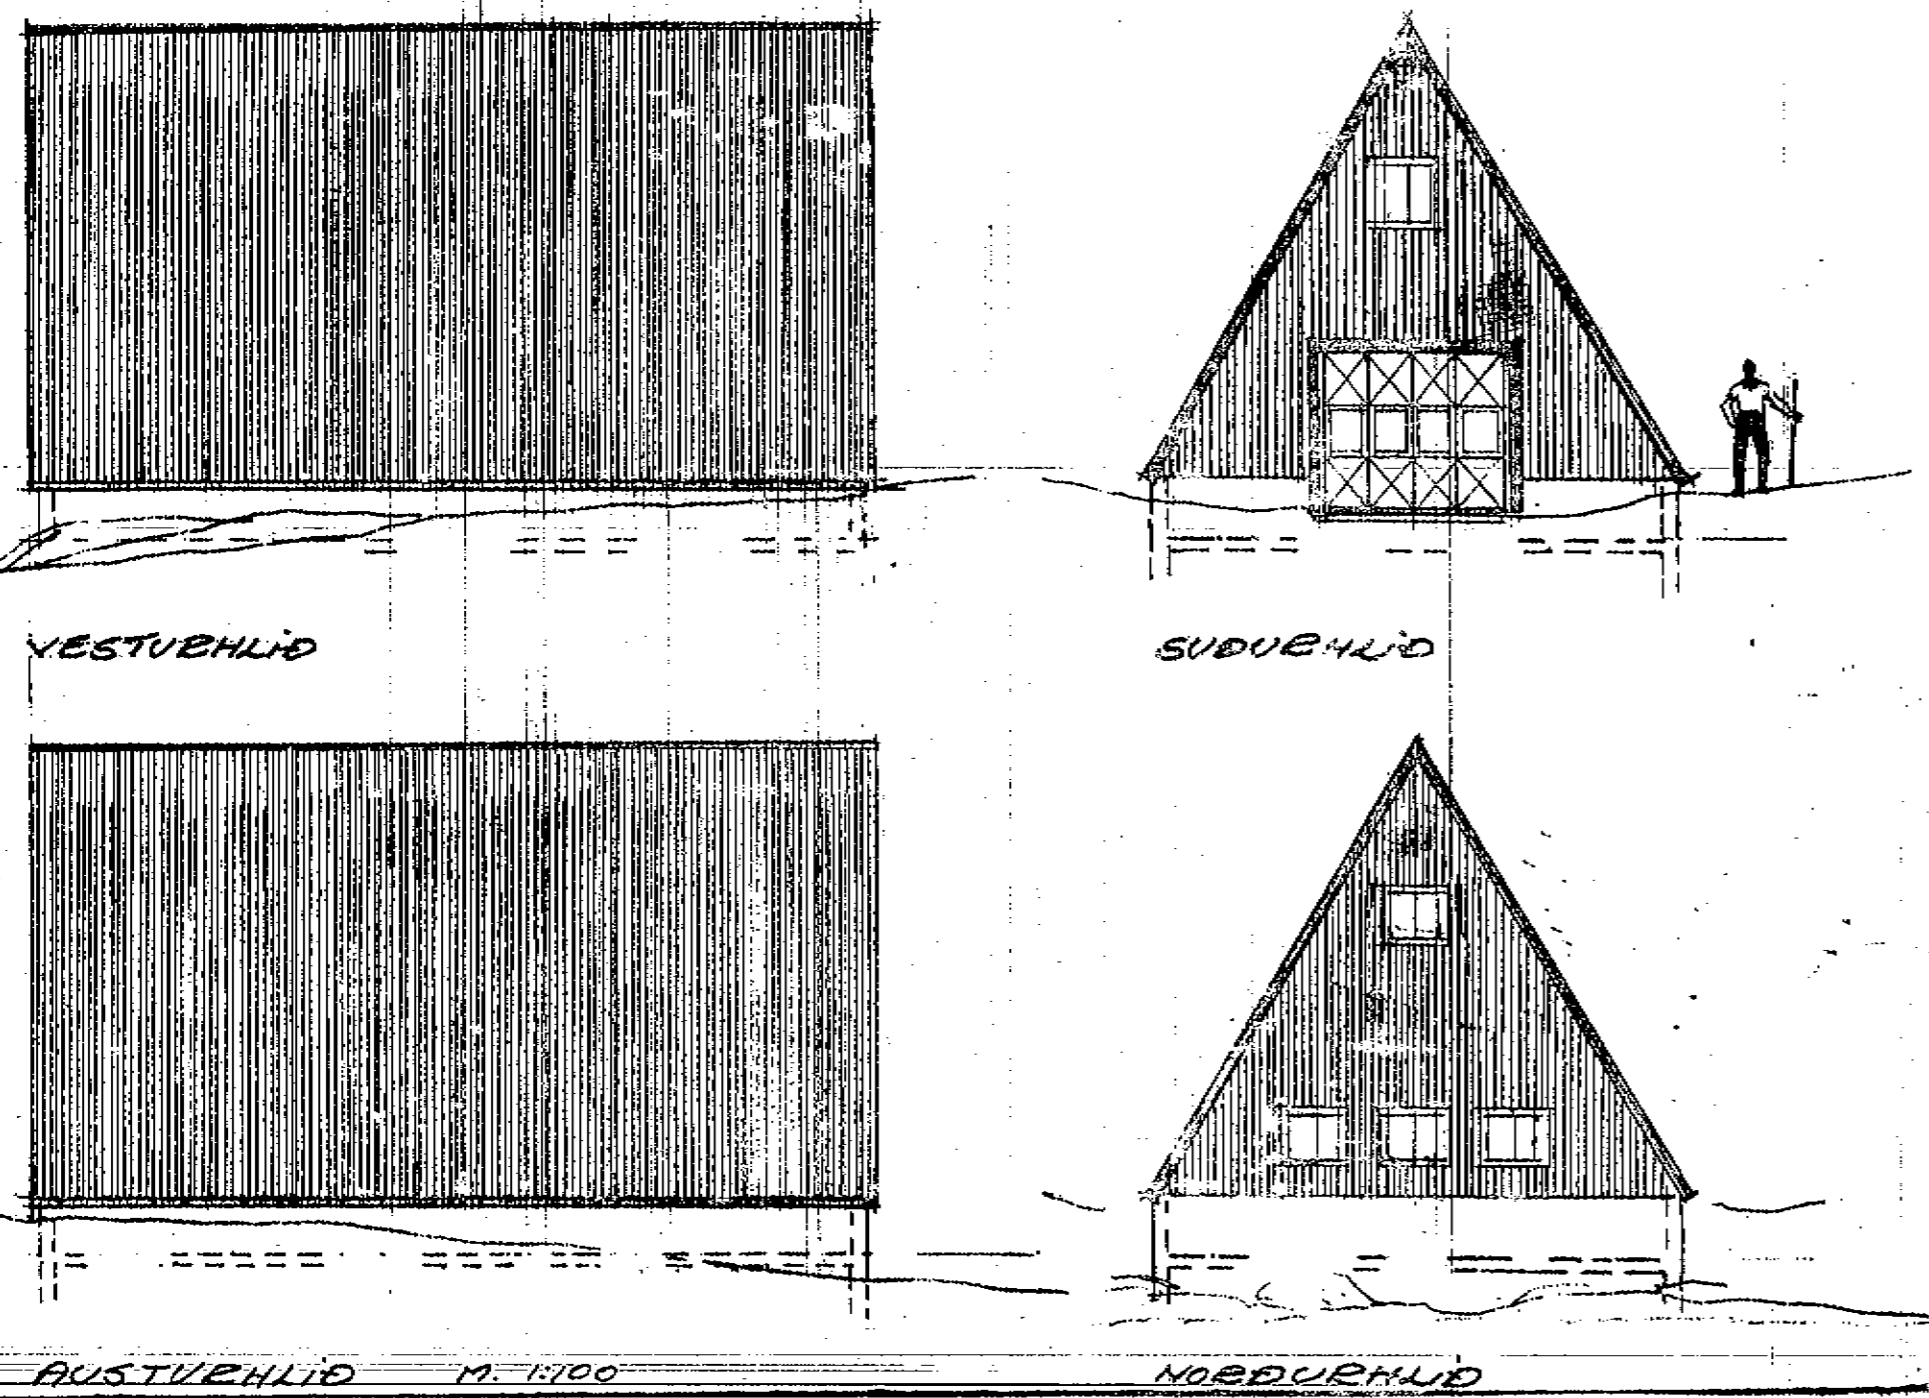


Samþykkt þann
30 JAN. 2004
Byggingafulltrúinn í Hafnarfirði
F.h. Kristján Þórarinnsson

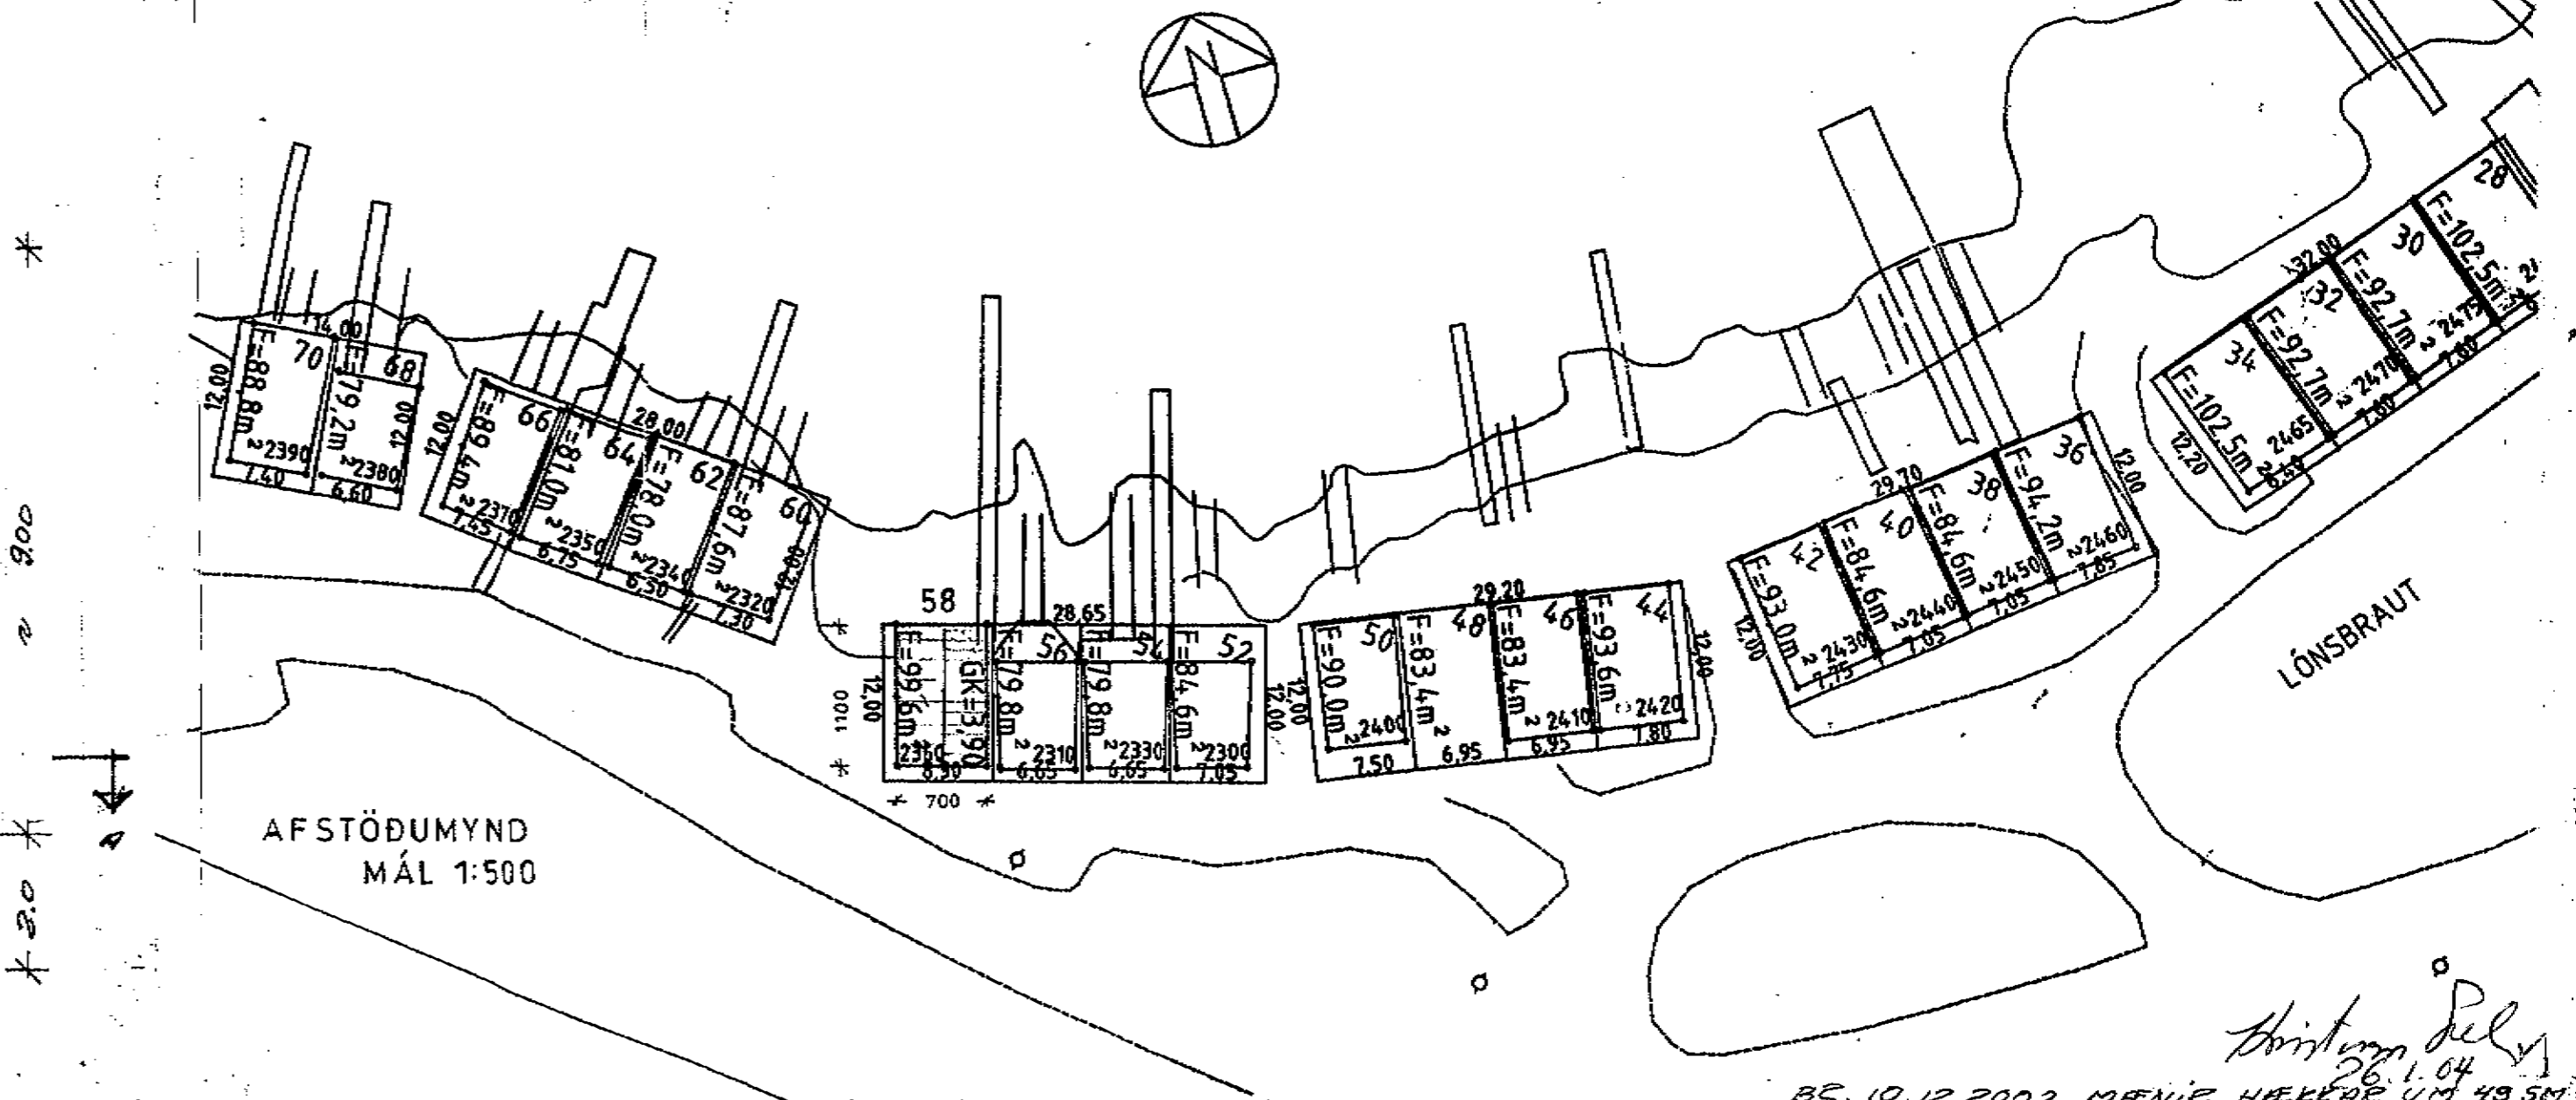

BRÚJÄRN, 5-8 PAM
TIGRUPPPI 5-8 PAM
1" TIMBURCLÆNING
1" LOFTRUM
VINDPAPPÍ 15L 4,7 PAM
2x6" SPERRUR 60%
5" STEINULL
32 MM AFFETTINGARBEIND
RAKASPÆRA TEGGLAPLAST
1180 M² HMMHGIG (PAM)
KLÆNING Í FLOKKI 2
688. BEGLUGED UM
BEUNNAEIE OG
BEUNAMAL

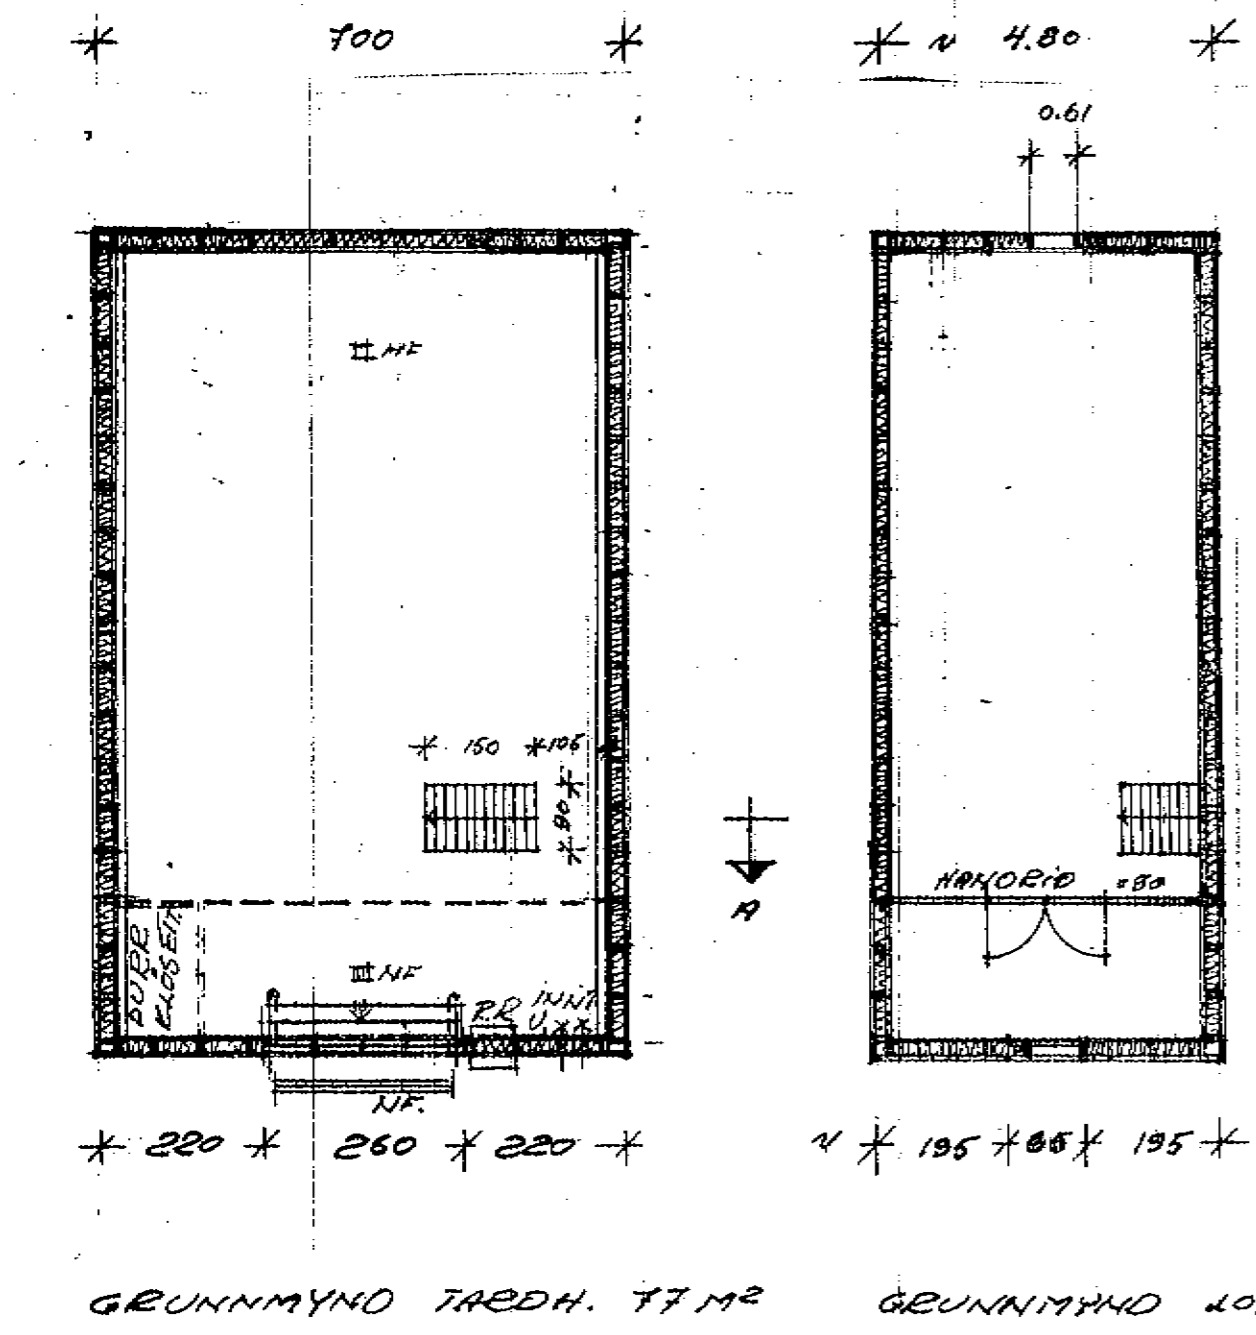

ÞÍÐSKEIÐNR. 44202360
STAÐGÆINIR 44202360
LANDNÚMÉR 121131

BE. 10.12.2002 MÆNIE HÆKKAR UM 49 SM

LÖNSBRAUT 58 HAFNARFJEDI
RYK. 1. JULÍ 99 BE. 7.8.2001
GRUNNMÝND AFSTAÐA OG SKURÐUR
MÁL 1:100 1:50 1:500
ENDURBYGGING TEIKN
KRISTINN SVENBJÖRNSSON 290645-2934
KEINGLAN 87 RUK 5. 5882889 5536332