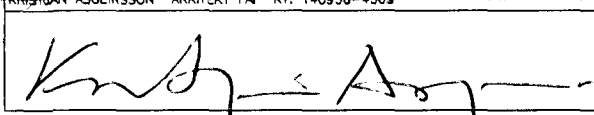


Byggingefulltrúi Hafnarfjarðar
 Algrætt þann
 18 FEB. 2000
 Sigurbjartur Halldórsson

1) BREYTT	
LÓUÁS 10,12,14,16	
GRUNNMYND 1.HÆD	KVARDI: 1:50
DAGS.: 01-11-99	STADF. BURDARÞOL
HANNAD:	TEIKNAD: YFIRF.:
ALARK arkitektar sf. <small>HAFNARBORG 7 200 KÖPVAÐUR SÍMAR 564 1137 OG 554 5244 FAX 554 4433 alark@arktek.com KT: 501193-2409</small>	
	
11	