


E 18

EININGARNAR SKULU JÁRNBEINTAR SAMKV. STANDARD FRAMLEIDSLU.
EININGARNAR ERU FRAMLEIDDAR HJÁ EININGAVERKSMIDJAN ehf

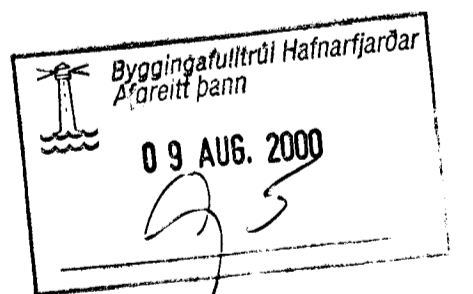

Baldwin Olason

BREYTT AGUST 2000 EINING 14 OG 18

| | |
|-------------------|-------------|
| LOUÁS 28 | |
| ÚTLIT EININGAR | |
| 1:50 | APRIL 2000 |
| TEIKNING 6 | |
| G. BALDWIN OLASON | 171055 7849 |
| TÆKNIFRÆÐINGUR | 897 2111 |