

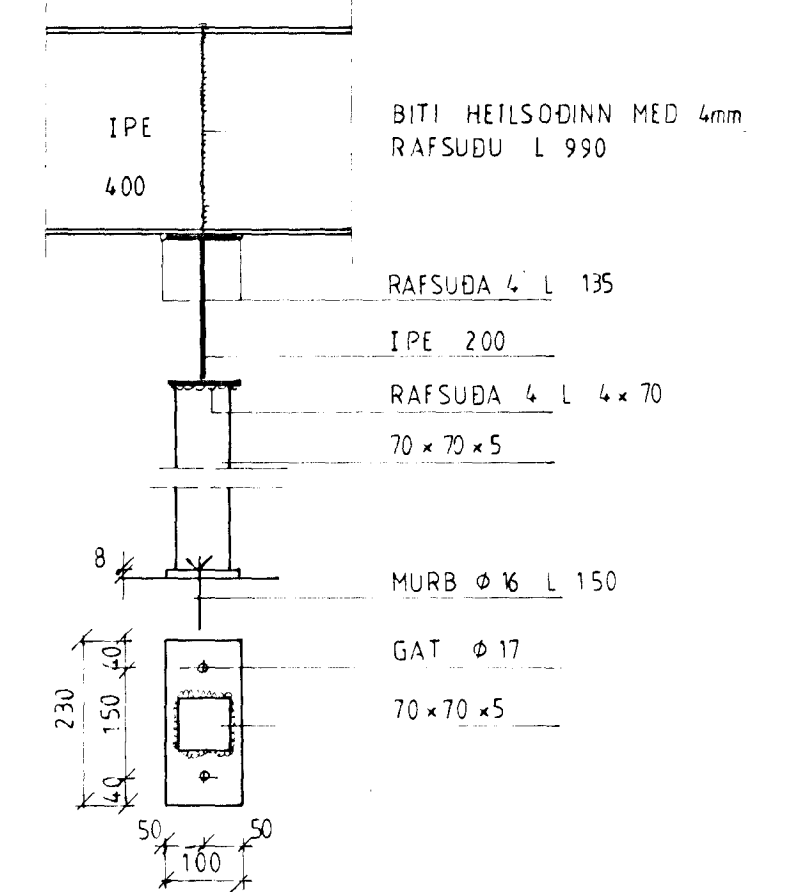
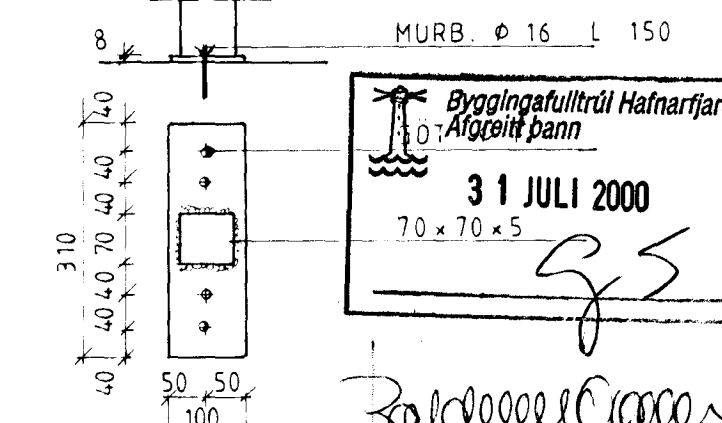


BMF GATAGIRDI 25x2 NEGLIST MED
2 ST KAMSAUM 40x50 I HVERJA SPERRU
GIRÐI KOMI UNDIR BORBAKLÆDNINGU

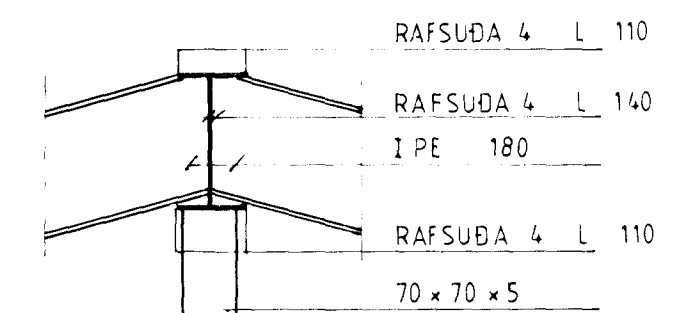

T 1:10

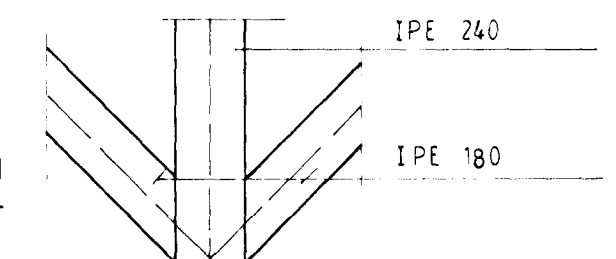


Byggingafultrúð Hafnarfjardar
31 JULI 2000
70x70x5
[Signature]


BREYTT MAI 2000 STALBITAR
BREYTT MAI 2000 STALBITAR
BREYTT MAI 2000 GIRÐI Í ÞAKI
BREYTT APRIL 2000

LÓUÁS 28	
ÞAK OG DEILAR	
1:SC 1:10	TEIKNING 4
JAN 2000	
G BALDVIN OLASON	17 1055 7849
TÆRNIFR	597 2111


R 1:10

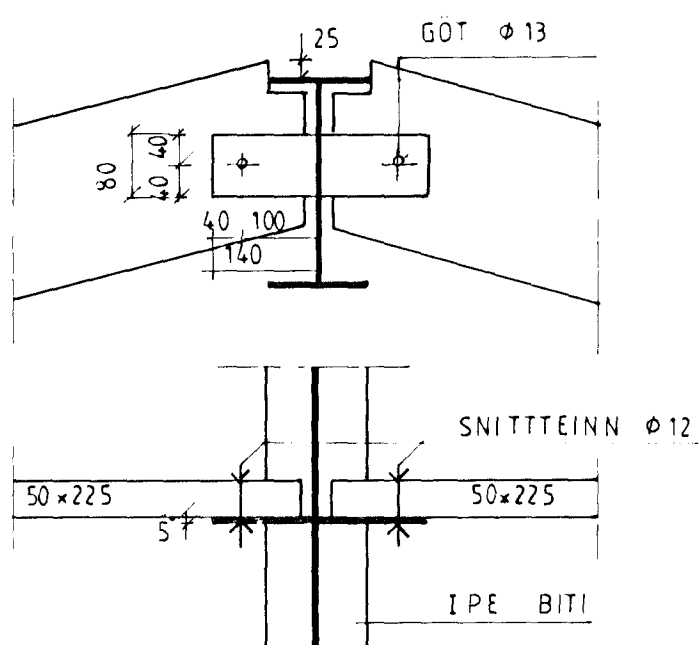

N 1 1:10

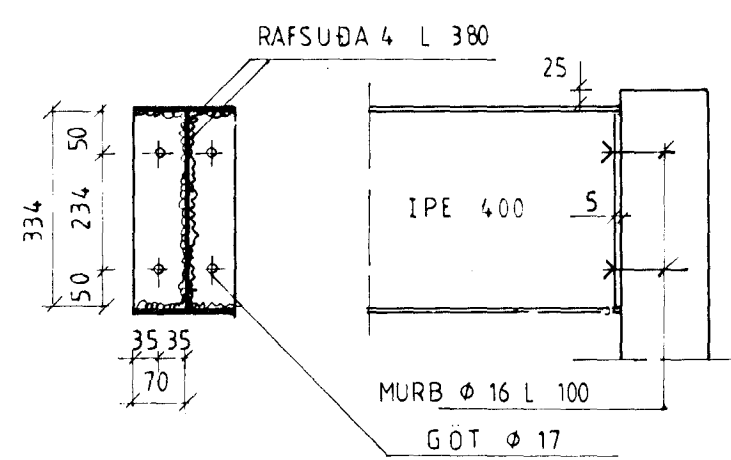

N 2 1:10

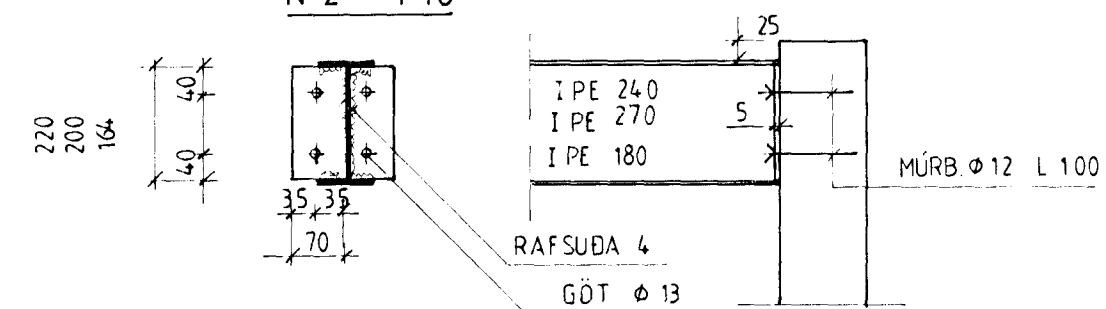

S 1:10

