


SNIÐ A-A MKV. 1:100

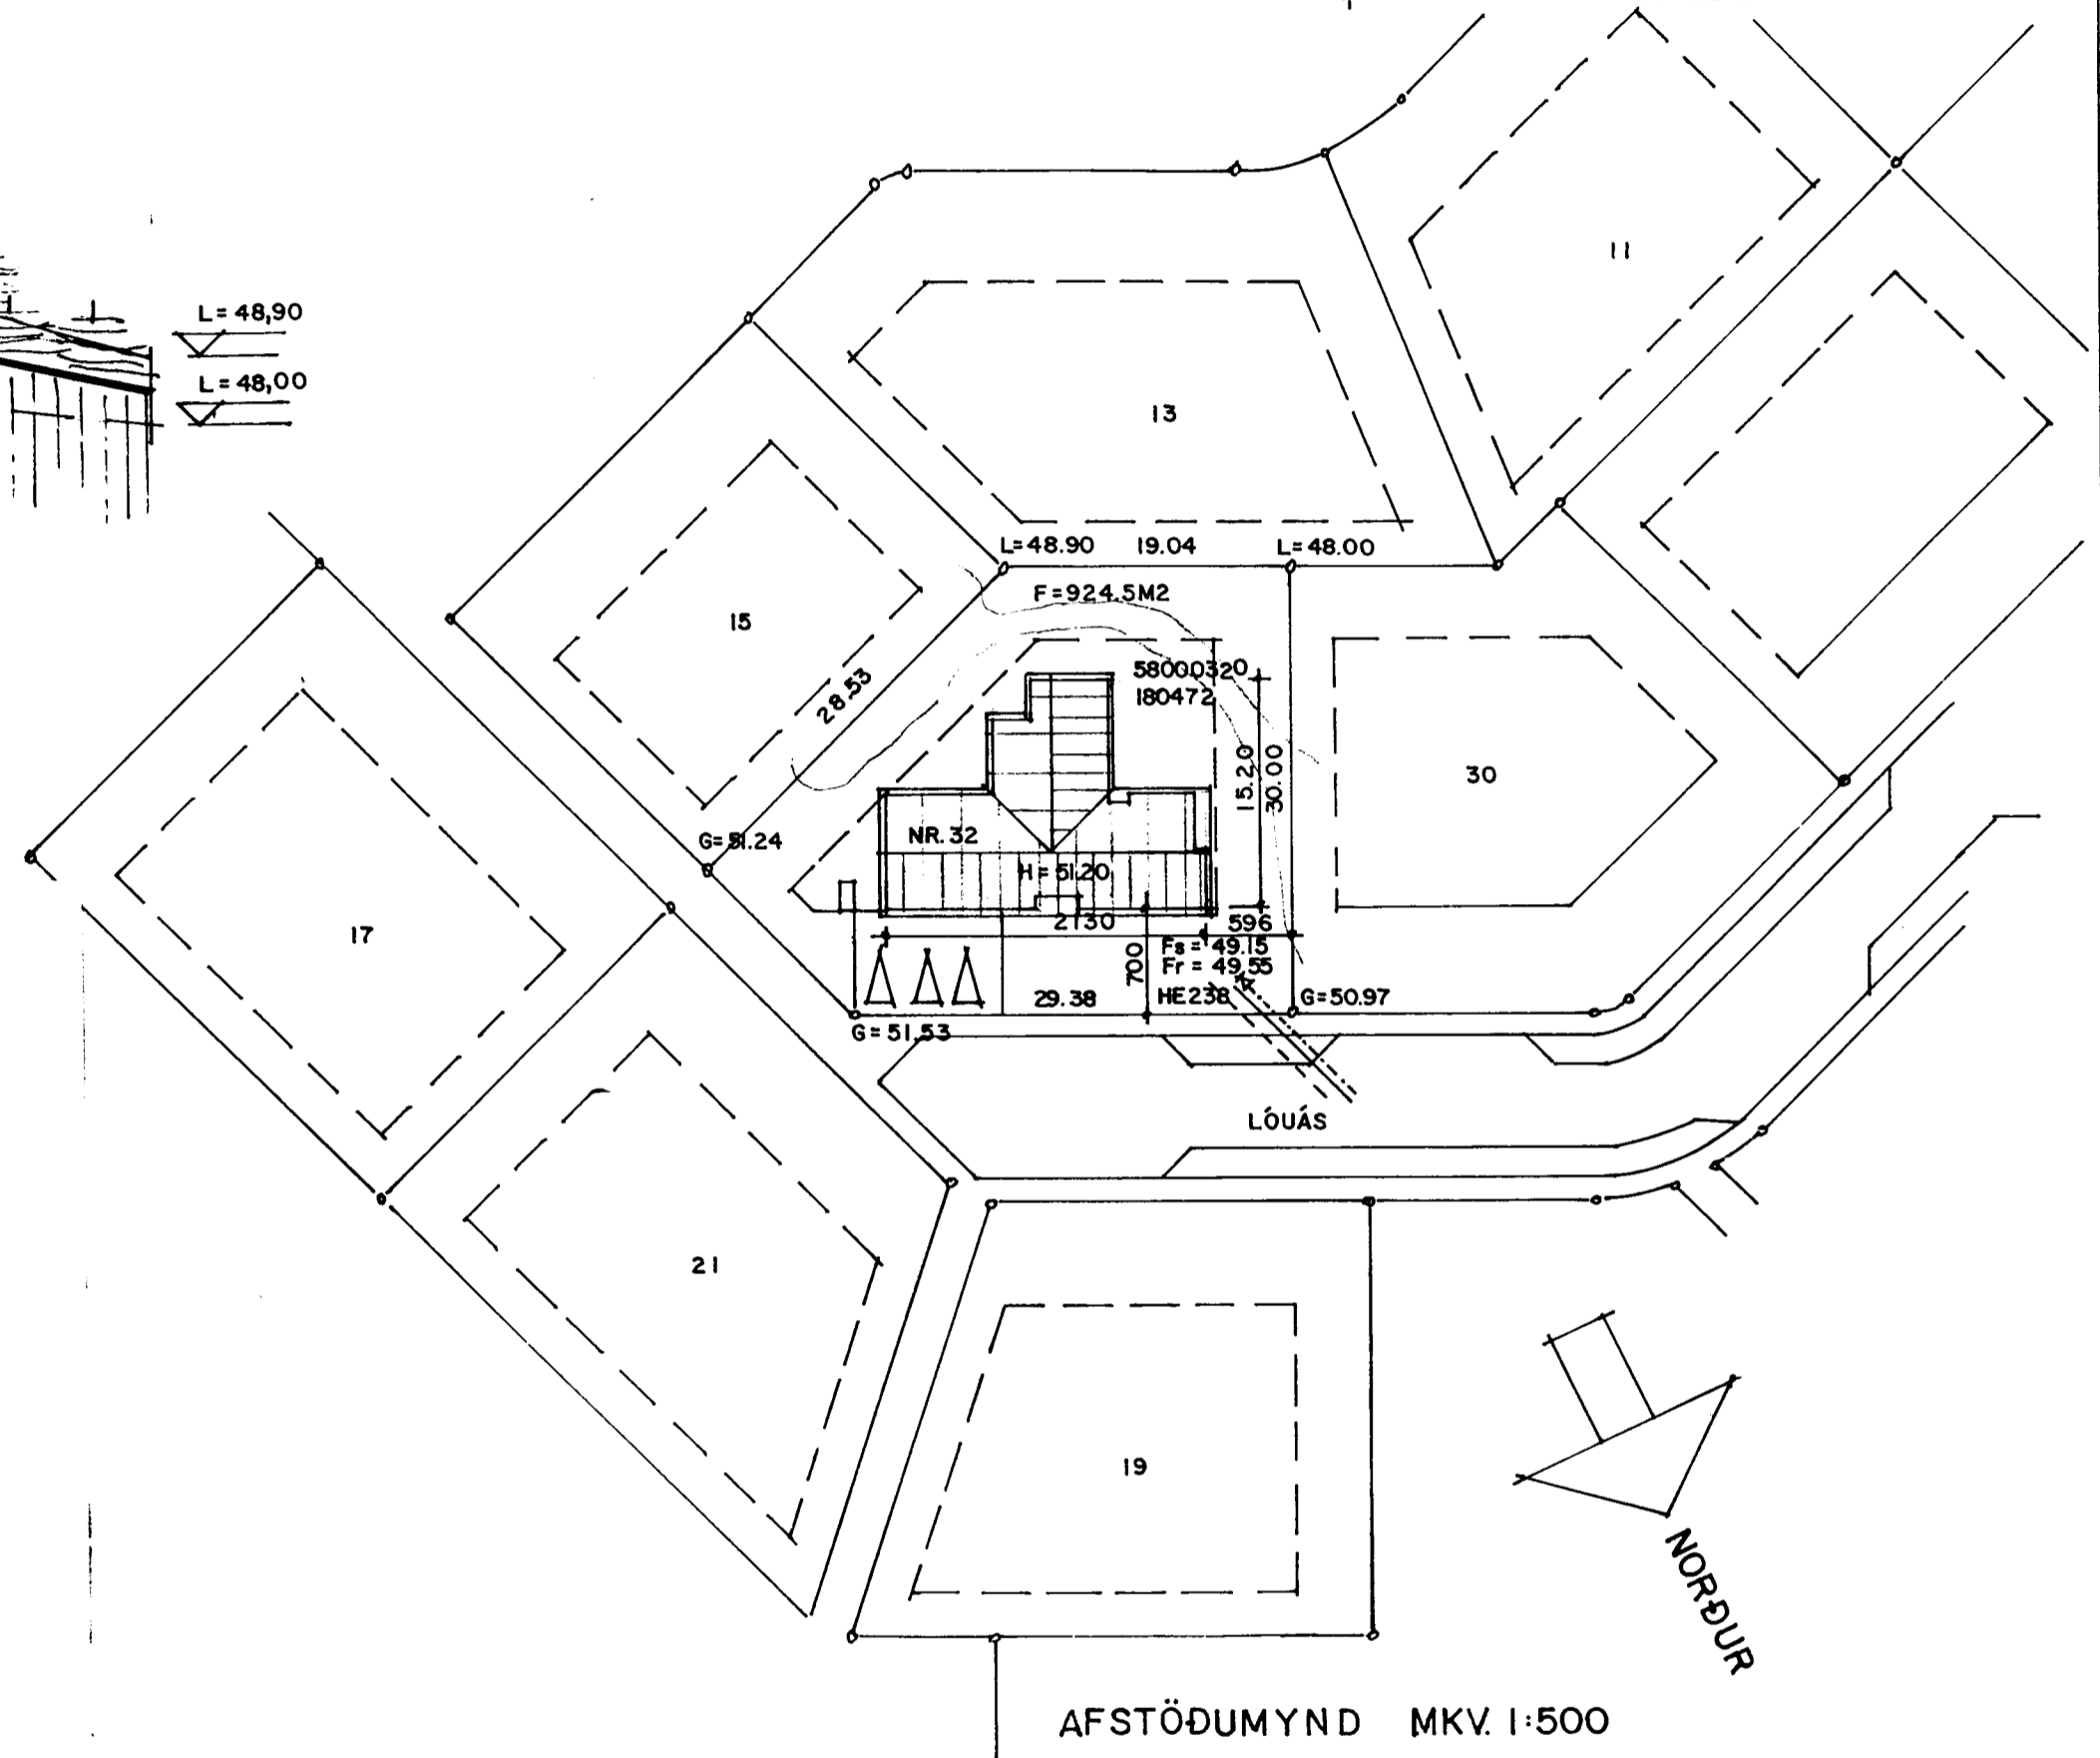

AFSTÖÐUMYND MKV. 1:500

Skráningartafla: Lóúás 32 - Hafnarfirði		Skrásetjari: Trausti Hafsteinsson															
Landnúmer: 180472		Kennitala: 010166-3229															
Mætlunúmer: 01		Útgáfa: 401															
Dags.: 19/10 '99																	
Uppekking og lýsing																	
D0	D1	D2	D3	D4	D5	D5M	D6	D7	D8	D9	D10a	D10b	D11	D12	D16	D17	
Lokun	Rými hæð-röð	Nokkun texti	HÁUð-Rokkun	Eignar-hald	Botnrúm m ²	Málarkv. m ²	Siggar m ²	Op m ²	Brúðarkv. m ²	Brúðarkv. m ² < 1.8	Salarhæð min	Salarhæð max	Brúðarkv. (óregl.) m ²	Nýbrúðarkv. m ²	Birt fatarátt m ²	Flæktatala skiptarúmmál m ²	Skipul. rúmmál m ³
		Mæthluti			420,0	0,0	0,0	0,0	210,0	0,0			774,7	180,4	210,0		487,080
		Botn															42,0
		01	1. hæð		210,0	0,0	0,0	0,0	210,0	0,0			567,0	180,4	210,0		
A	0101	Ibúð	N	0101	159,3				159,3		2,70	2,70	430,1	135,3	159,3	2,70	365,310
A	0102	Blískúr	N	0101	50,7				50,7		2,70	2,70	136,9	45,1	50,7	2,70	121,770
B	0103	Sorp	T	0101	2,4				2,4		1,40	1,40					
		02	Þak		210,0	0,0	0,0	0,0	0,0	0,0			165,7	0,0	0,0		
A	0201	Þakrymi	F	X	210,0						0,30	1,25	165,7				
Athugasemdir																	
Sameignir summa																	
Eignarhald																	

Breytt 2. Mai 2002
2) Skorsteinn fjarlægður.

Lóúás nr. 32 Dags. Okt. 1999 Breytt:
Snið Mkv.1:100. Afstöðumynd 1:500, Skráningartafla.
Gústaf B. Ólafsson m.b.f.í. kt. 200759-7619
2/5 2002 *Gústaf B. Ólafsson*