





Samþykkt bann

10 MAI 2002


Byggingafulltrúinn í Hafnarfirði
F.h. Kristján Þórarinnsson

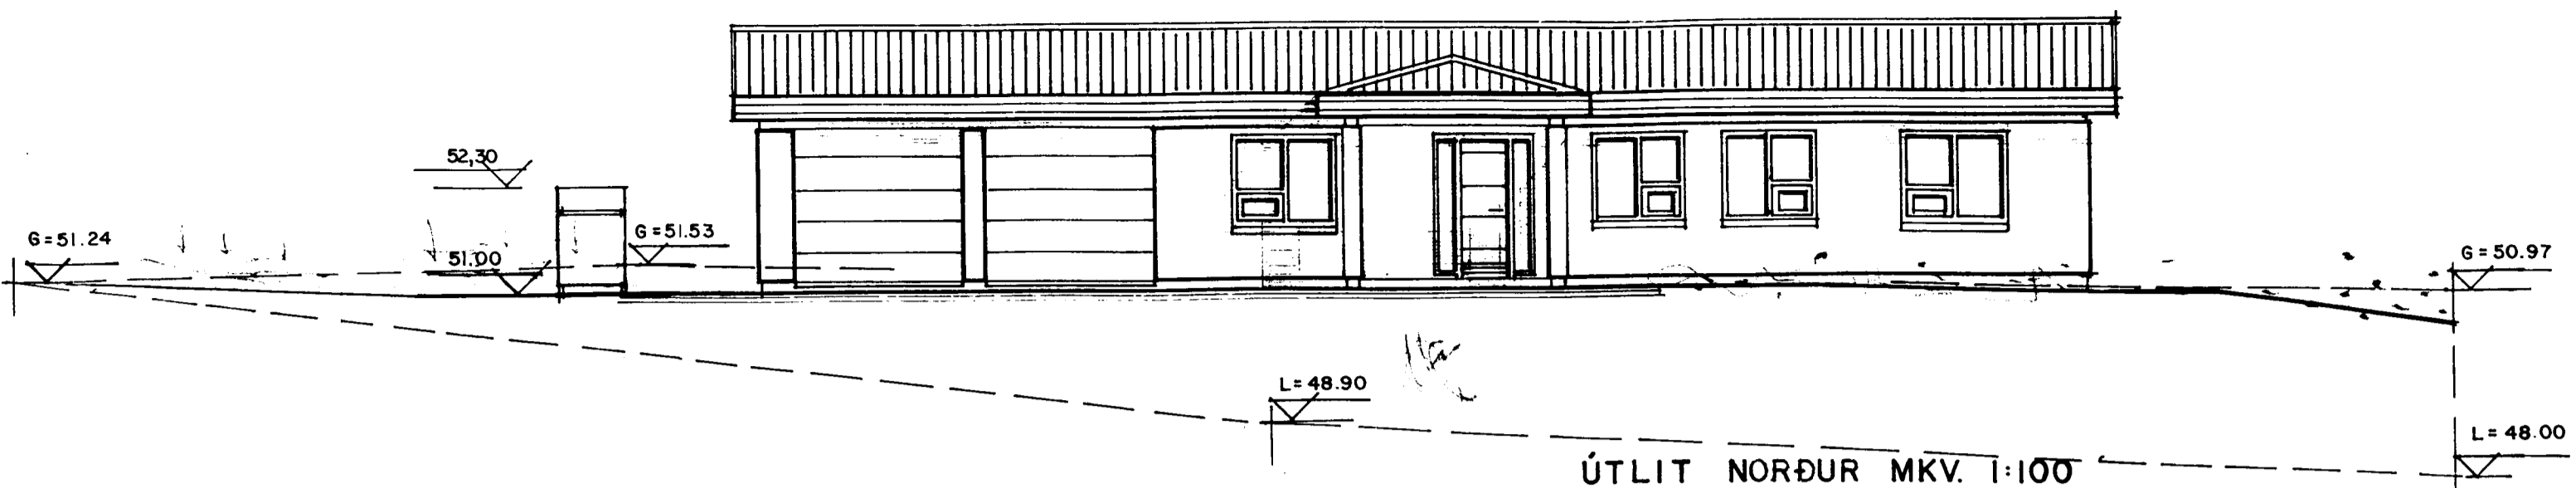


ÚTLIT NORÐUR MKV. 1:100

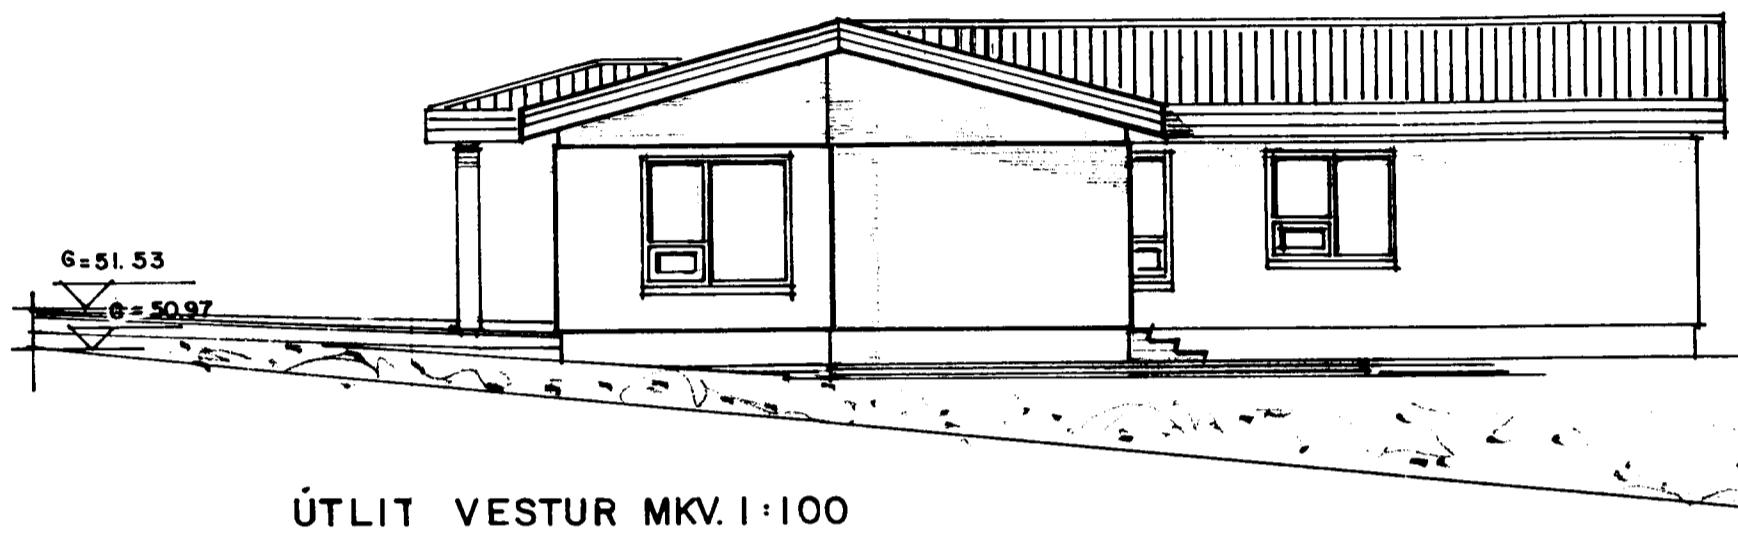

ÚTLIT VESTUR MKV. 1:100

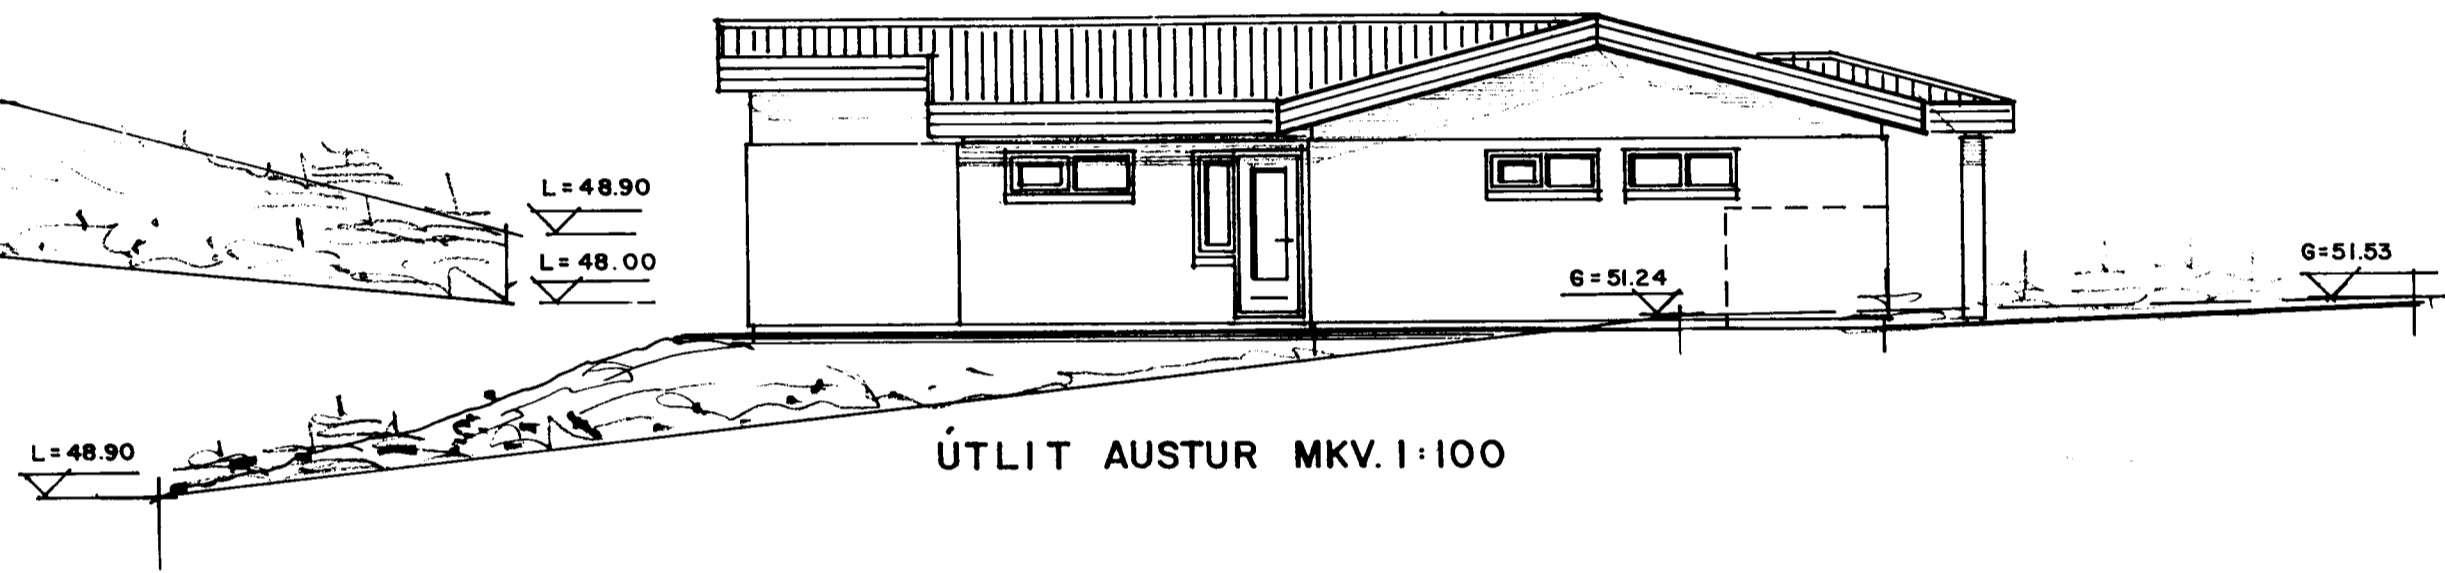

ÚTLIT AUSTUR MKV. 1:100

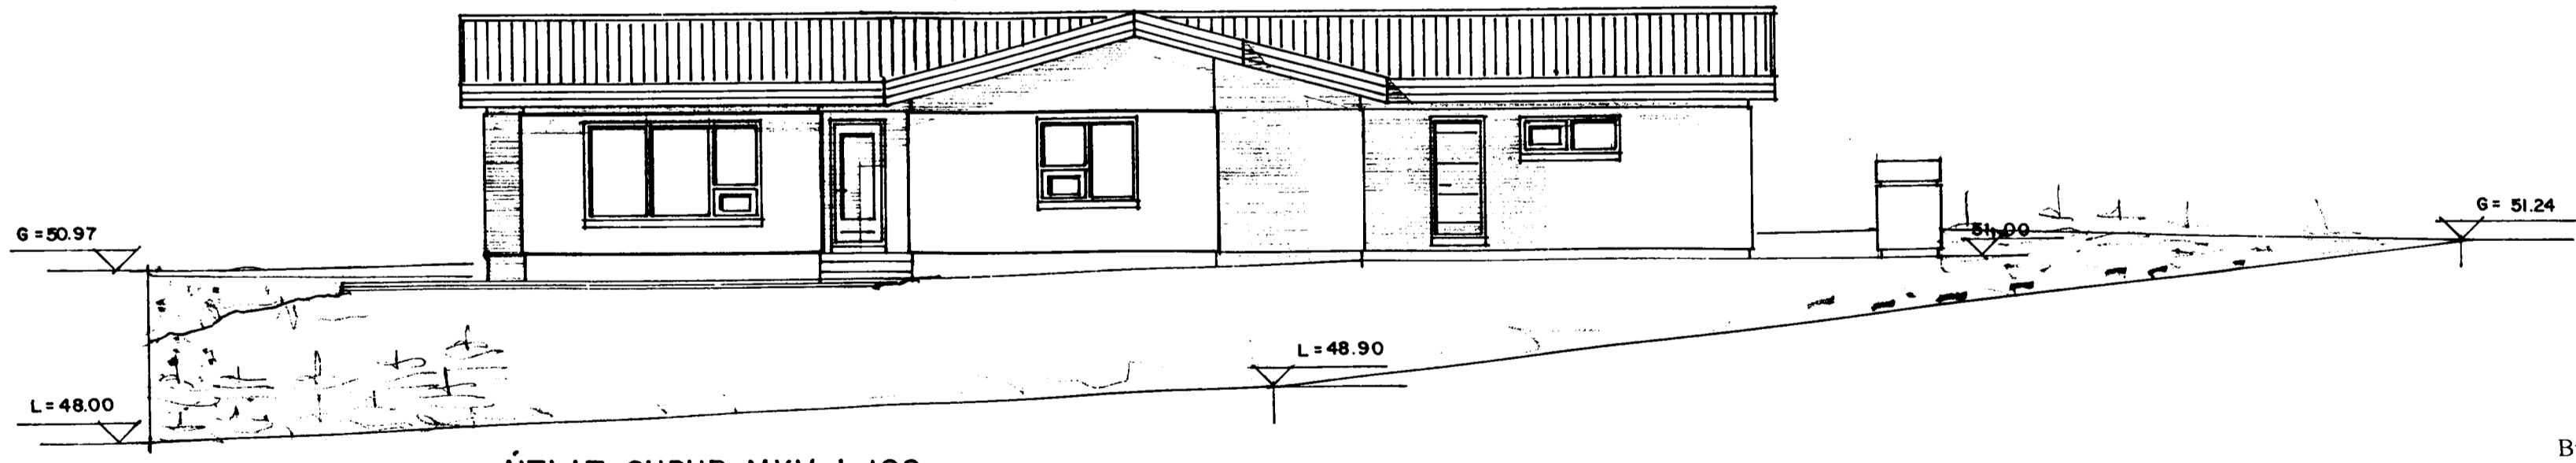

ÚTLIT SUÐUR MKV. 1:100

Breytt 2. Maí 2002
2) Skorsteinn fjarlægður.

Lóuás nr. 32 Dags. Okt. 1999 Breytt:

Útlit Mkv. 1:100.

Gústaf B. Ólafsson m.b.f.i. kt. 200759-7619

2/5 2002 *Handwritten signature*