
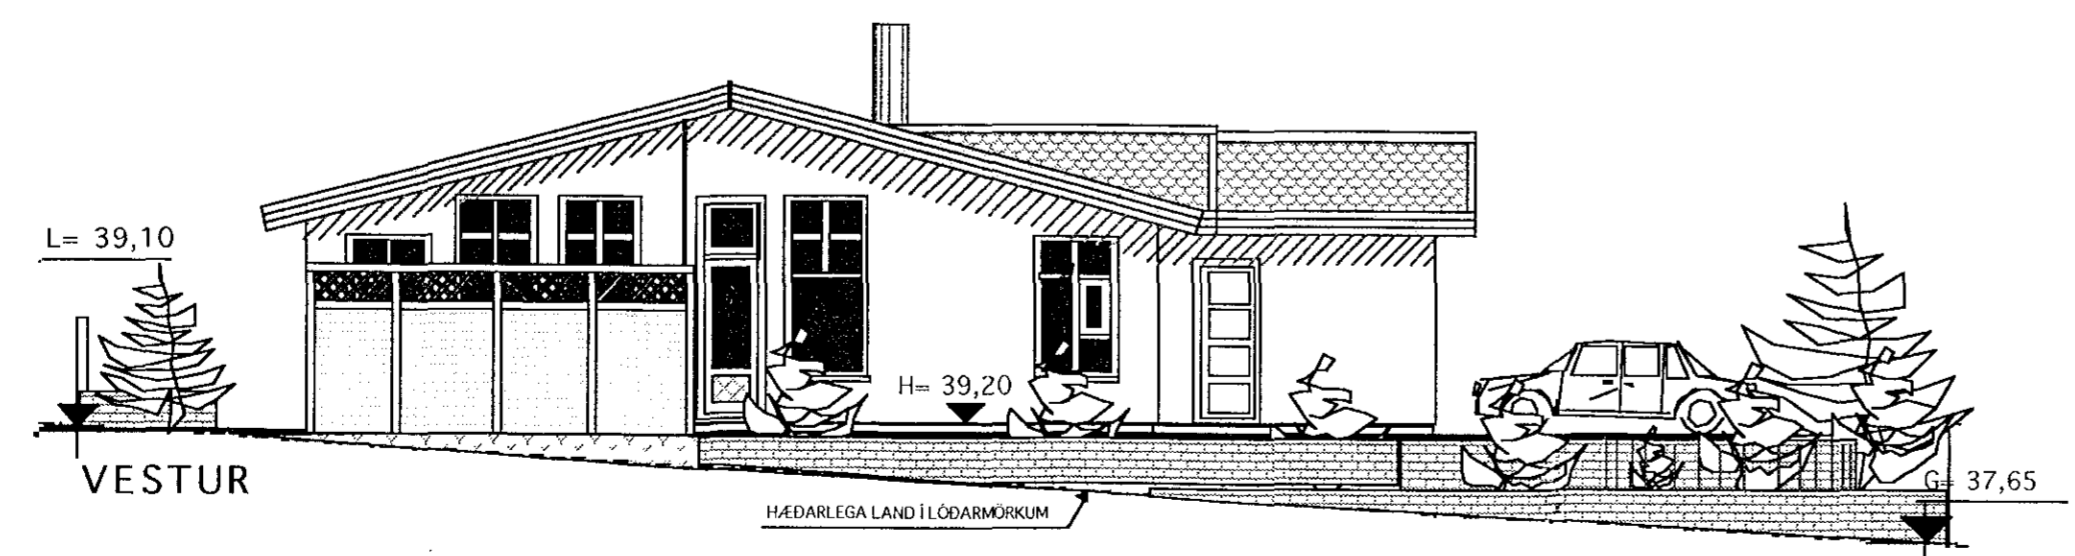
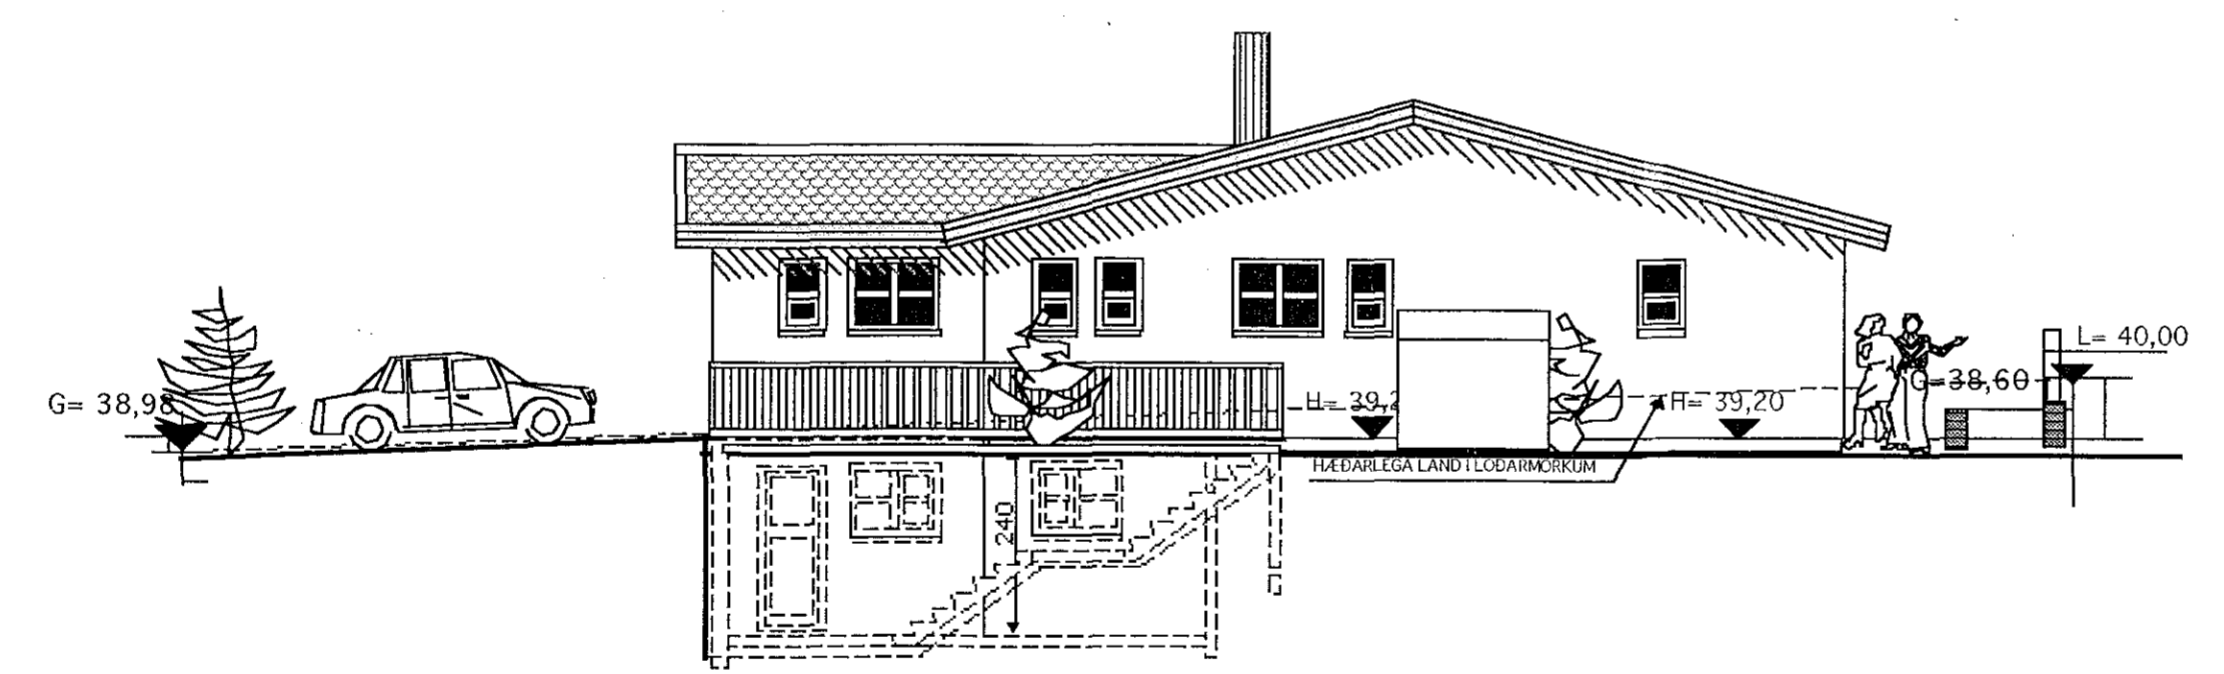
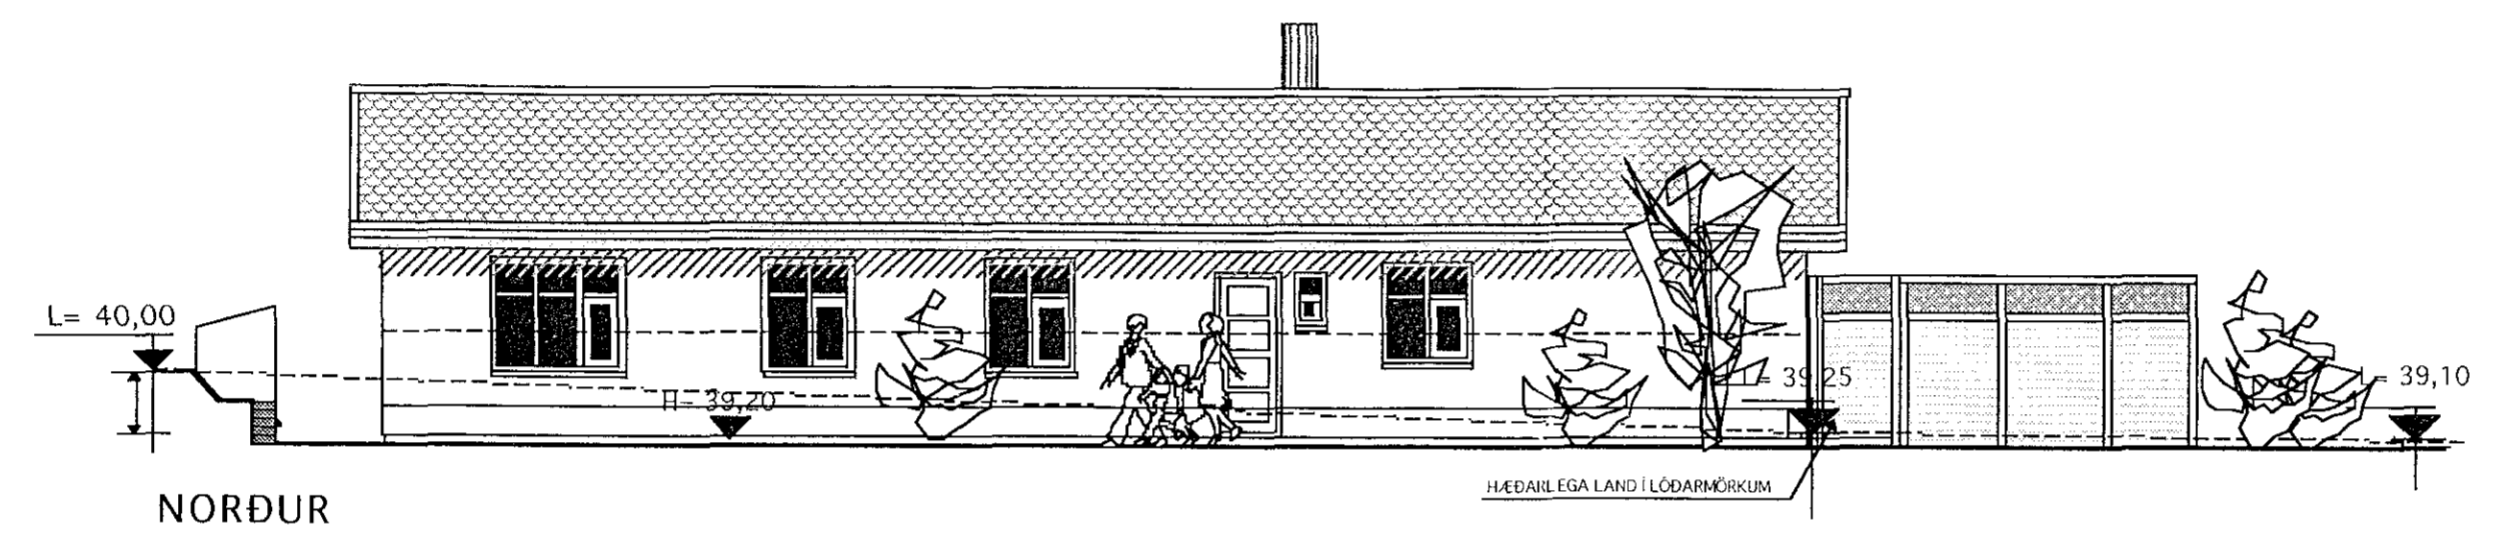


Samþykkt þann

04 JAN 2006

Byggingatulltrúinn í Hafnarfirði
F.h. Kristján Þorarinsson

AP

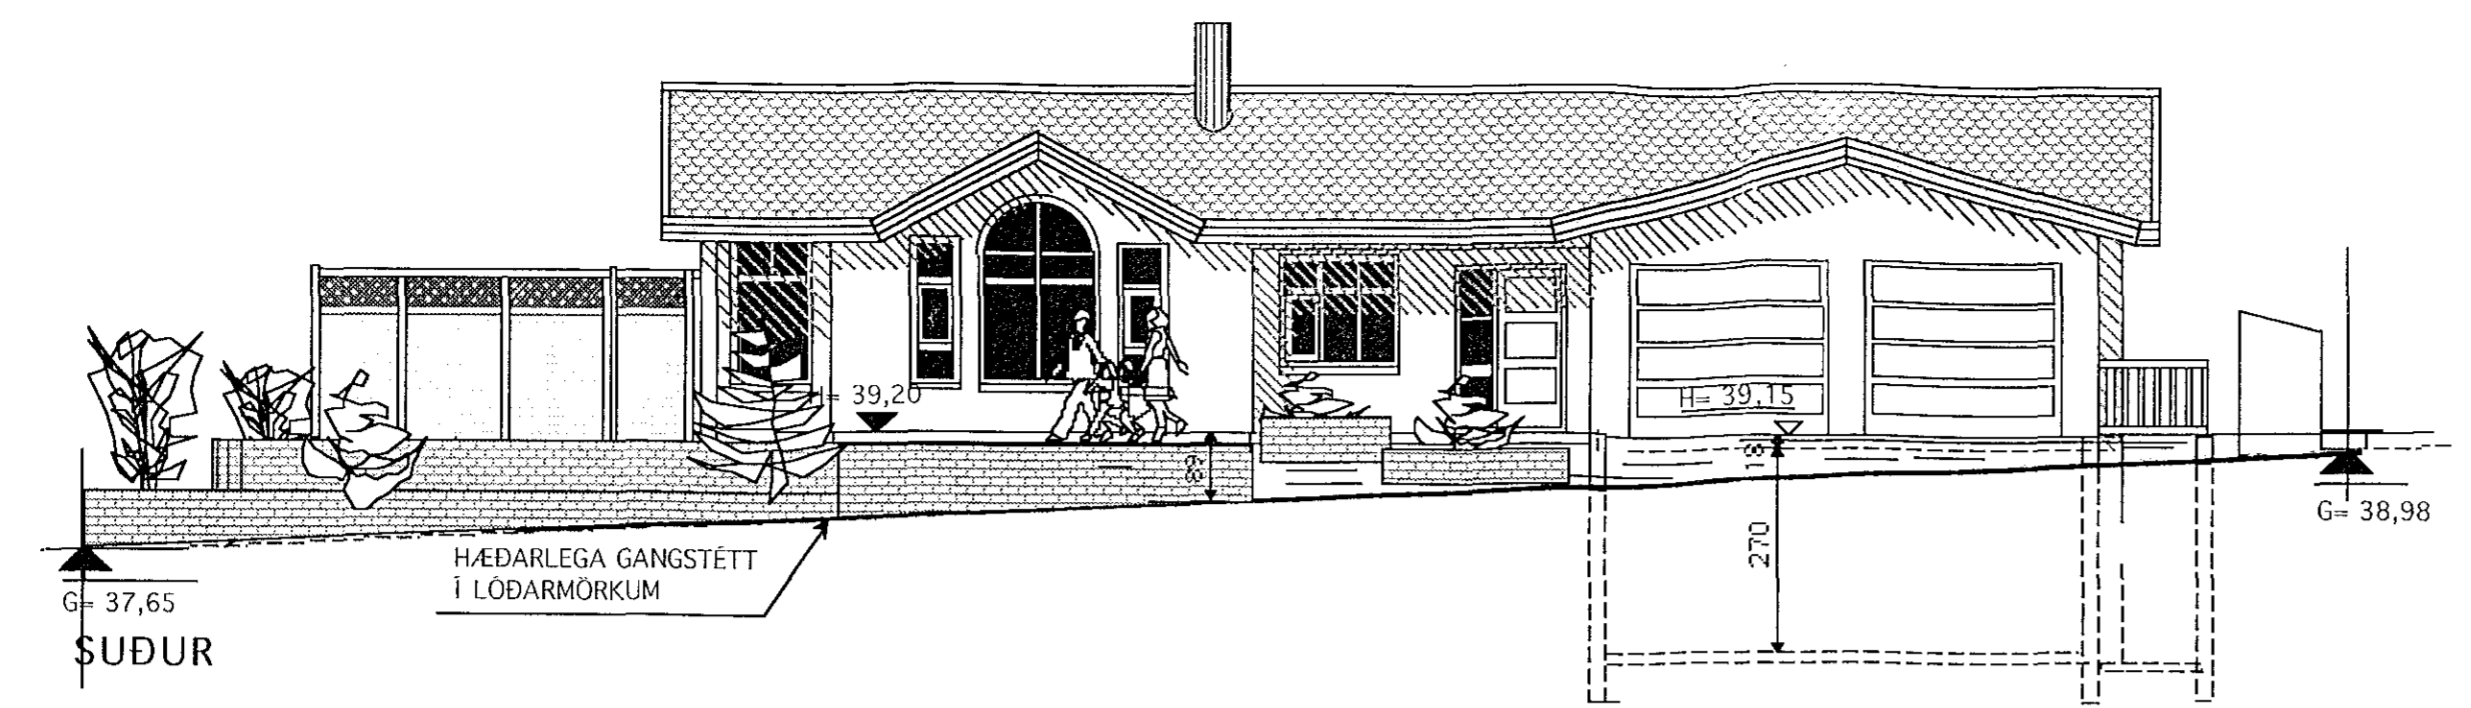

TEIKNISTOFAN KVARDI	Verkefni	LÓUÁS 7 HAFNARFIRÐI breytingar kjallari o.fl. .
	Heiti	ÚTLITSMYNDIR
kvarði	1:100 1:500	verk.nr
dags.	4 JAN..2002	dags br. 24 OKT. 2005
hönnun	G. G.	teikn nr
teikn	G.G.	A-3

Hringbraut 17 220 Hafnarfirði
s. 555-2020 FAX 555-2021
Gísli G. Gunnarsson BFL Rt, 020649-2408
kvardi@vortex.is
Gísli Gunnarsson