




G= 37,65 SUÐUR

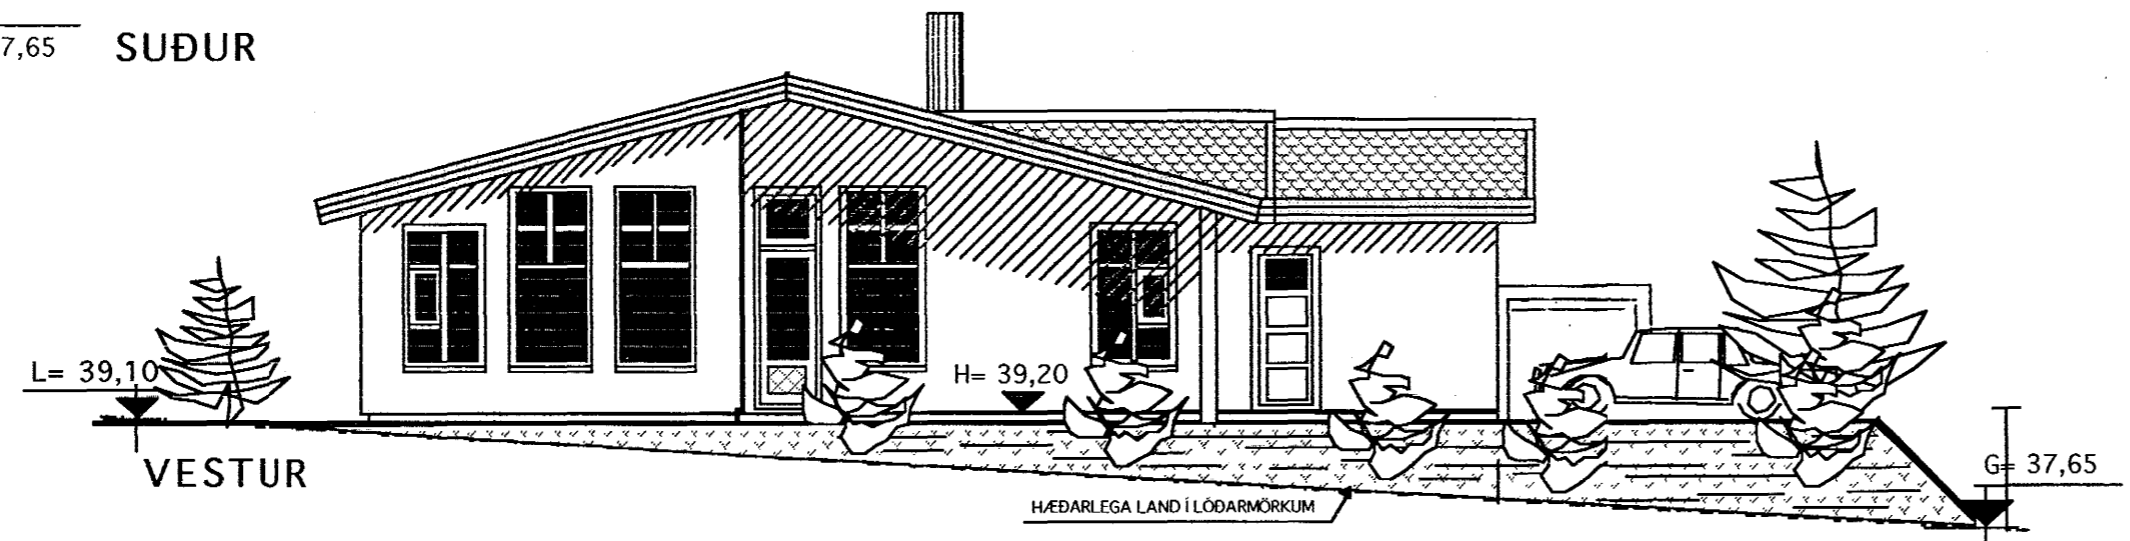

VESTUR

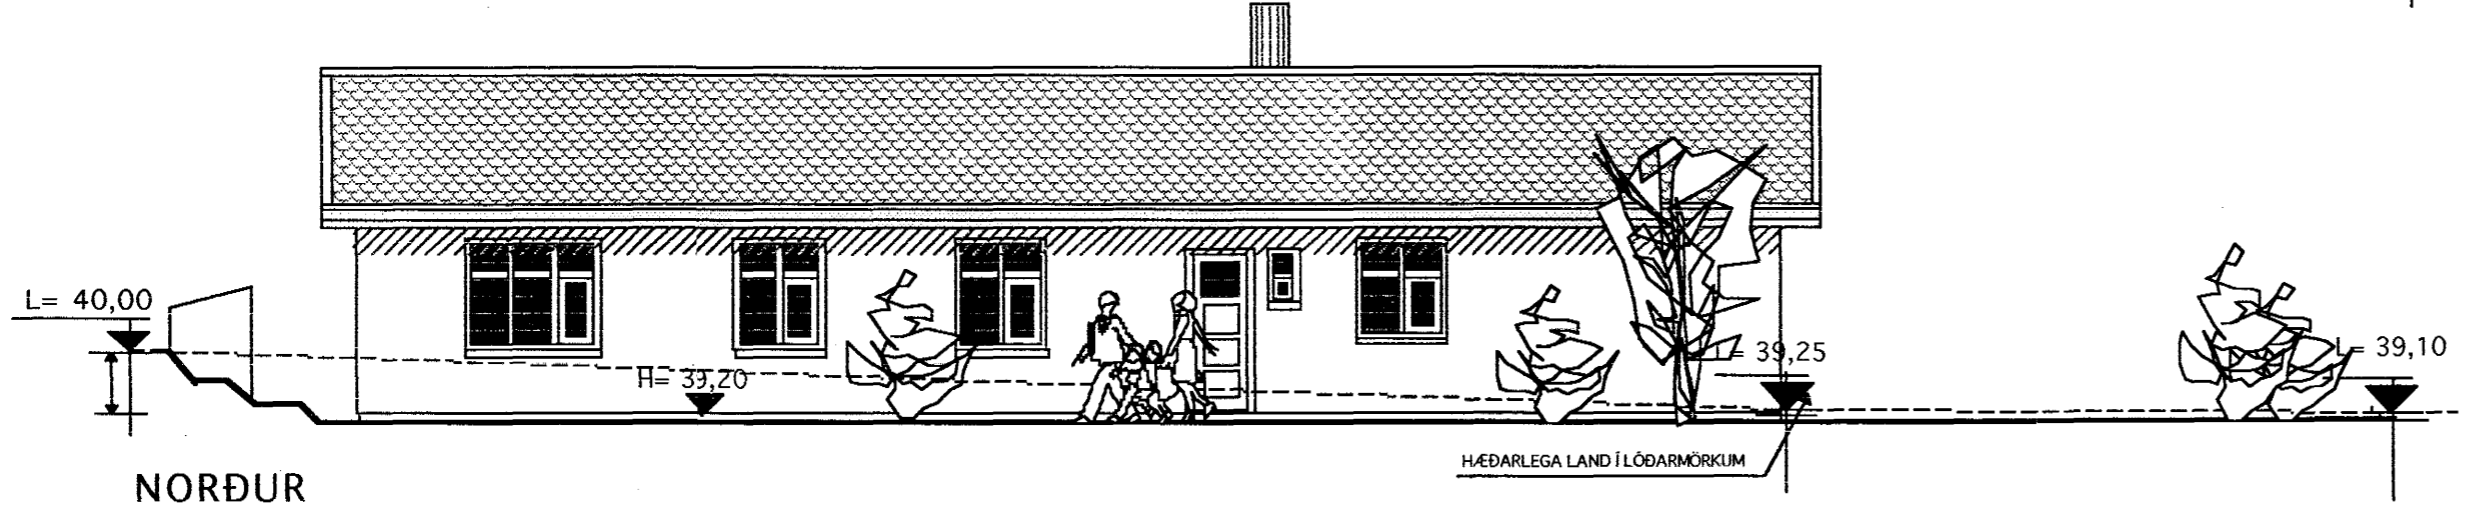


NORÐUR

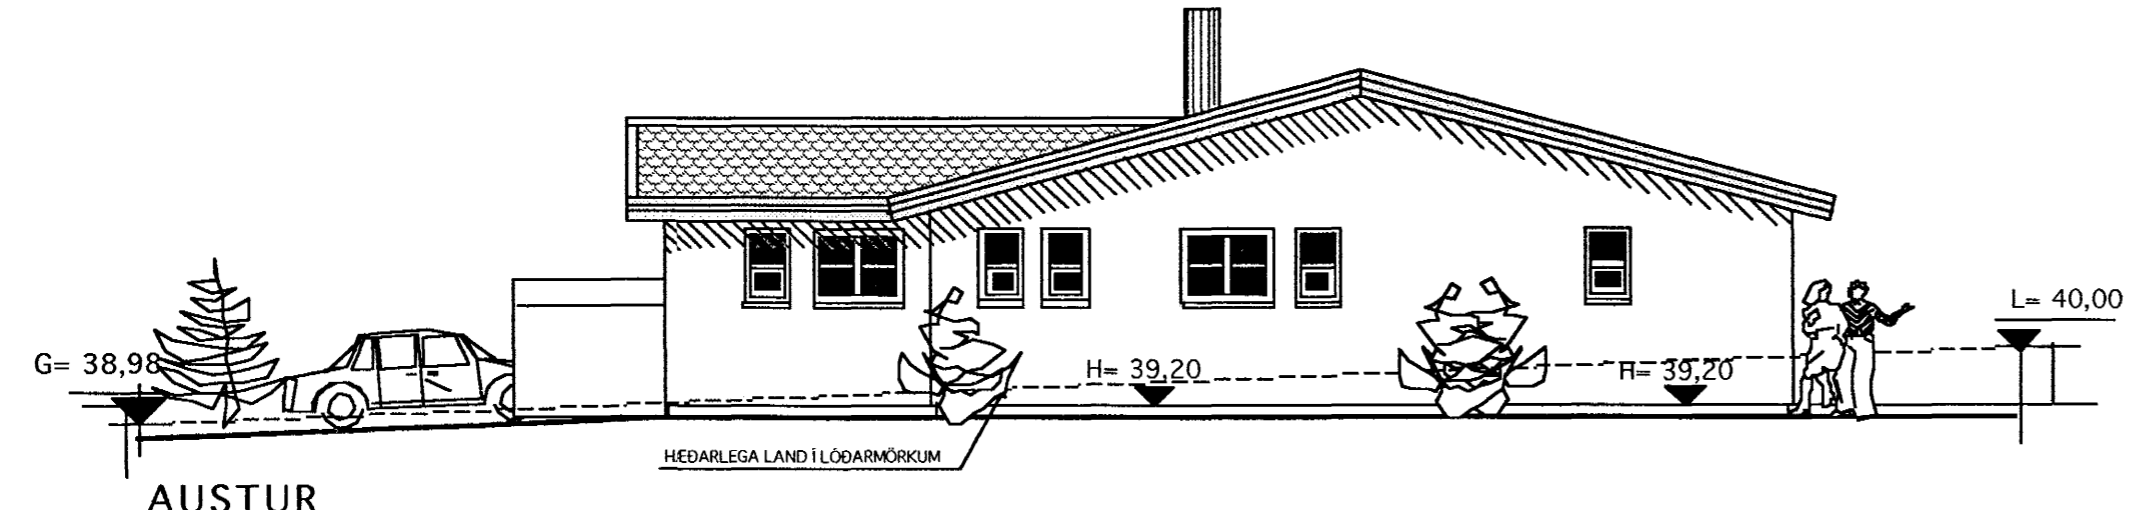

AUSTUR

Skráningartafla: Lóúás 7, Hafnarfirði				Skrásetjari: Konráð Karl Baldvínsson													
Landnúmer: 180427				Kennitala: 15 04 46-7169													
Matshlutanúmer: 01				Útgáfa: 4.01 Dags.: 31.8.1999													
Uppskipting og lýsing				Stærðir													
D0	D1	D2	D3	D4	D5	D6	D7	D8	D9	D10a	D10b	D11	D12	D16	D17		
Lokun	Rými hæð-100	Nofun texti	Höfuð-flokkun	Eignar-hald	Botnfl. m²	Skilfl. m²	Stigi m²	Op m²	Brúfl. m²	Brúfl. sh < 1,8	Salafl. mín	Salafl. max	Brúfl. rúmmál m³	Netfl. m²	Birt fl. m²	Reiknitala skiptarúmmáls	Skiptarúmmál m³
					225,7	0,0	0,0	0,0	225,7	0,0			866,1	197,3	225,7		718,104
													45,1				
					225,7	0,0	0,0	0,0	225,7	0,0			821,0	197,3	225,7		
A	0101	1. hæð íbúð	N	0101	180,3				180,3		2,86	4,39	663,0	157,5	180,3	3,68	579,600
A	0102	Bilgæymsla	B	0101	45,4				45,4		2,86	4,00	158,0	39,8	45,4	3,48	138,504
B	0103	Sorpgæymsla	T	0101	2,3				2,3		1,40	1,65	3,6	3,6			
C	0104	Pallur	U	0101	45,1				45,1								
Athugasemdir																	
Sameignir summa																	
Eignarhald																	
	Eignar-hald	Nofun texti	Birt fl. m²	Skiptarúmmál Skrásetjara og sameign m³													
	0101	Íbúð	225,7	718,104	718,104												
		Alls	225,7	718,104	718,104												

BREYTT 24 MAÍ 2000
 Þak í vestur gaff lengt, steypt súla á suður-vestur horni
 Innréttingum breytt.

TEKNISTOFAN  KVARÐI	Heiti	LÓUÁS 7 HAFNARFIRÐI	kvarði	1:100	verk nr.	9955	
	Verkefni	ÚTLITSMYNDIR SKRÁNINGARTAFLA	dags.	25. ÁGÚST 99	dags. br.	24 MAÍ 00	
			hönnun	G.G.	teikn. nr.		
			teikn	G.G.			A-2

Hringbraut 17-20 Hafnarfirði s. 555-2020 FAX 555-2021
 Gísli G. Gunnarsson B.F. kt. 020649-2409
Gísli Gunnarsson