



Forstofa
 Samþykkt á fundi bygginga-
 nefndar þ. 11. 1. 84
 BYGGINGAFULLTRÚA
 Í HAFNARFIRDI
 E. Jónsson

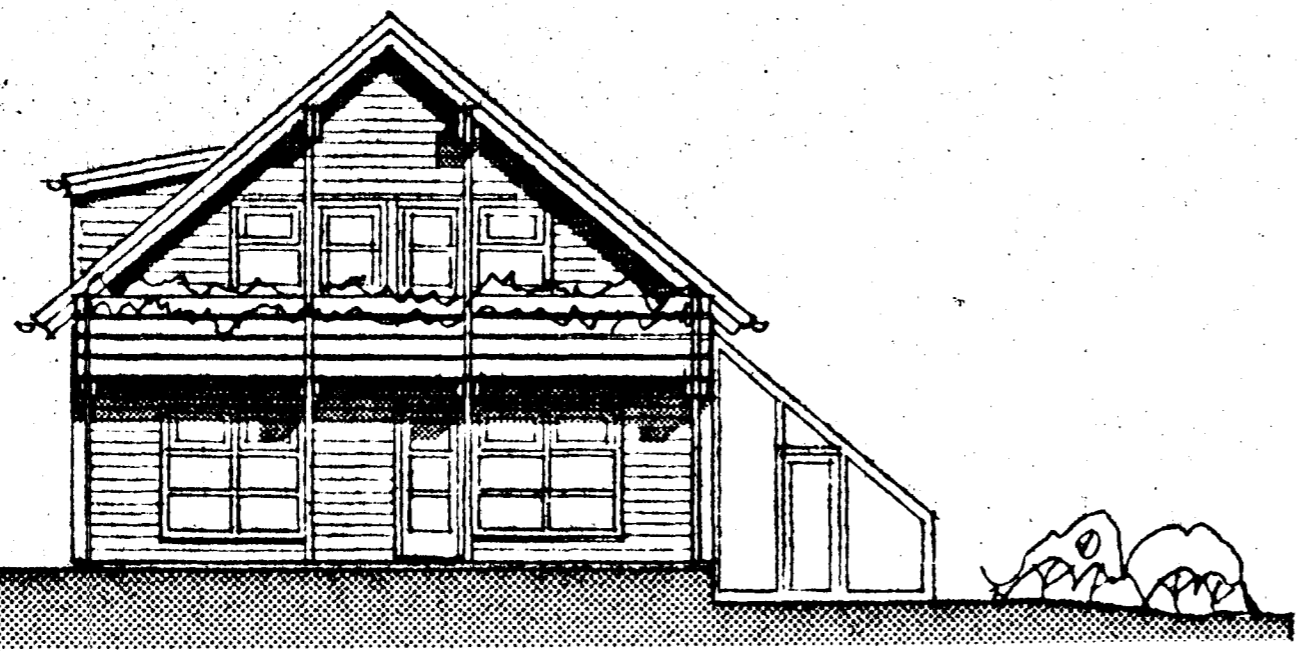


vesturútlit

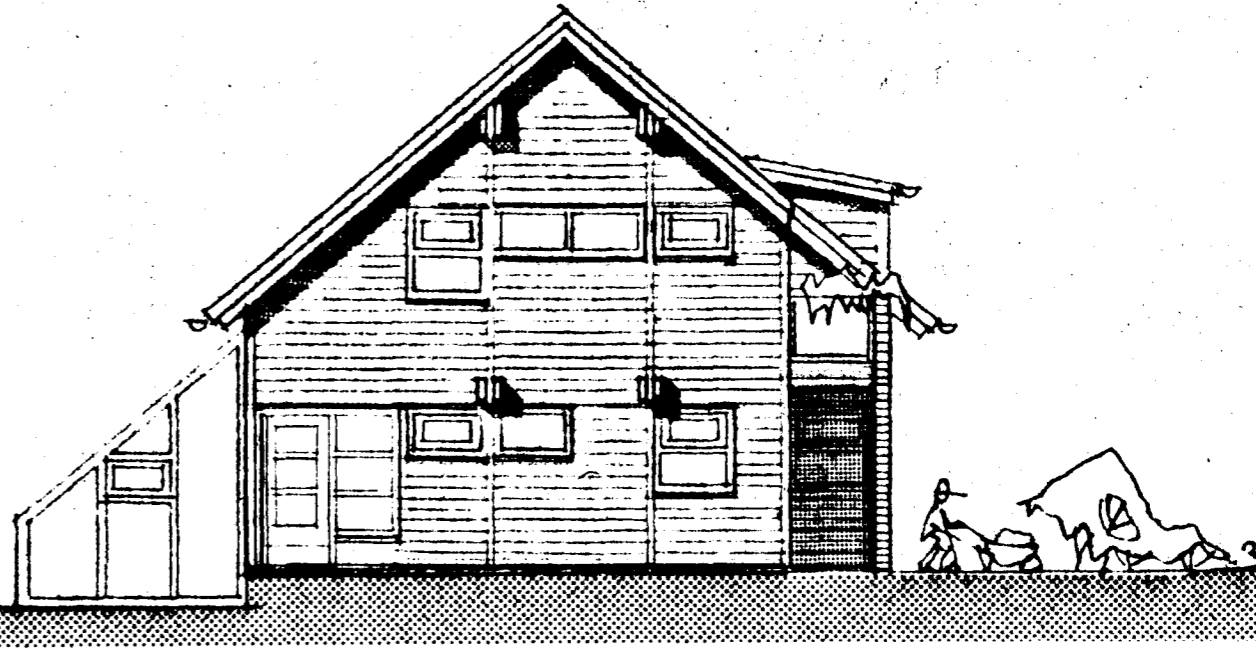


austurútlit

tifftopdf - www.rubissoftware.com - Demo Version

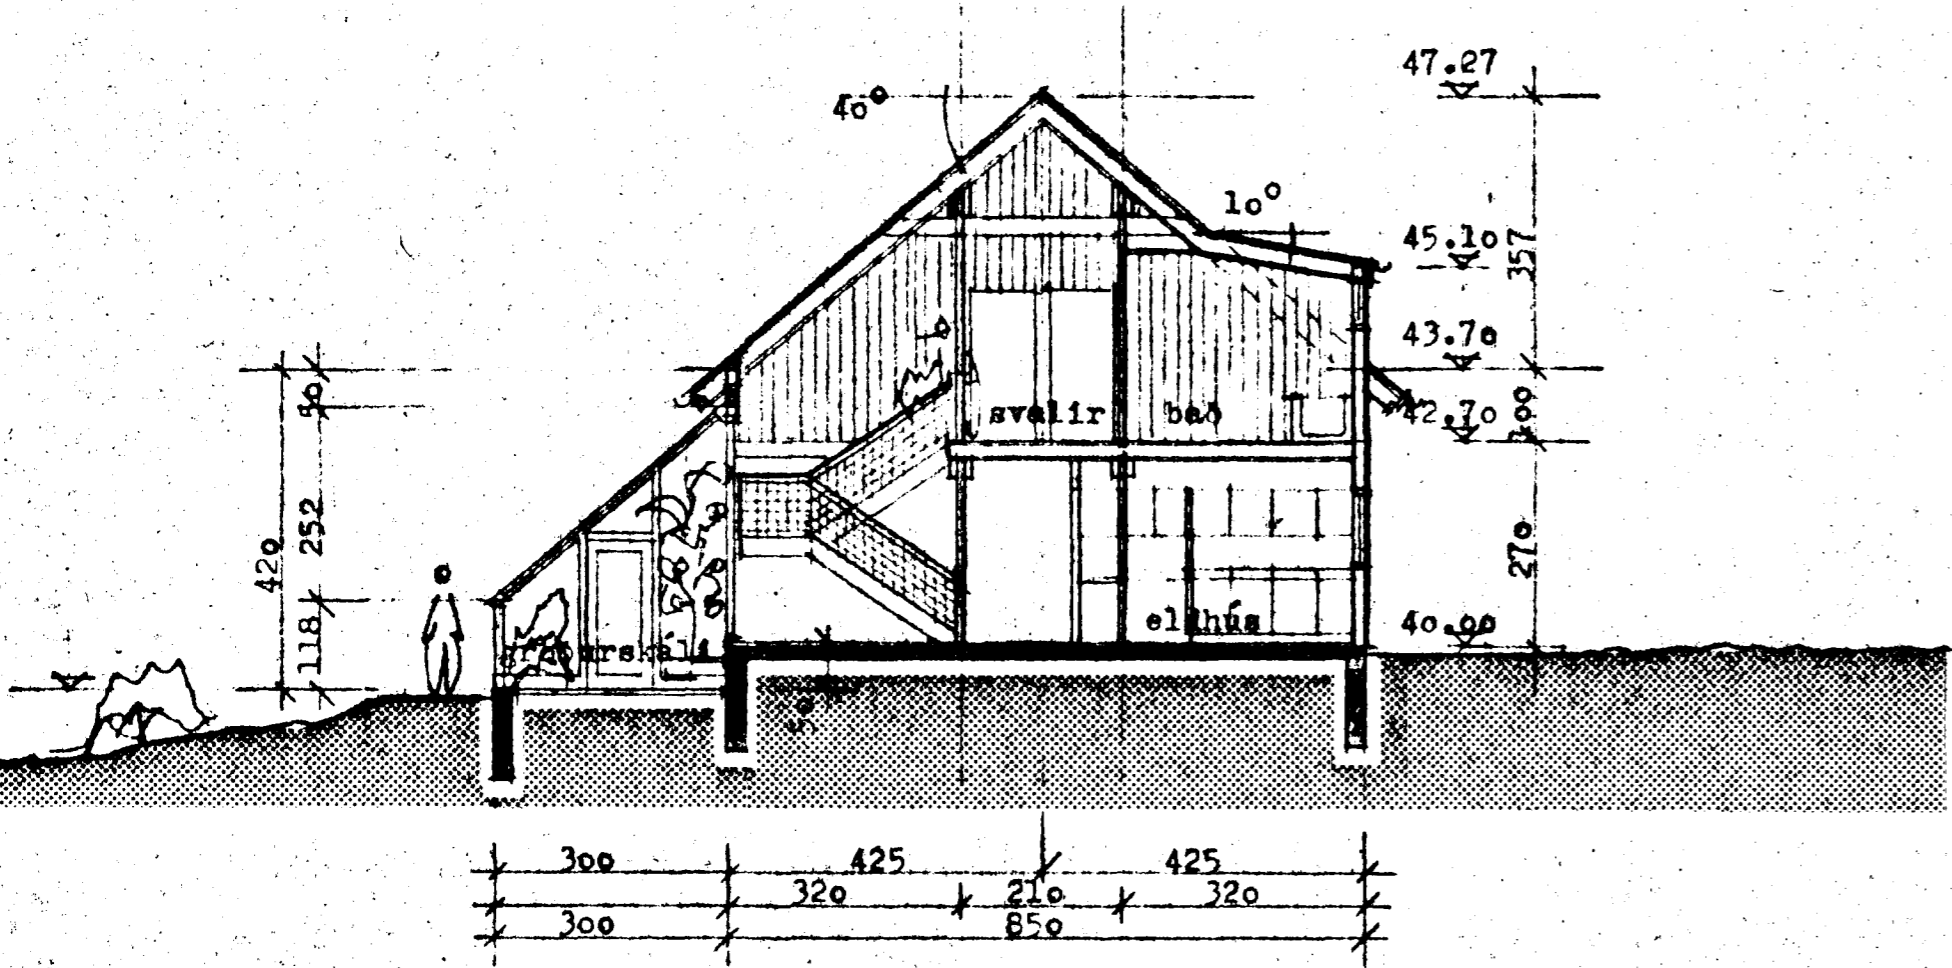

sneiðing A-A

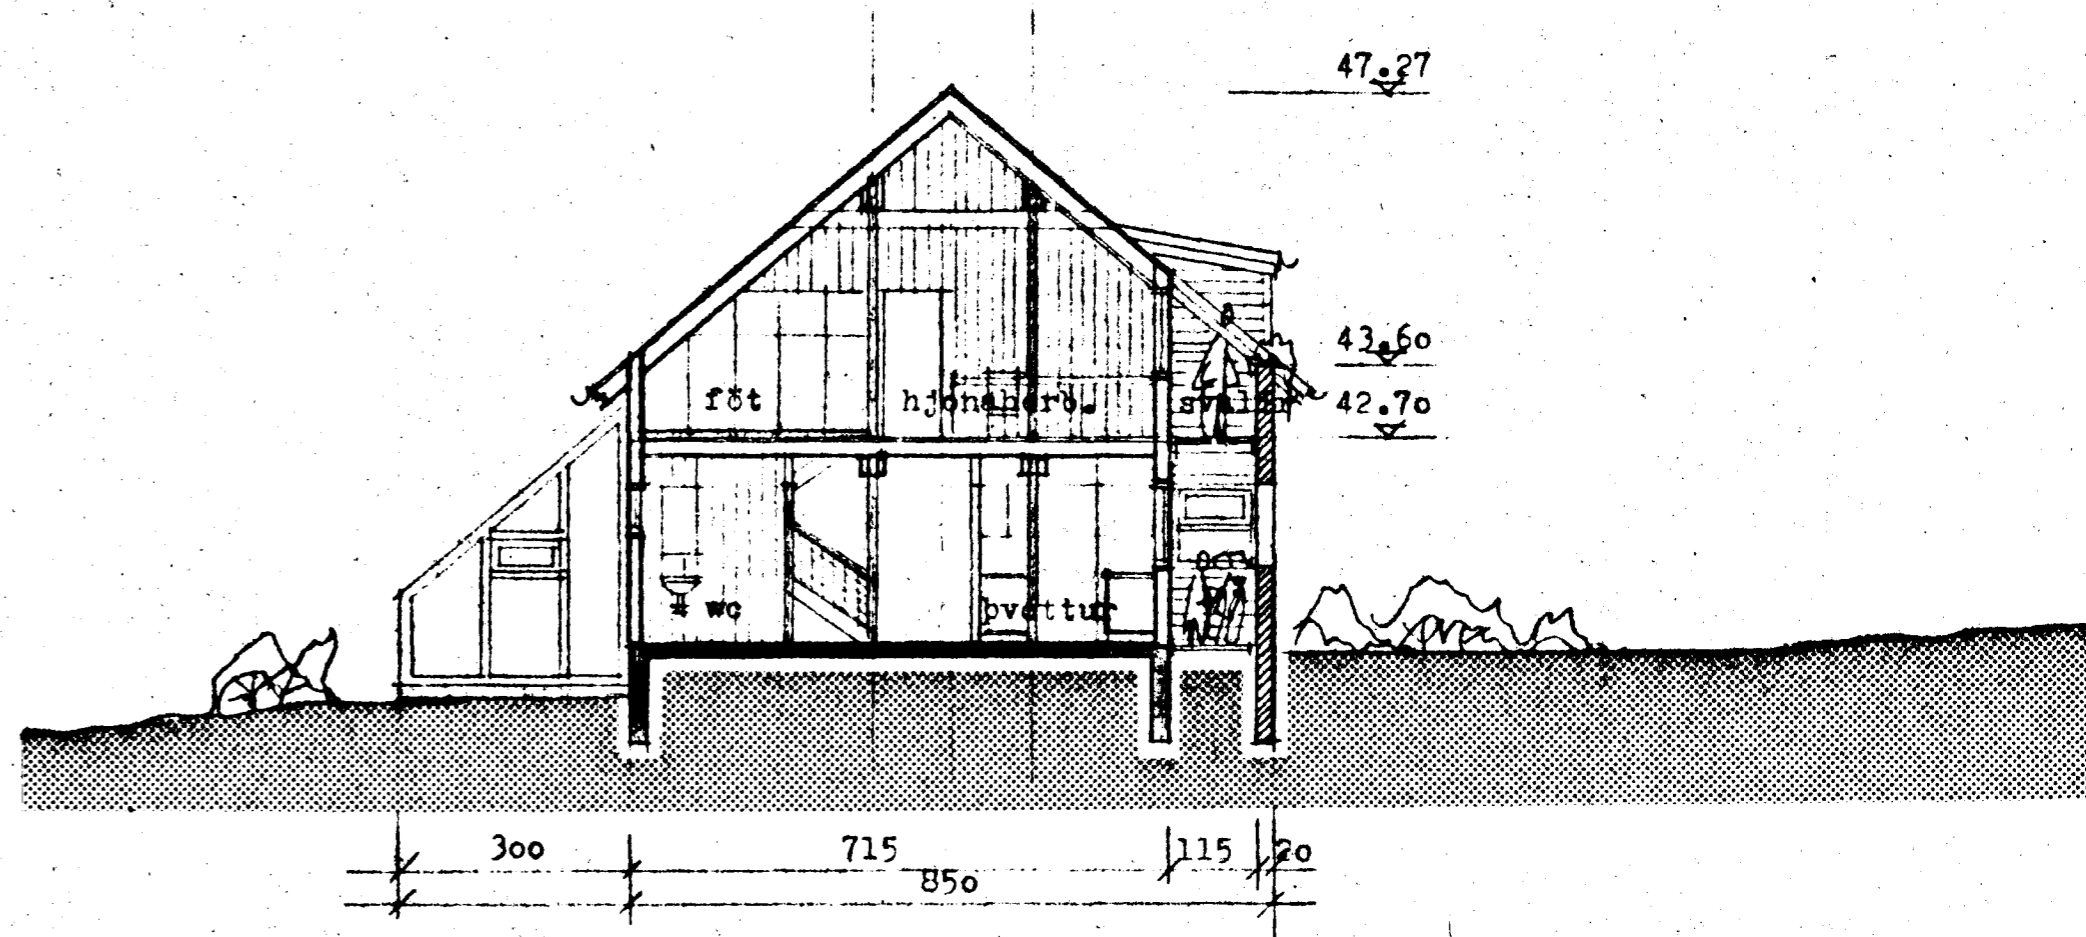

sneiðing B-B

5670-0010-01

forstofu v. aðalgang breytt : 2.04.84

VERK	LYNGBARD 1, Hafnarfirði,	ARKITEKTAR SUBURGÖTU 8
EFNI	útlitsmyndir, sneiðingar,	101 REYKJAVÍK SMÁAR 1911460 - 19124911
MÉLIKVARI	l:lcc	REYNIH ADAMSSON ARKITEKT FAI
DAGS	15.5.83	
TEKNI	FA	
VERK - TEKNI NR		