




GRUNNMYND 1:50

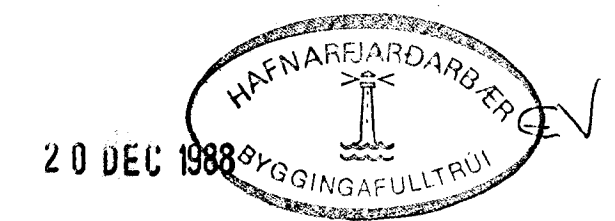

01	112 '88	ÖFN NR. 108 OG 110 STEKKADIR.	
BR. NR.	DAGS	EDLI BREVTINGAR	SIGN.
LYNGBERG I HAFNARFIRDI			DAGS SEPT '88
HITA- OG VATNSLAGNIR. GRUNNMYND.			HANNA
			TEIKNAD
			VERK NR. 8825
MELIKV. 1:50			BLAD NR.
SIGURÐUR ÞORLEIFSSON TEKNIFRÆÐINGUR F.T.F.I.			2-03
STRANDGÖTU 41 HAFNARFIRDI SÍMI 54751			