


LYNGBERG 21

Ø 50 HITAPOLIN PLASTPÍPA (FRÁRENSLI HITAYI)

Ø 100 PL. REGNTJARDVATNSLÖGN 10%

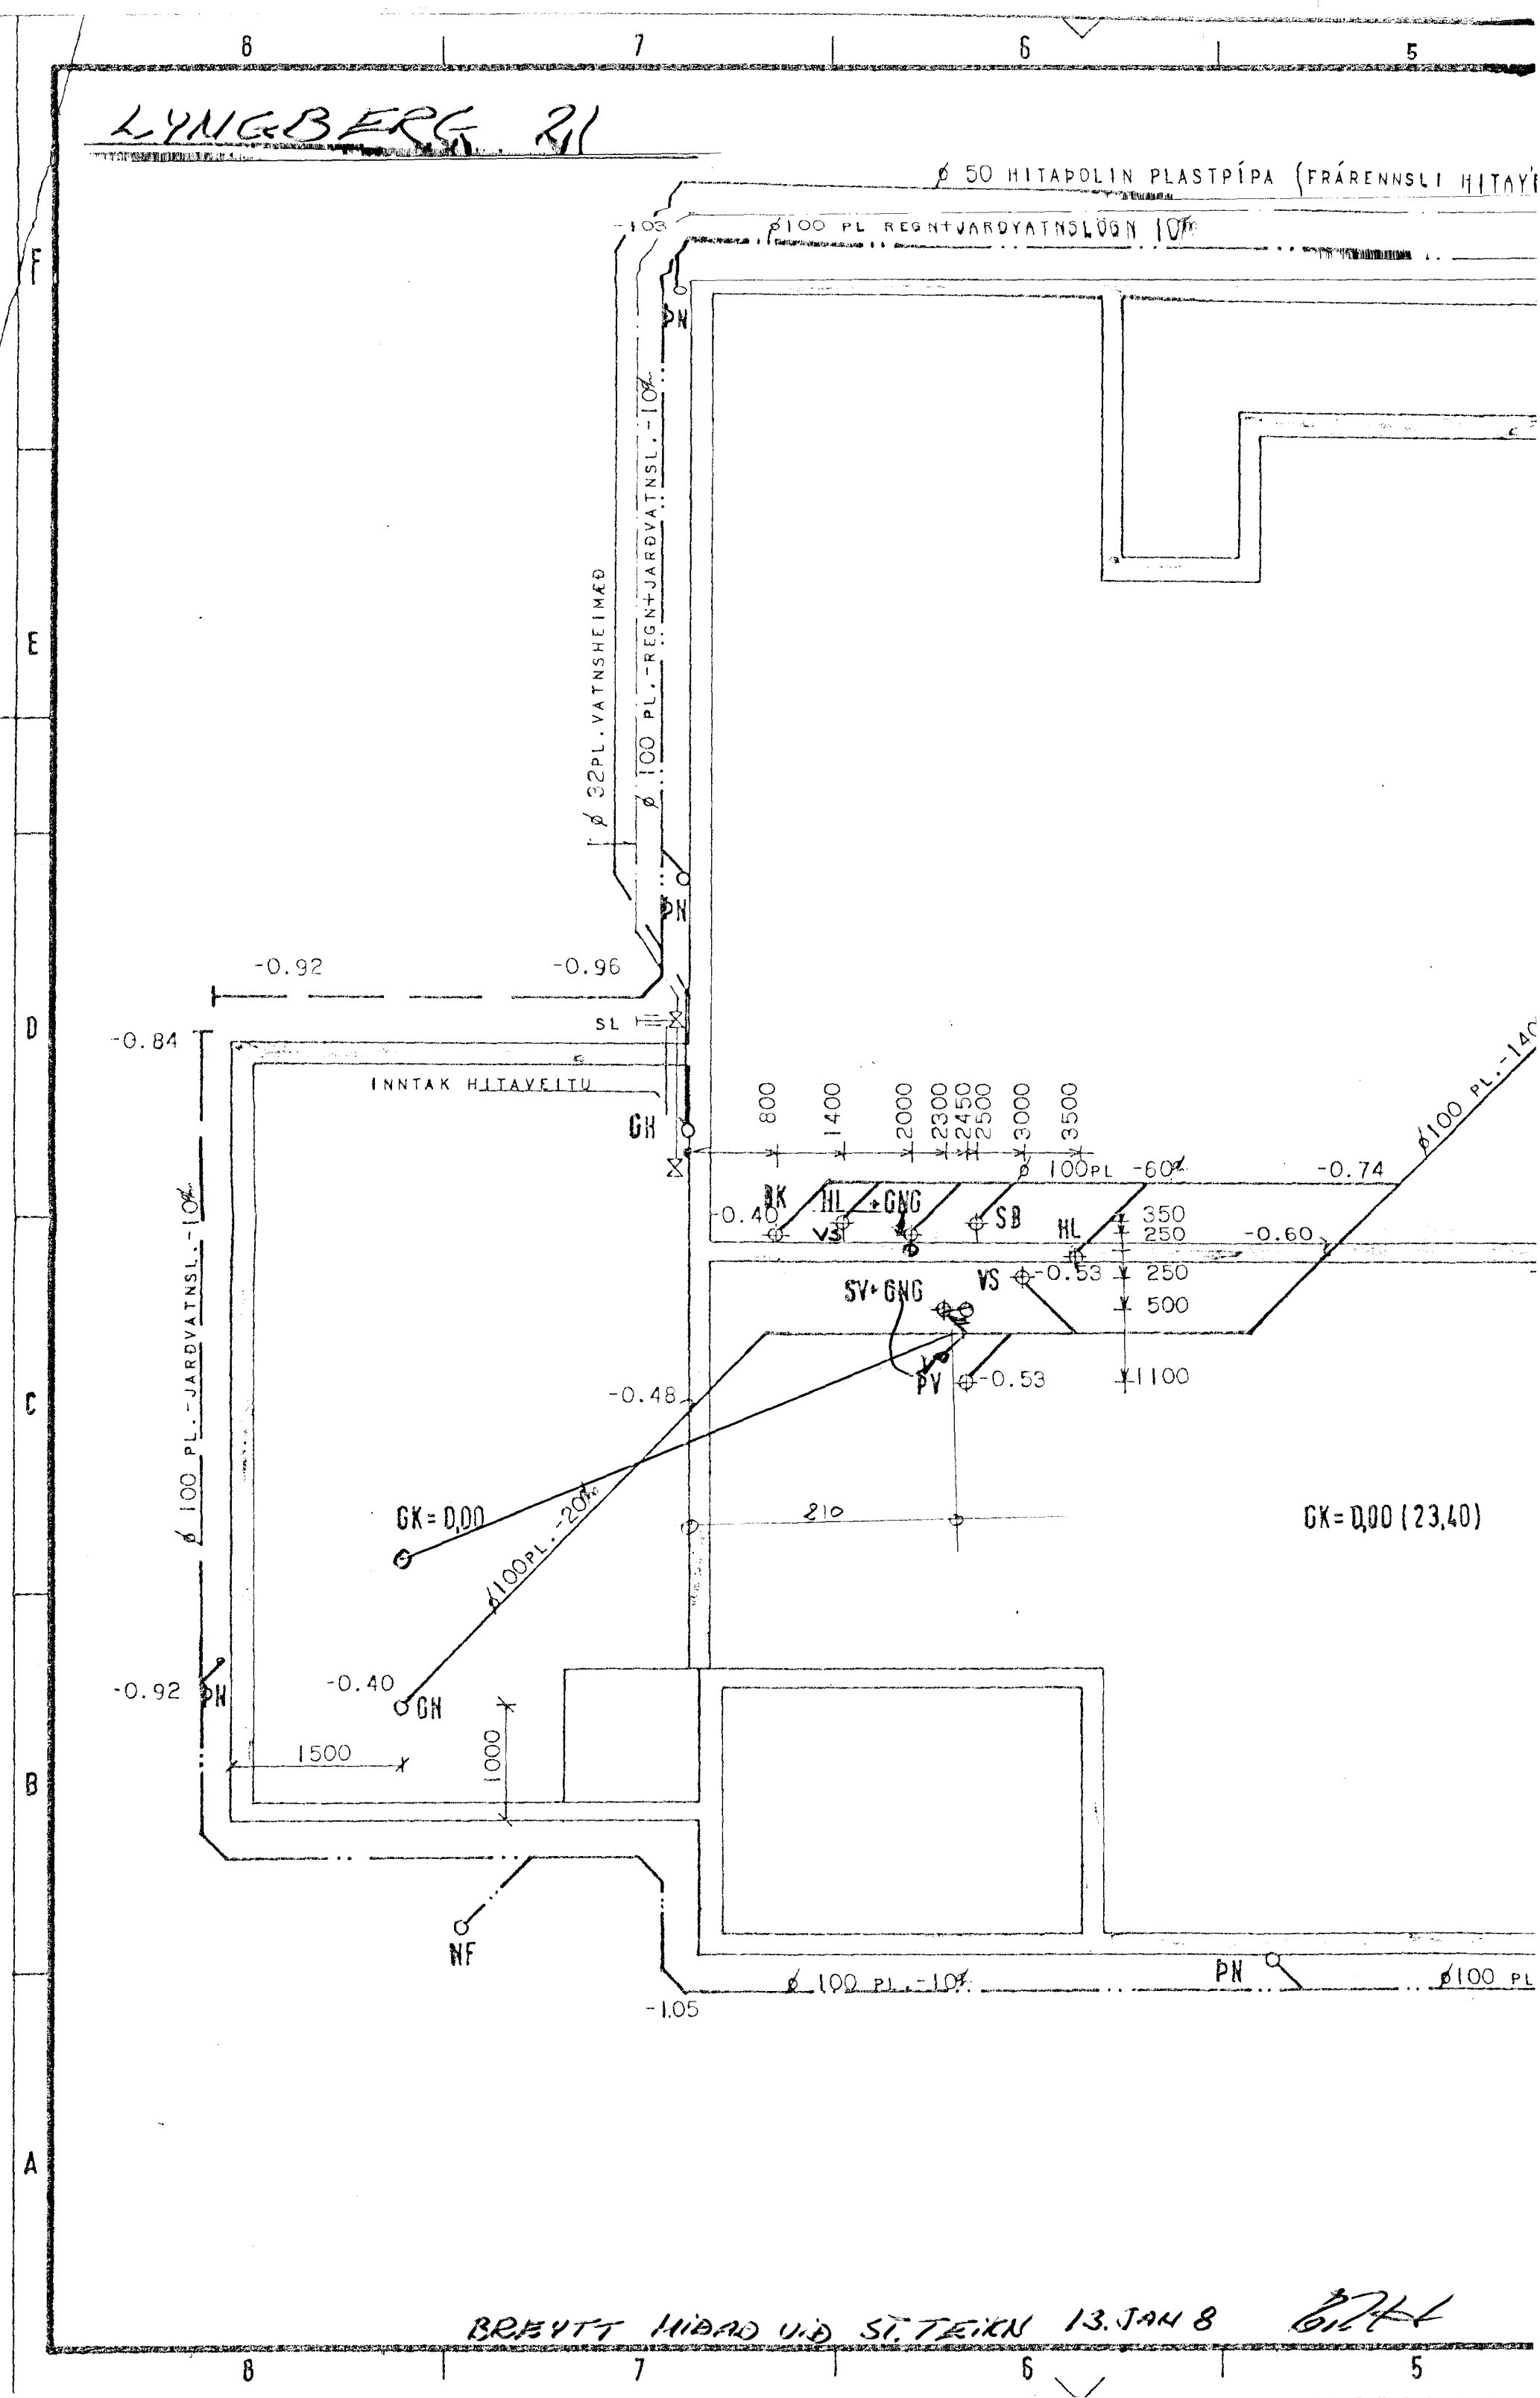

BRÉYTT MÍÐAD VÍÐ ST. TEIKN 13. JAN 8 *[Signature]*