


GRUNNMYND 1:50

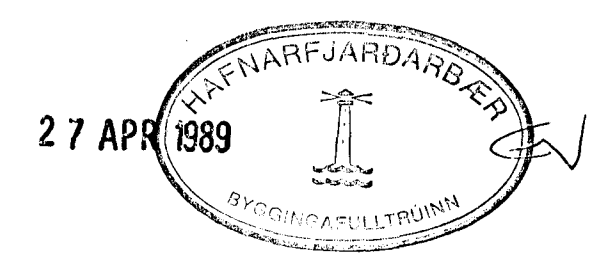

DS	19.04.89	LAGNIR FERÐAR	86
LR	02.03.89	LEGGU LAGNA BRESITT	86
DI	16.01.89	VERKT TIL 7 BAÐH.	86
BRNK	DAGS	EDLI BREVTINGAR	SIGN.
LYNGBERG 33 HAFNARFJARDI			DAGS 'AGÓST '88
GRUNNMYND HITR OG VATNSLAGNA.			HANNA
MÆLIKV. ALÍSO			TEIKNINGAR
SIGURÐUR ÞORLEIFSSON TEKNIFRÆÐINGUR F.T.F.T.			VERK NR 8738
STRANDGÖTU 11 HAFNARFJARDI SÍMI 54751			BLADNR 2-03