


RÚMMYND 1:50

27 APR 1988

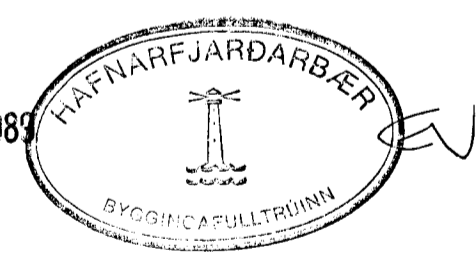

| | | | |
|--|----------|------------------|----------------|
| 01 | 19.04.87 | LEIÐ LAGNA | |
| 02 | 12.03.87 | LEIÐ LAGNA BÍEFT | |
| 03 | 16.01.87 | TENGINGUM, ER. | |
| BR. NR. | DAGS | EDLI BREVTINGAR | SIGN. |
| LYNGSBERG 33 HAFNARFIRÐI | | | DAGS AGÚST '88 |
| RÚMMYND HITLAGNA. | | | HANNAÐ |
| MELIKV. 1:50 | | | TEIKNAD |
| SIGURÐUR ÞORLEIFSSON TEKNIFRÉÐINGUR F.T.F.I. | | | VERK NR 8738 |
| STRANDGÖTU 11 HAFNARFIRÐI SÍMI 54751 | | | BLAD NR 2-04 |