


RÚMMYND 1:50

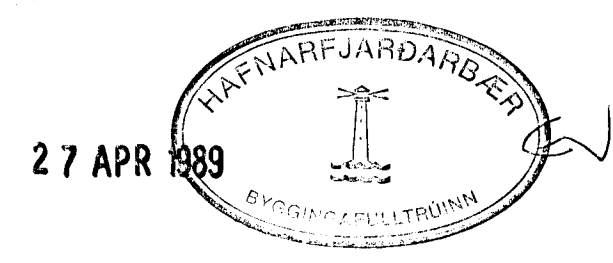

BR NR	DAGS	EDLI	BREYTINGAR	SIGN
D2	19.04.89	LEGLI	LAGNA KR	
D1	16.01.89	FÆRT	TIL 1. BÆRERS.	
LYNGBERG 33 HAFNARFJÖRÐI				DAGS
RÚMMYND VATNSLAGNA.				AGÚST'88
MÆLIKV. 1:50				HANNA
SIGURÐUR ÞORLEIFSSON				TEIKNAR
STRANDGÖTU 11 HAFNARFJÖRÐI SÍMI 54751				VERK NR
				873B
				BLAD NR
				2-05