


RÚMMYND HITALAGNA ~1:50

SKÝRINGAR SJÁ BL. NR. 1 OG 6
OFNATAFLA SJÁ BL. NR. 6

BREYTING ① AG. 89: GÓLFHITI OFL.

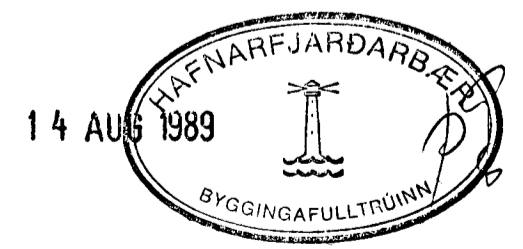

KRISTJÁN KNÚTSSON
TÆKNIFRÆÐINGUR TTFI 5 651647

LYNGBERG NR. 35 HAFNARFIRÐI	DAGS MAI 88 MKV ~4:30
RÚMMYND HITALAGNA	BL. 4 AF VERK BT1-02
HITA- OG HREINLÆTISLAGNIR.	