


RÚMMYND VATNSLAGNA ~ 1:50

SKÝRINGAR SJA BL. NR. 1

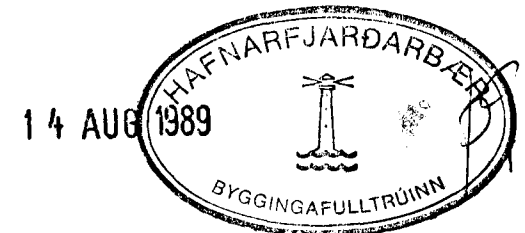

KRISTJÁN KNÚTSSON	
TÆKNIFRÆÐINGUR FTFÍ	S 051647
LYNGBERG NR. 35	DAGS MAÍ '88
HAFNARFIRÐI	MKV ~ 1:50
RÚMMYND VATNSLAGNA	BL 5 AF
HITA- OG HREINLÆTISLAGNIR.	VERK 871-02

BREYTING ① AGÚST 89: GARDVATN OFL.