
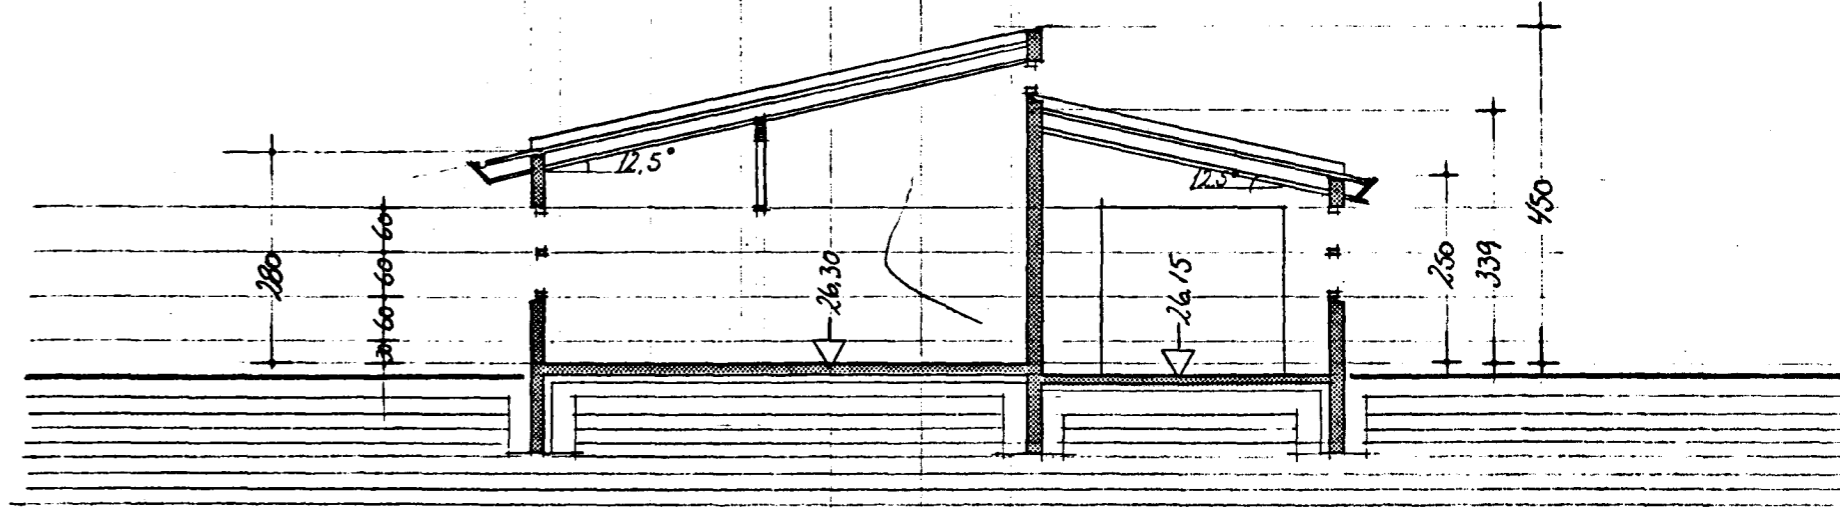
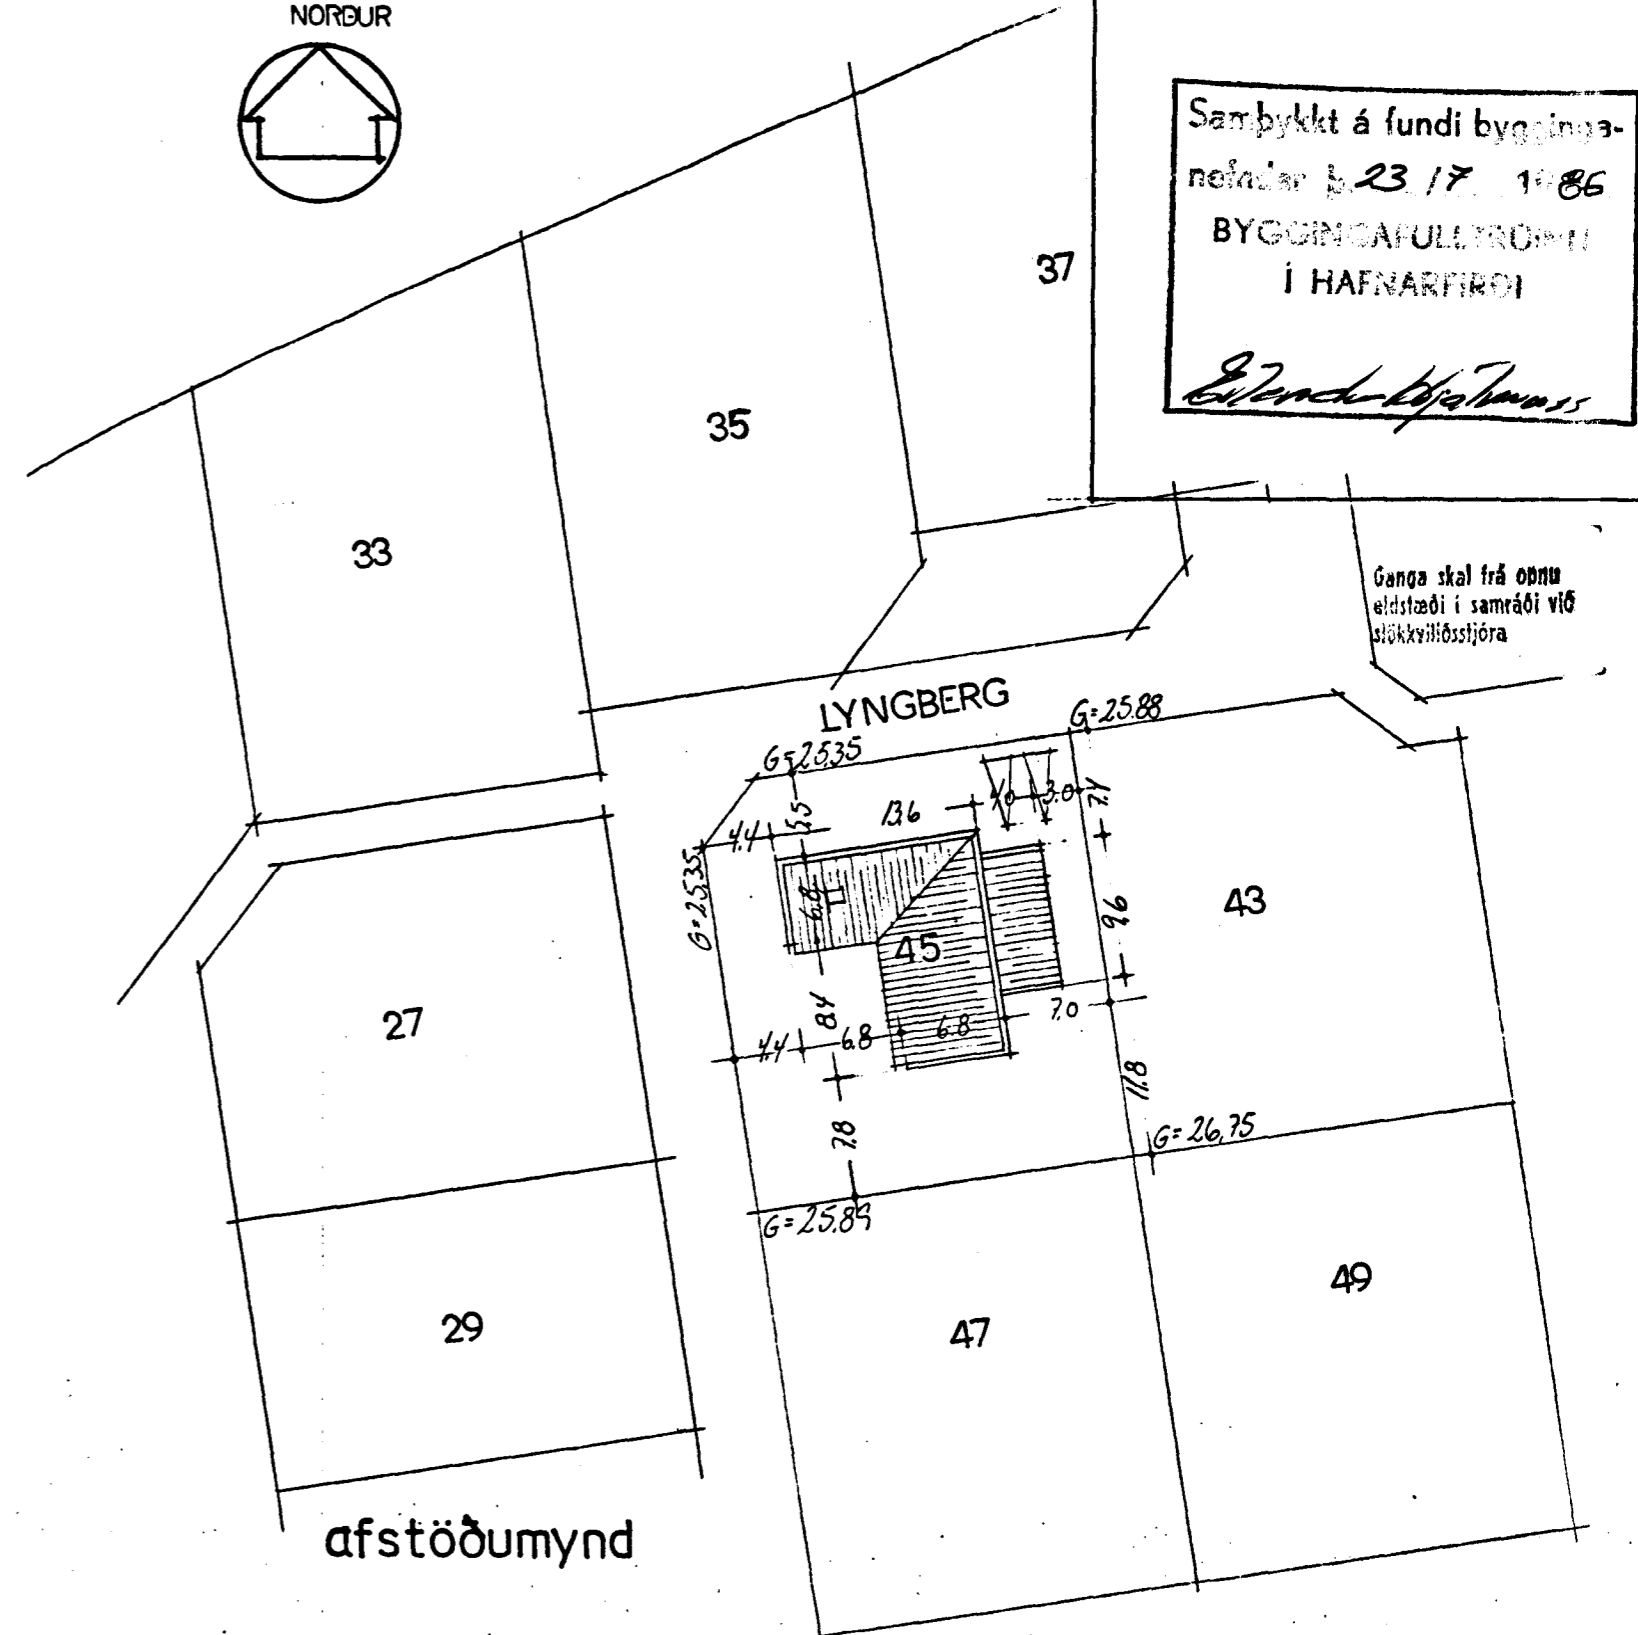


Samþykkt á fundi bygginga-
nefndar þ. 23/7. 1986
BYGGINGAFULLTRÖGNI
Í HAFNARFIRDI
Eldur Björnsson

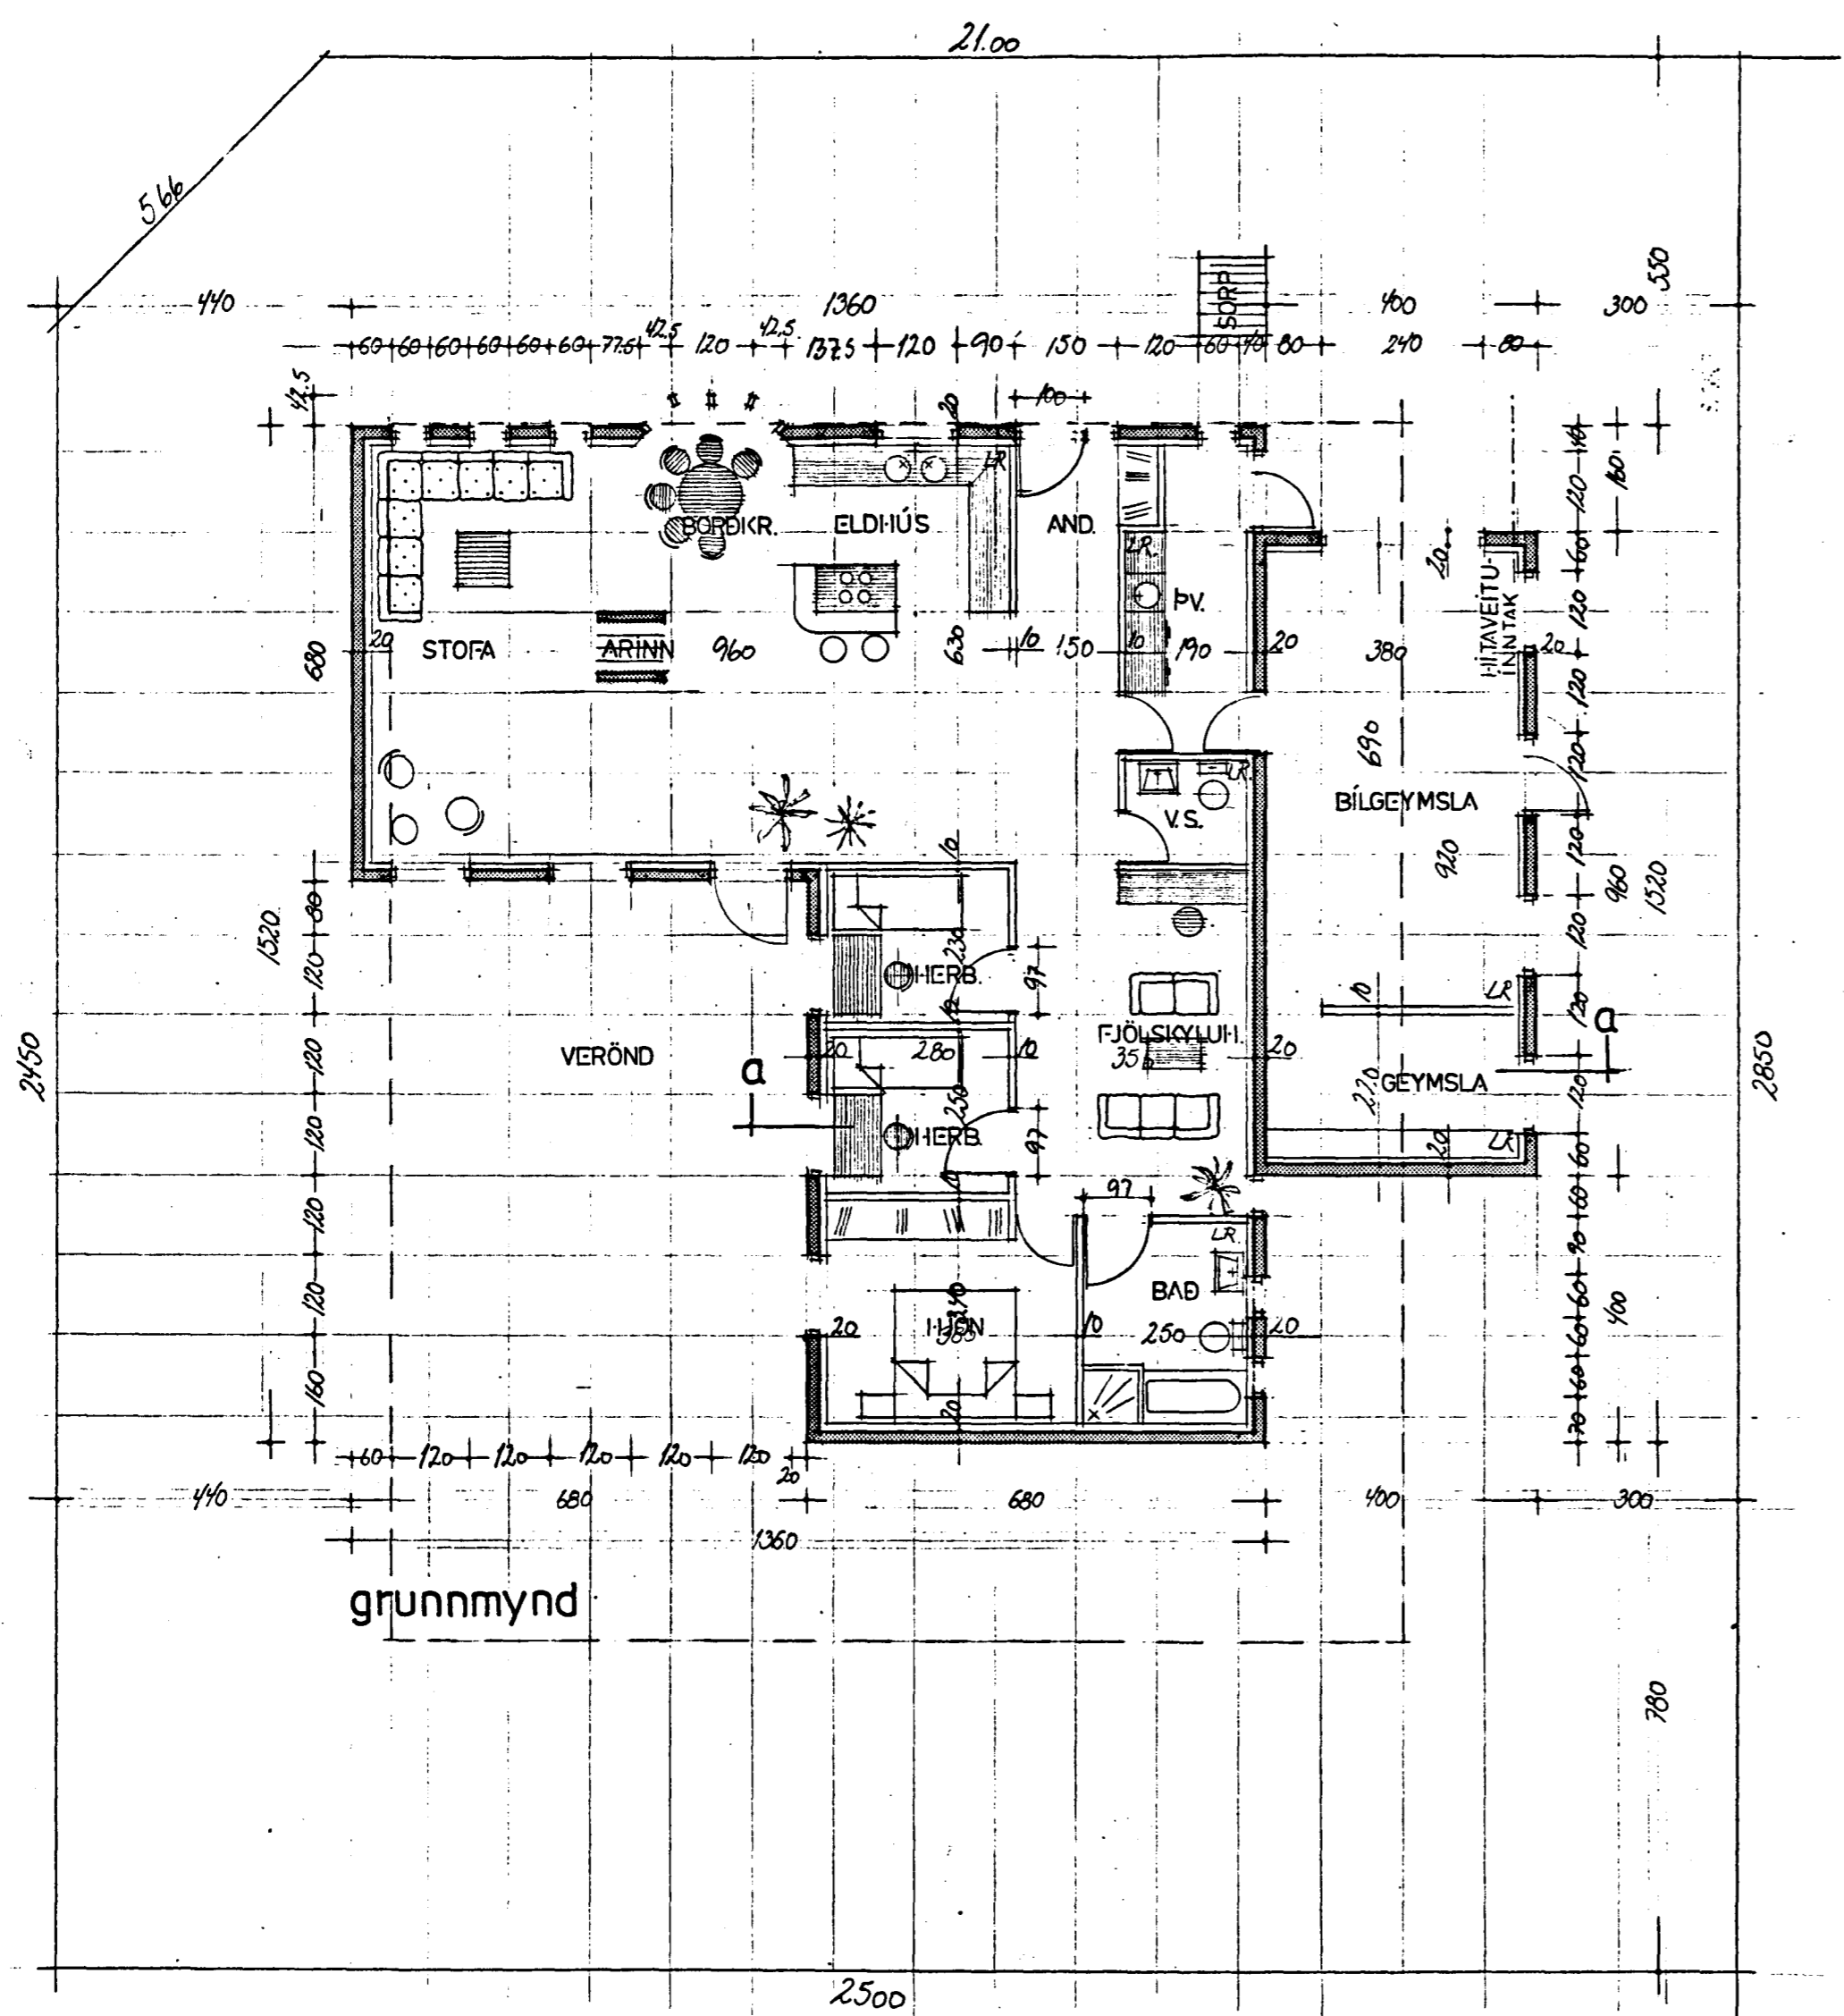

sneiðing a-a

| | |
|----------------------|----------------------|
| FLATARMÁL HÚSS | 149,6 m ² |
| FLATARMÁL BÍLGEYMSLU | 38,4 m ² |
| FLATARMÁL ALLS | 188,0 m ² |
| FLATARMÁL NETTO | 138,2 m ² |
| FLATARMÁL LÖÐAR | 704,5 m ² |
| NYTINGARHLUTFALL | 0,27 |

BR '86-06-26. GLUGGAR, HURÐIR, SKORSTEINN

LYNGBERG 45

GRUNNMYND AFSTÖÐUMYND SNEIÐING
MKV. 1:100 1:500

DAGS '86-4-6.

teiknistofan skólavörðustfg 16

ts 16

s. 23325

Gísli Gíslason Valdimar & Guðmundsson