
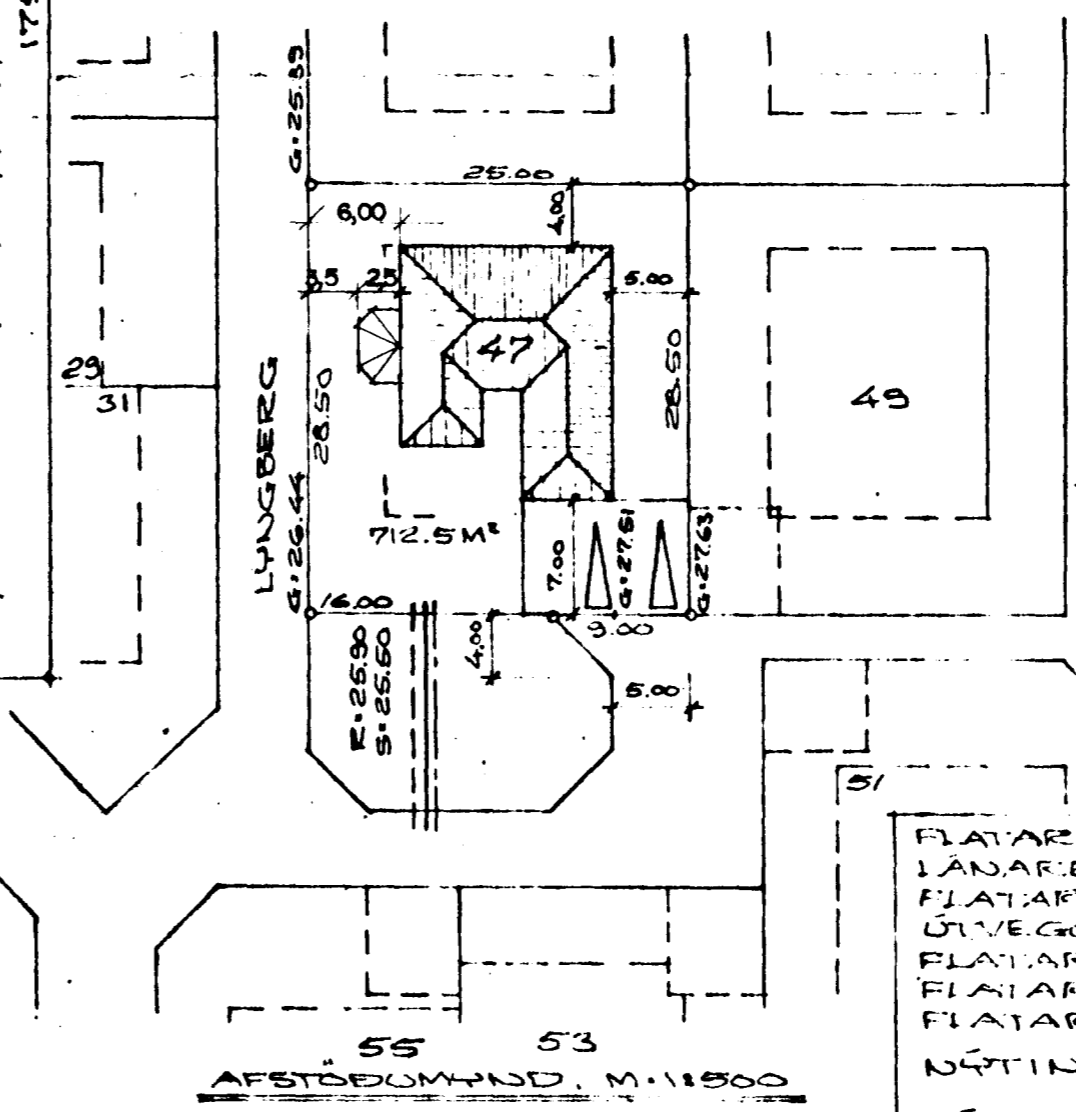
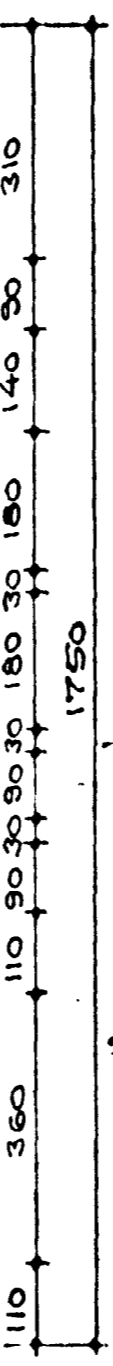
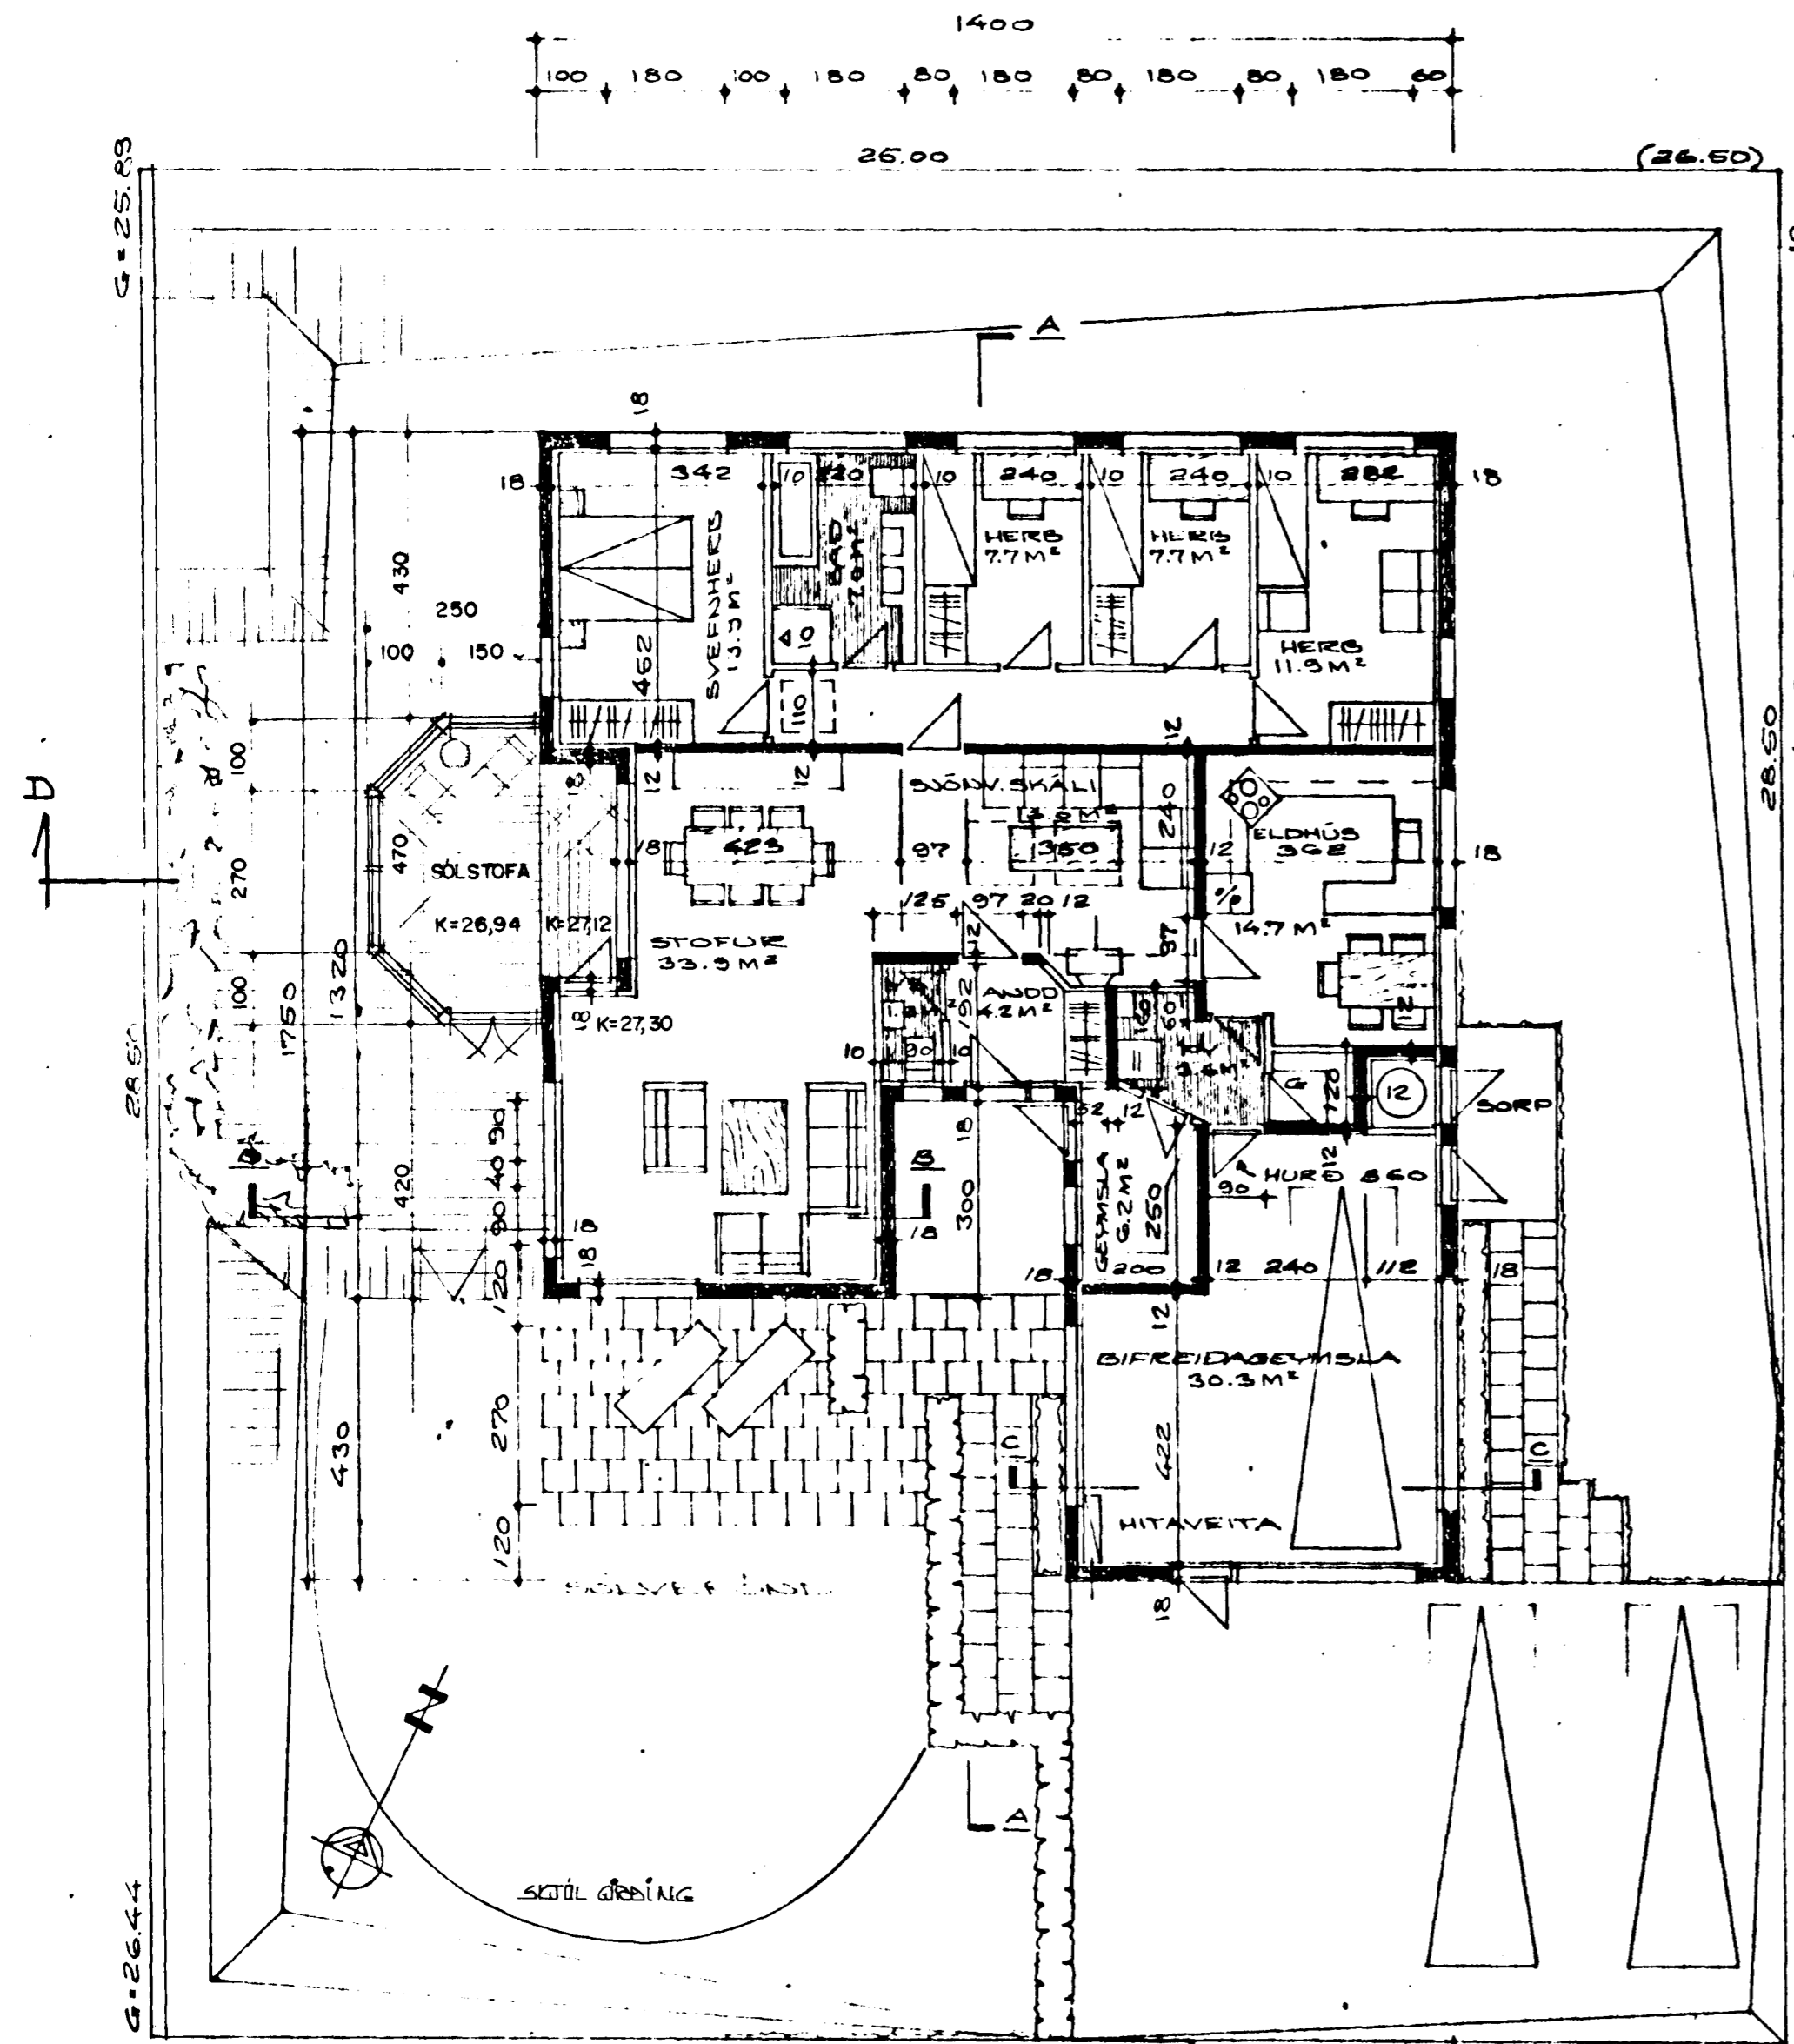
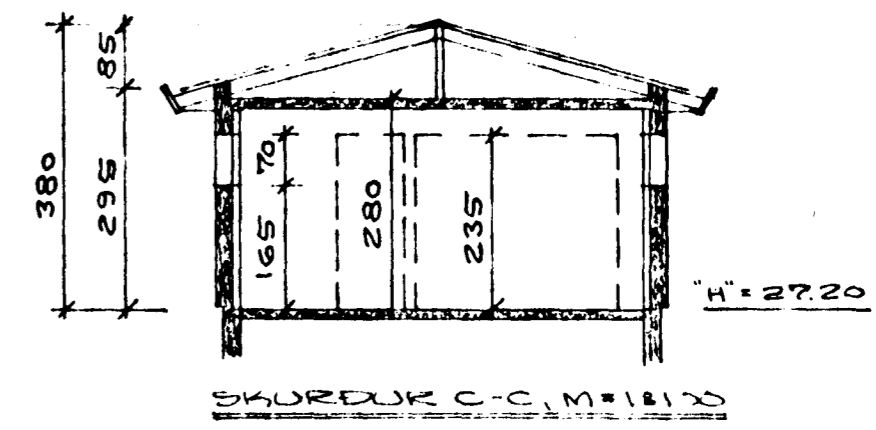
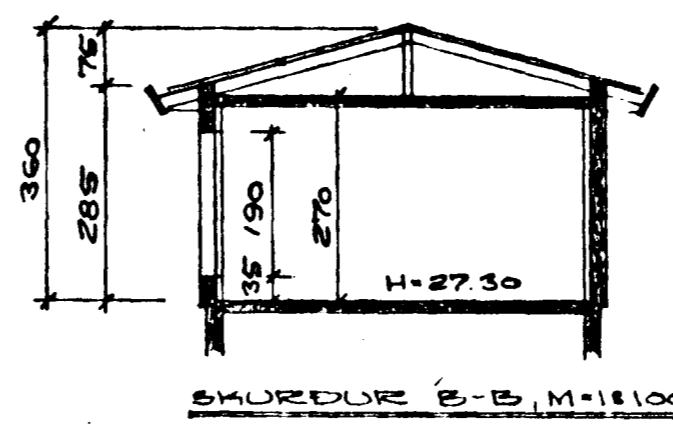


Samþykkt á fundi bygginga-
nefndar þ. 7.19.1985
BYGGI'GAFULLTRÚINN
Í HAFNARFIRDI
Þór Jónsson.

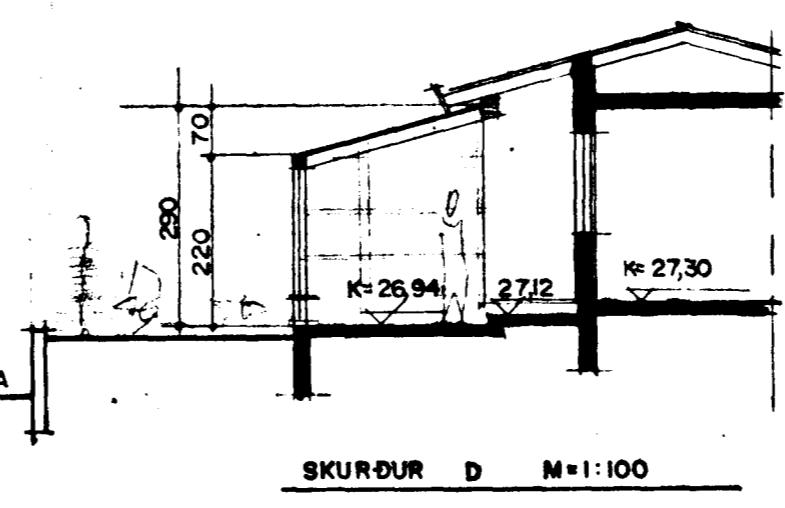

FLATARMÁL TEGUNARHÚS: 149,5 M² NETTÓ, MIÐDAG VÍÐ
LÁNARREGLUP HÖRÐAÐA HÚSA (ÚTVEGGJAR: 20CM)
FLATARMÁL TEGUNARHÚS: 143,3 M² NETTÓ, MIÐDAG VÍÐ
ÚTVEGGJAPÞYKKT 30 CM.
FLATARMÁL TEGUNARHÚS: 153,5 M² BRÚTTÓ
FLATARMÁL BÍRFRIDAGEYMSLUS: 30,5 M² NETTÓ (30CM)
FLATARMÁL BÍRFRIDAGEYMSLUS: 36,5 M² BRÚTTÓ
NÝTINGARHLUTAFALL: $\frac{143 + 30,5}{712,5} = 0,244$
NÝTINGARHLUTAFALL: $\frac{159 + 36,8}{712,5} = 0,275$
NÝTINGARHLUTAFALL: $\frac{149}{712,5} = 0,21$


KÖLNUÐARTÖLUR
GÖLF: 0.3 W/M²°C
ÚTVEGGIR, VEGID MEDALTAL: 0.8 W/M²°C
KAM: 0.2 W/M²°C

BREYTT Í HEFDBUNÐID STEINHÚS 1.8.1985
SÖLST TÍÐU Í SEPT 87 ERL. HJÁLA. D.F.

14,7 M² 380 M²

LYNGBERG NR. 47
HAFNARFIRDI Í APRÍL 1985
ARNARHRAUNI 47, 651412-50587

Ólafur Magnússon

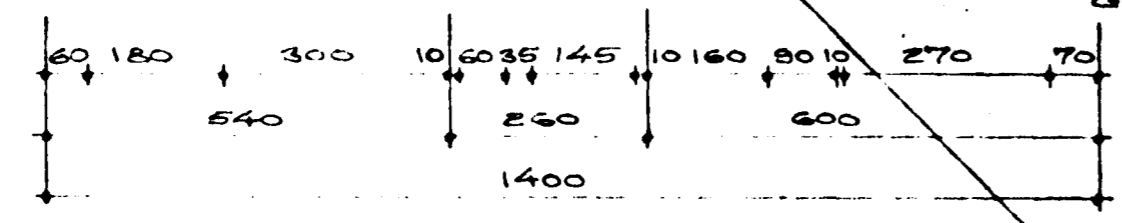

GRUNDMÁLND, M=1:100