


RÚMMYND 1:50

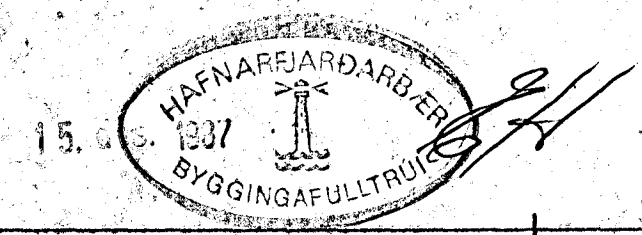

BR. NR.	DAGS.	EDLI BREVTINGAR	SIGN.
01	27.03.'37	ÖFN 110 FERÐUR. III LEKADUR. LÖGNUM ÖR. AD III	20.
LYNGBERG 51. HAFNARFIRÐI			DAGS. SEPT. '37
RÚMMYND HITALAGNA			HANNA
MELIKV. 1:50			TEKINGA
SIGURÐUR ÞORLEIFSSON TEKNIFRÆÐINGUR F.T.F.I.			VERK NR. 8721
STRANDGÖTU 11. HAFNARFIRÐI SÍMI 34731			BLADNR.