



Sambýkt á fundi bygginga-
nefndar þ. 2.11. 1986
BYGGINGAFULLTRÚINN
Í HAFNARFIRDI


Eldur Hjort

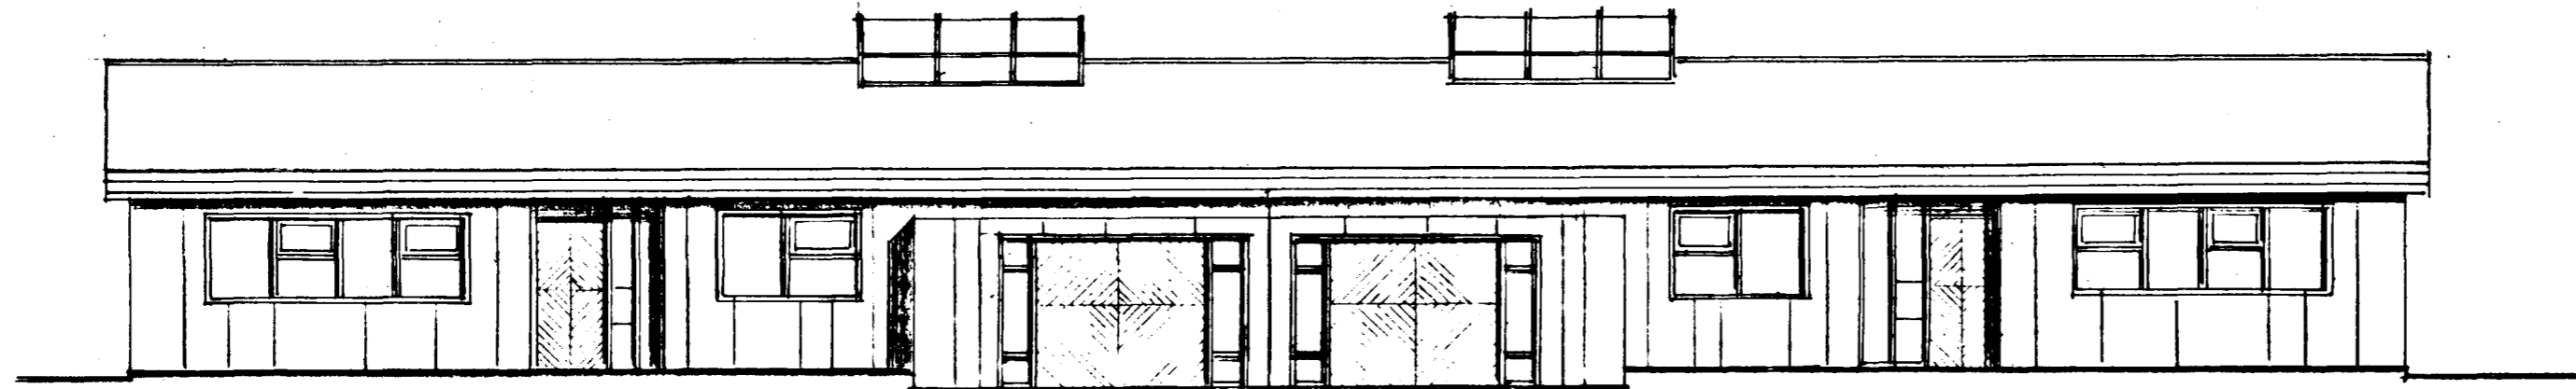


NORDUR

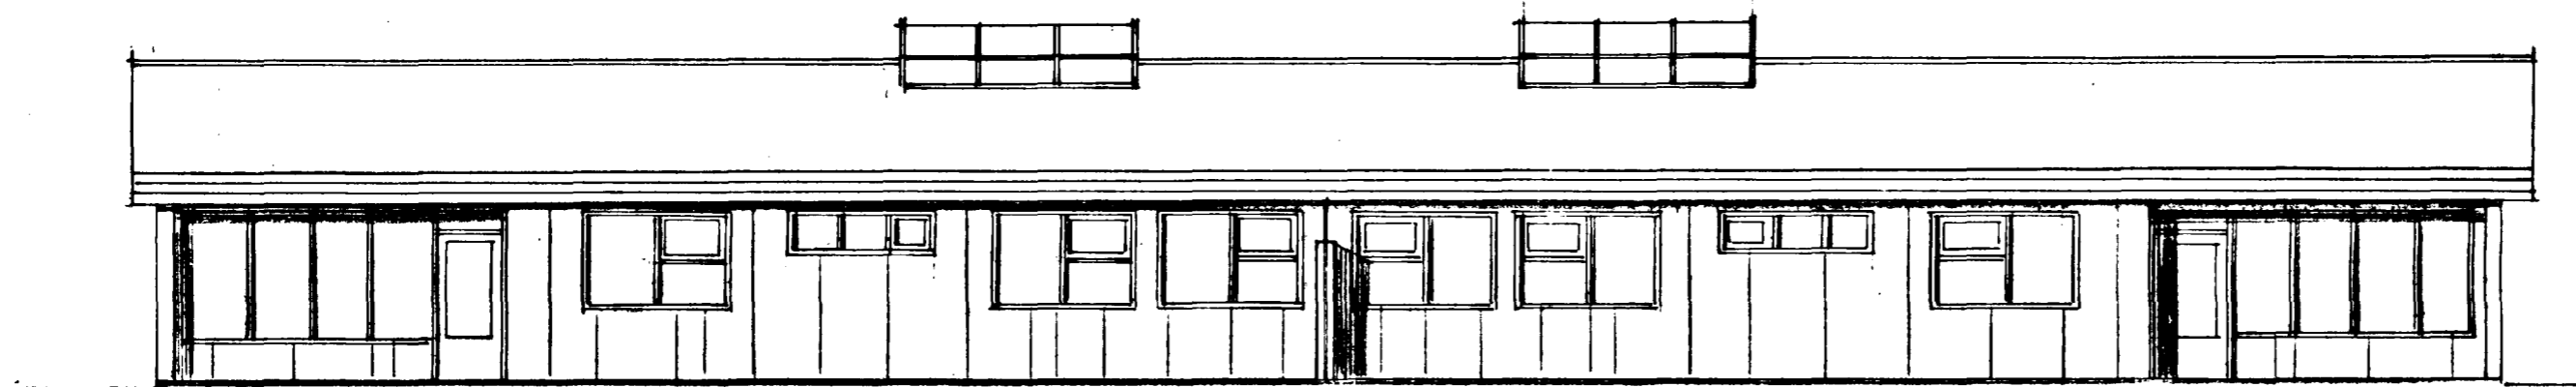

SUDUR

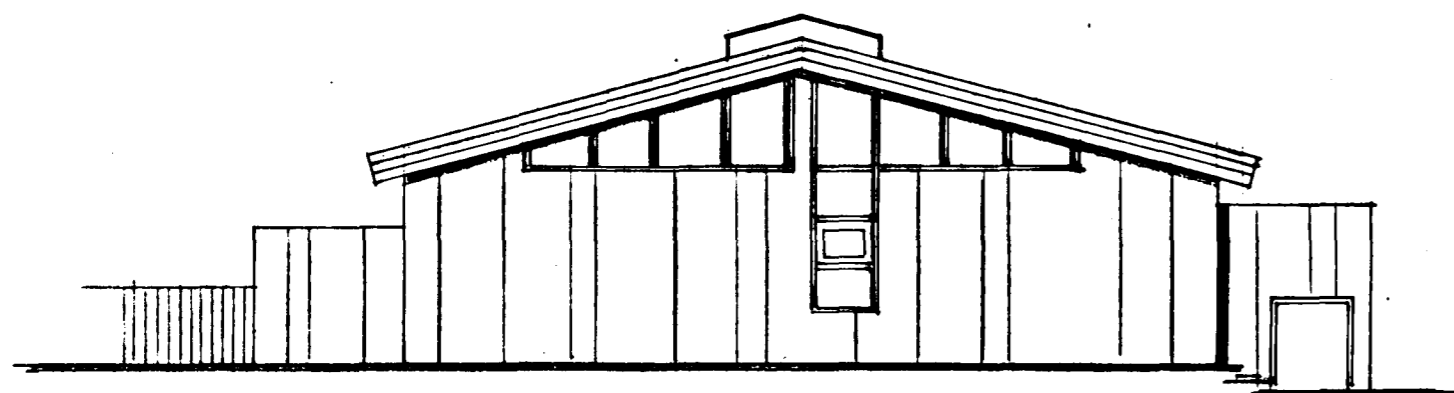

AUSTUR

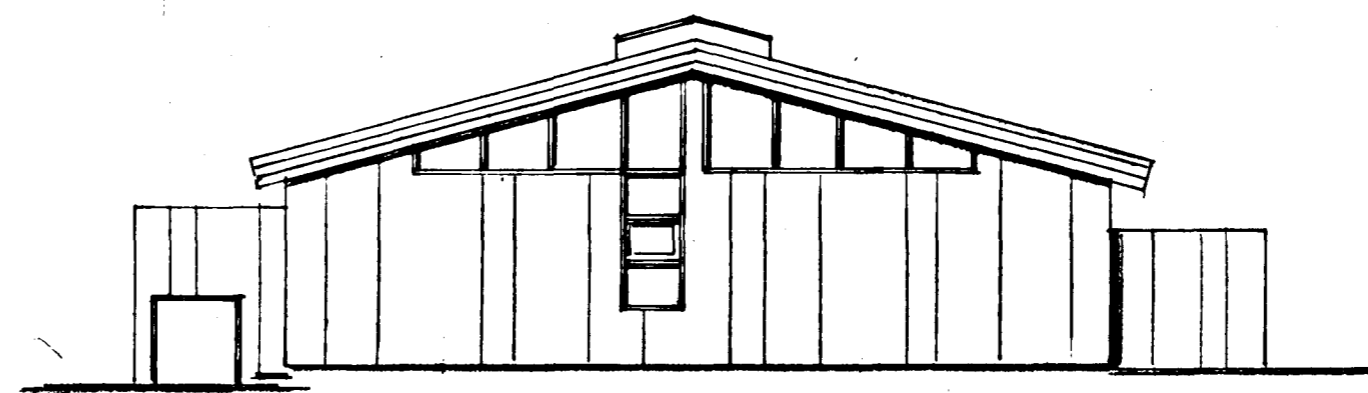

VESTUR

		LYNGBERG 53-55	
		HAFNARFIRDI	
19.8.86		GLUGGAÞREITING.	
BR.	DAGS.	BREYTING	
TÆKNIPJÓNUSTAN SF		HANNAÐ	KVARDI 1:100.
LÁGMÚLA 5 - 108 REYKJAVÍK - SÍMI 83844		TEIKNAD 50.	DAGS. 19.8.86
<i>Oliver Hjort</i>		YFIRFARID	NR. BL. AF. 2