
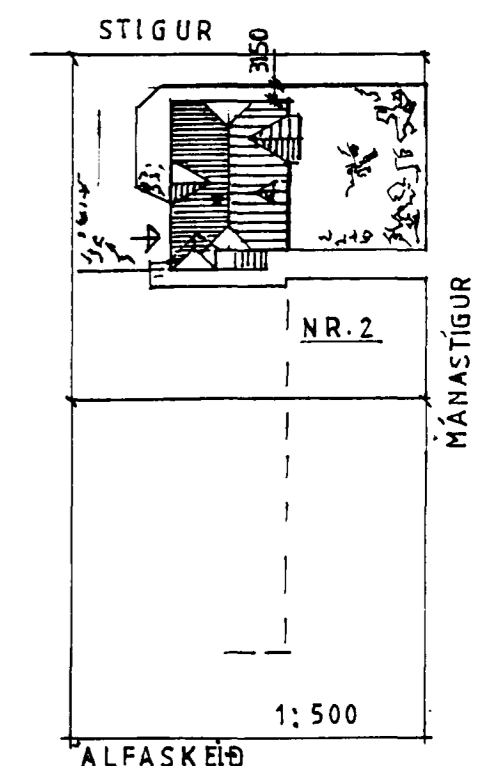
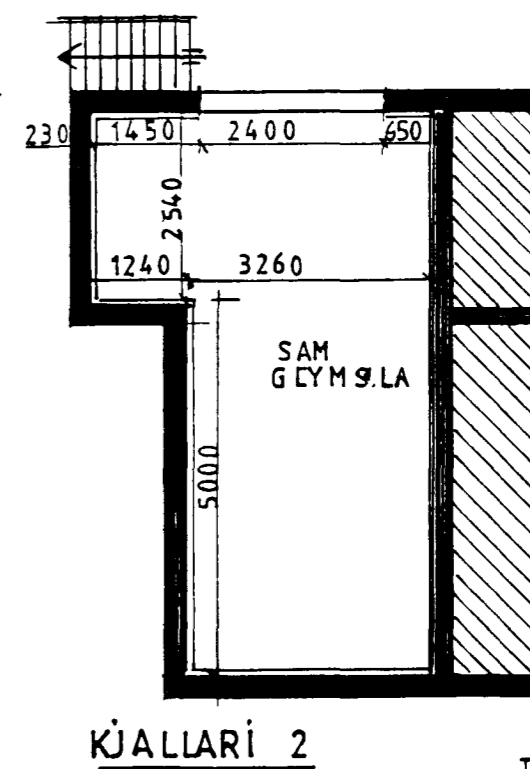
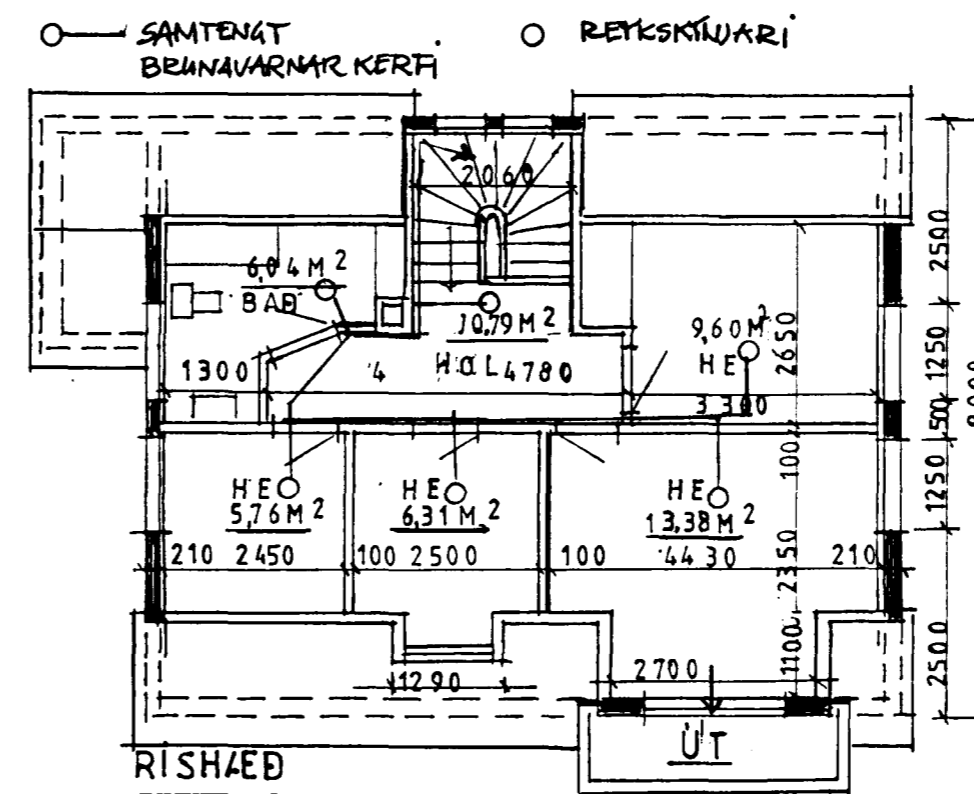
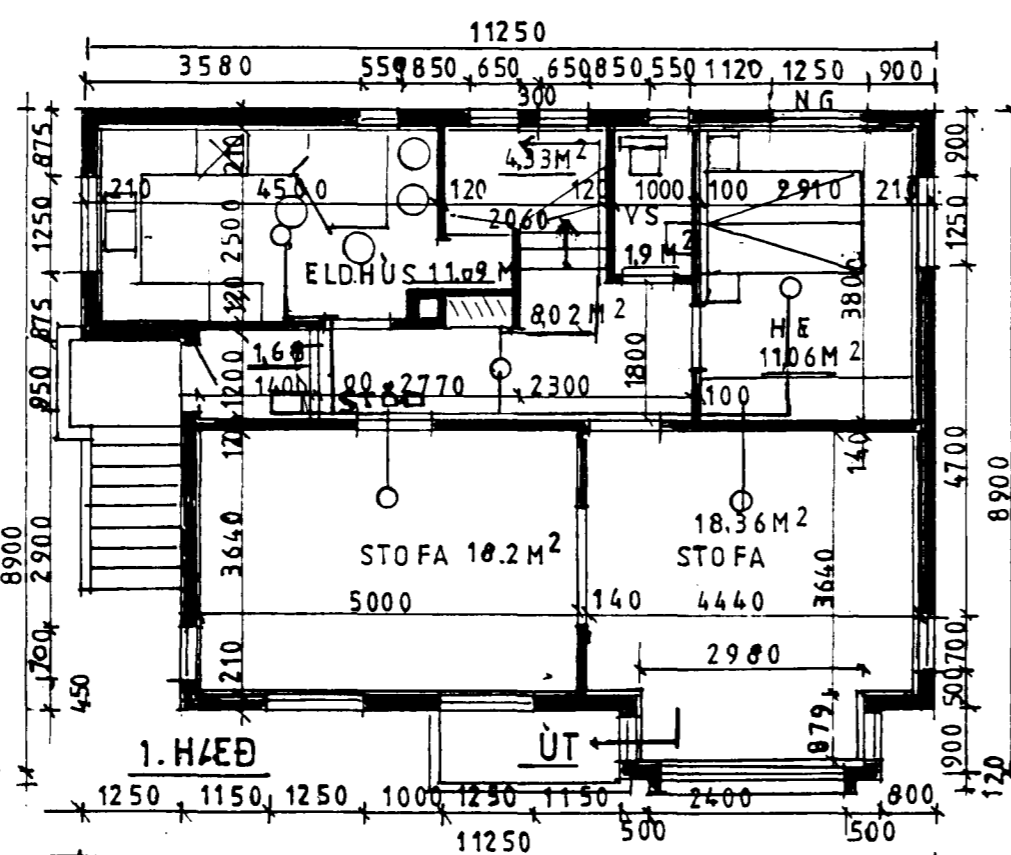
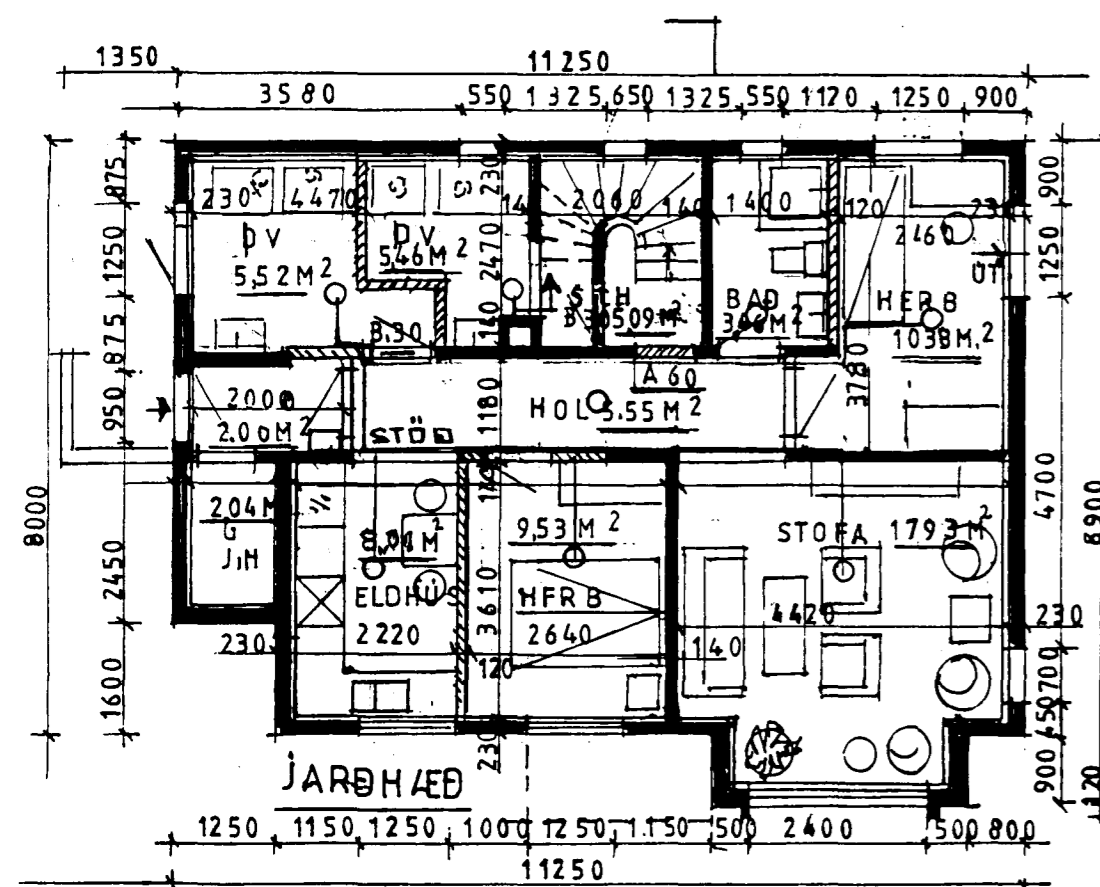


MÁNASTIGUR NR.2 HAFNARFJÖRÐUR  
M.K.V. 1:100

RISHÆÐ	63,00 M <sup>2</sup>	51,88 M <sup>2</sup>	1546 M <sup>3</sup>	1386 M <sup>3</sup>
1. HÆÐ	87,94 M <sup>2</sup>	74,64 M <sup>2</sup>	2418 M <sup>3</sup>	1866 M <sup>3</sup>
JARÐHÆÐ	91,00 M <sup>2</sup>	75,00 M <sup>2</sup>	2503 M <sup>3</sup>	1875 M <sup>3</sup>
KJALLARI	32,71 M <sup>2</sup>	27,75 M <sup>2</sup>	818 M <sup>3</sup>	638 M <sup>3</sup>
SAM	274,65 M <sup>2</sup>	229,27 M <sup>2</sup>	7235 M <sup>3</sup>	5765 M <sup>3</sup>

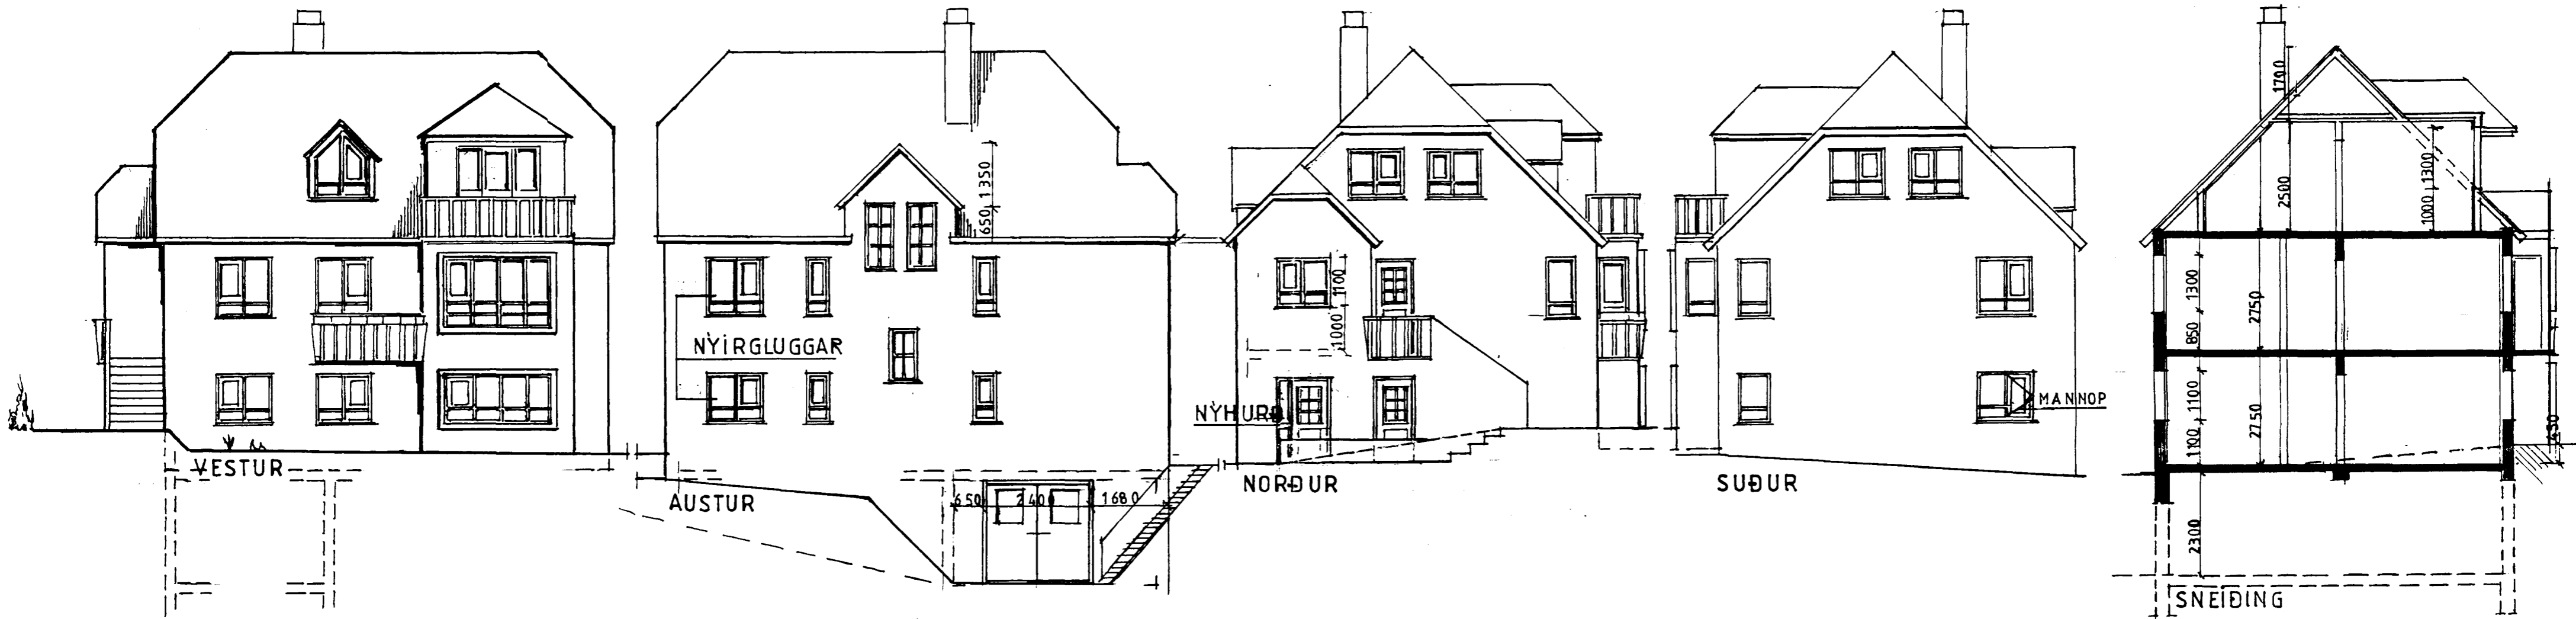

TEIKNAD MAÍ 1951  
AF ÞÓRI BALDRI

BR: I SEPT 1995  
EIN F.HÍZUNNARGEINADSSON  
REINAR EINNARSON E.A.F.