




Mávahraun 4

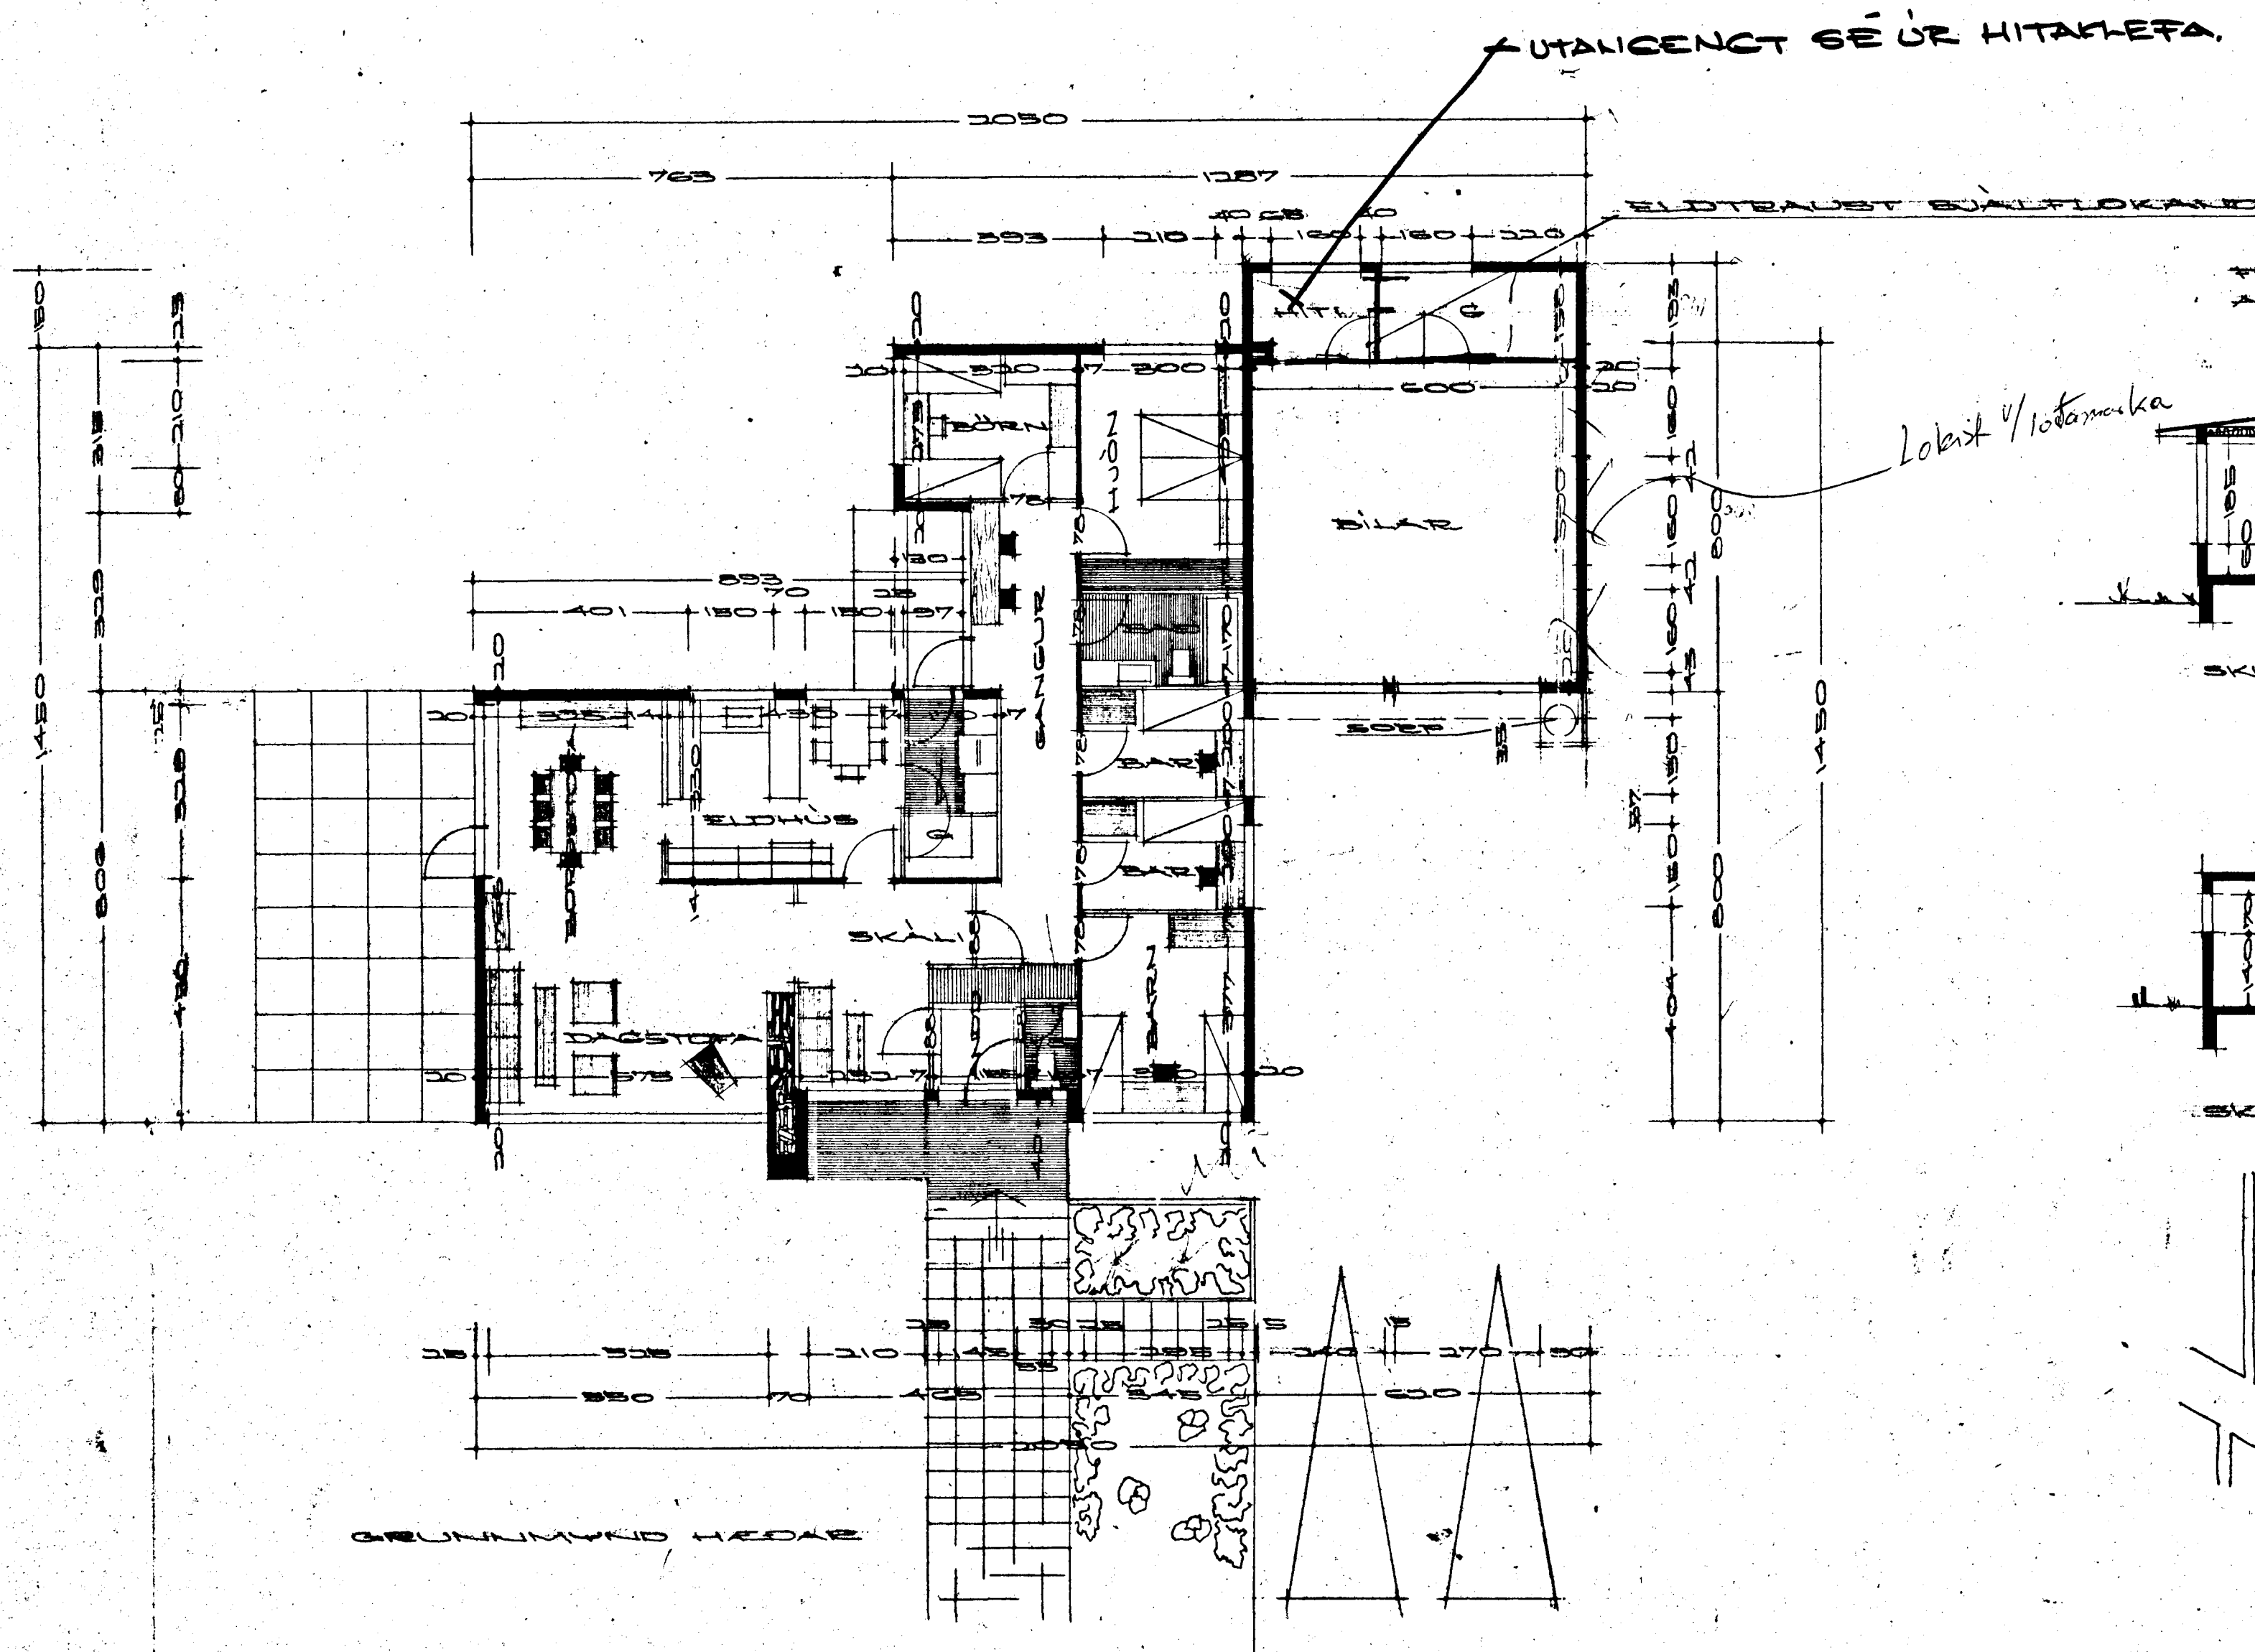


FLATARMAL HUSS 152,08 M²
AFSTODUMUND M:1:1000

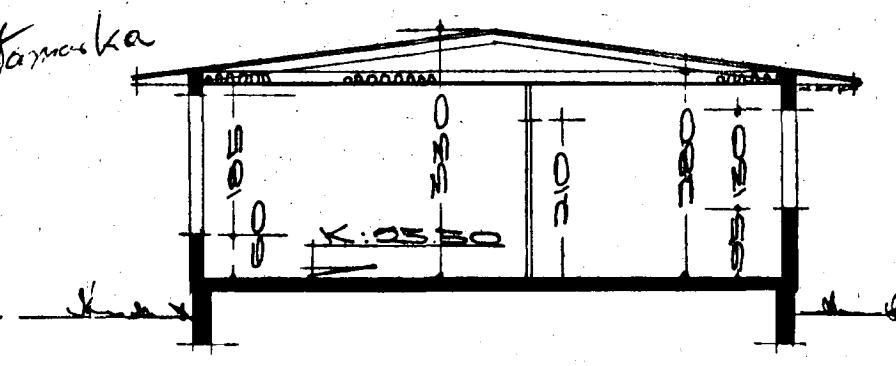

SKURDUR A-A

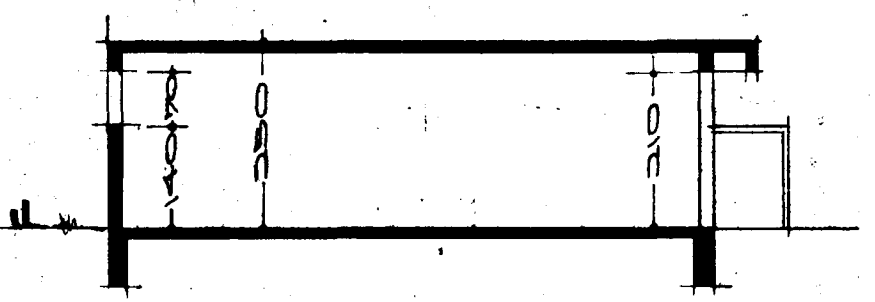

SKURDUR B-B

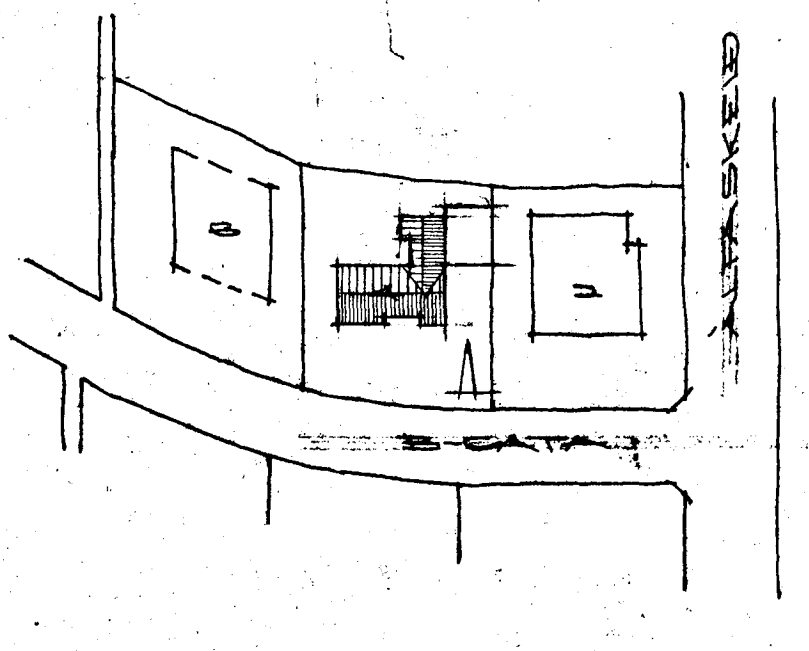

REYKJAVIK I SEPT. 1966

Þjartar Sveinsson