
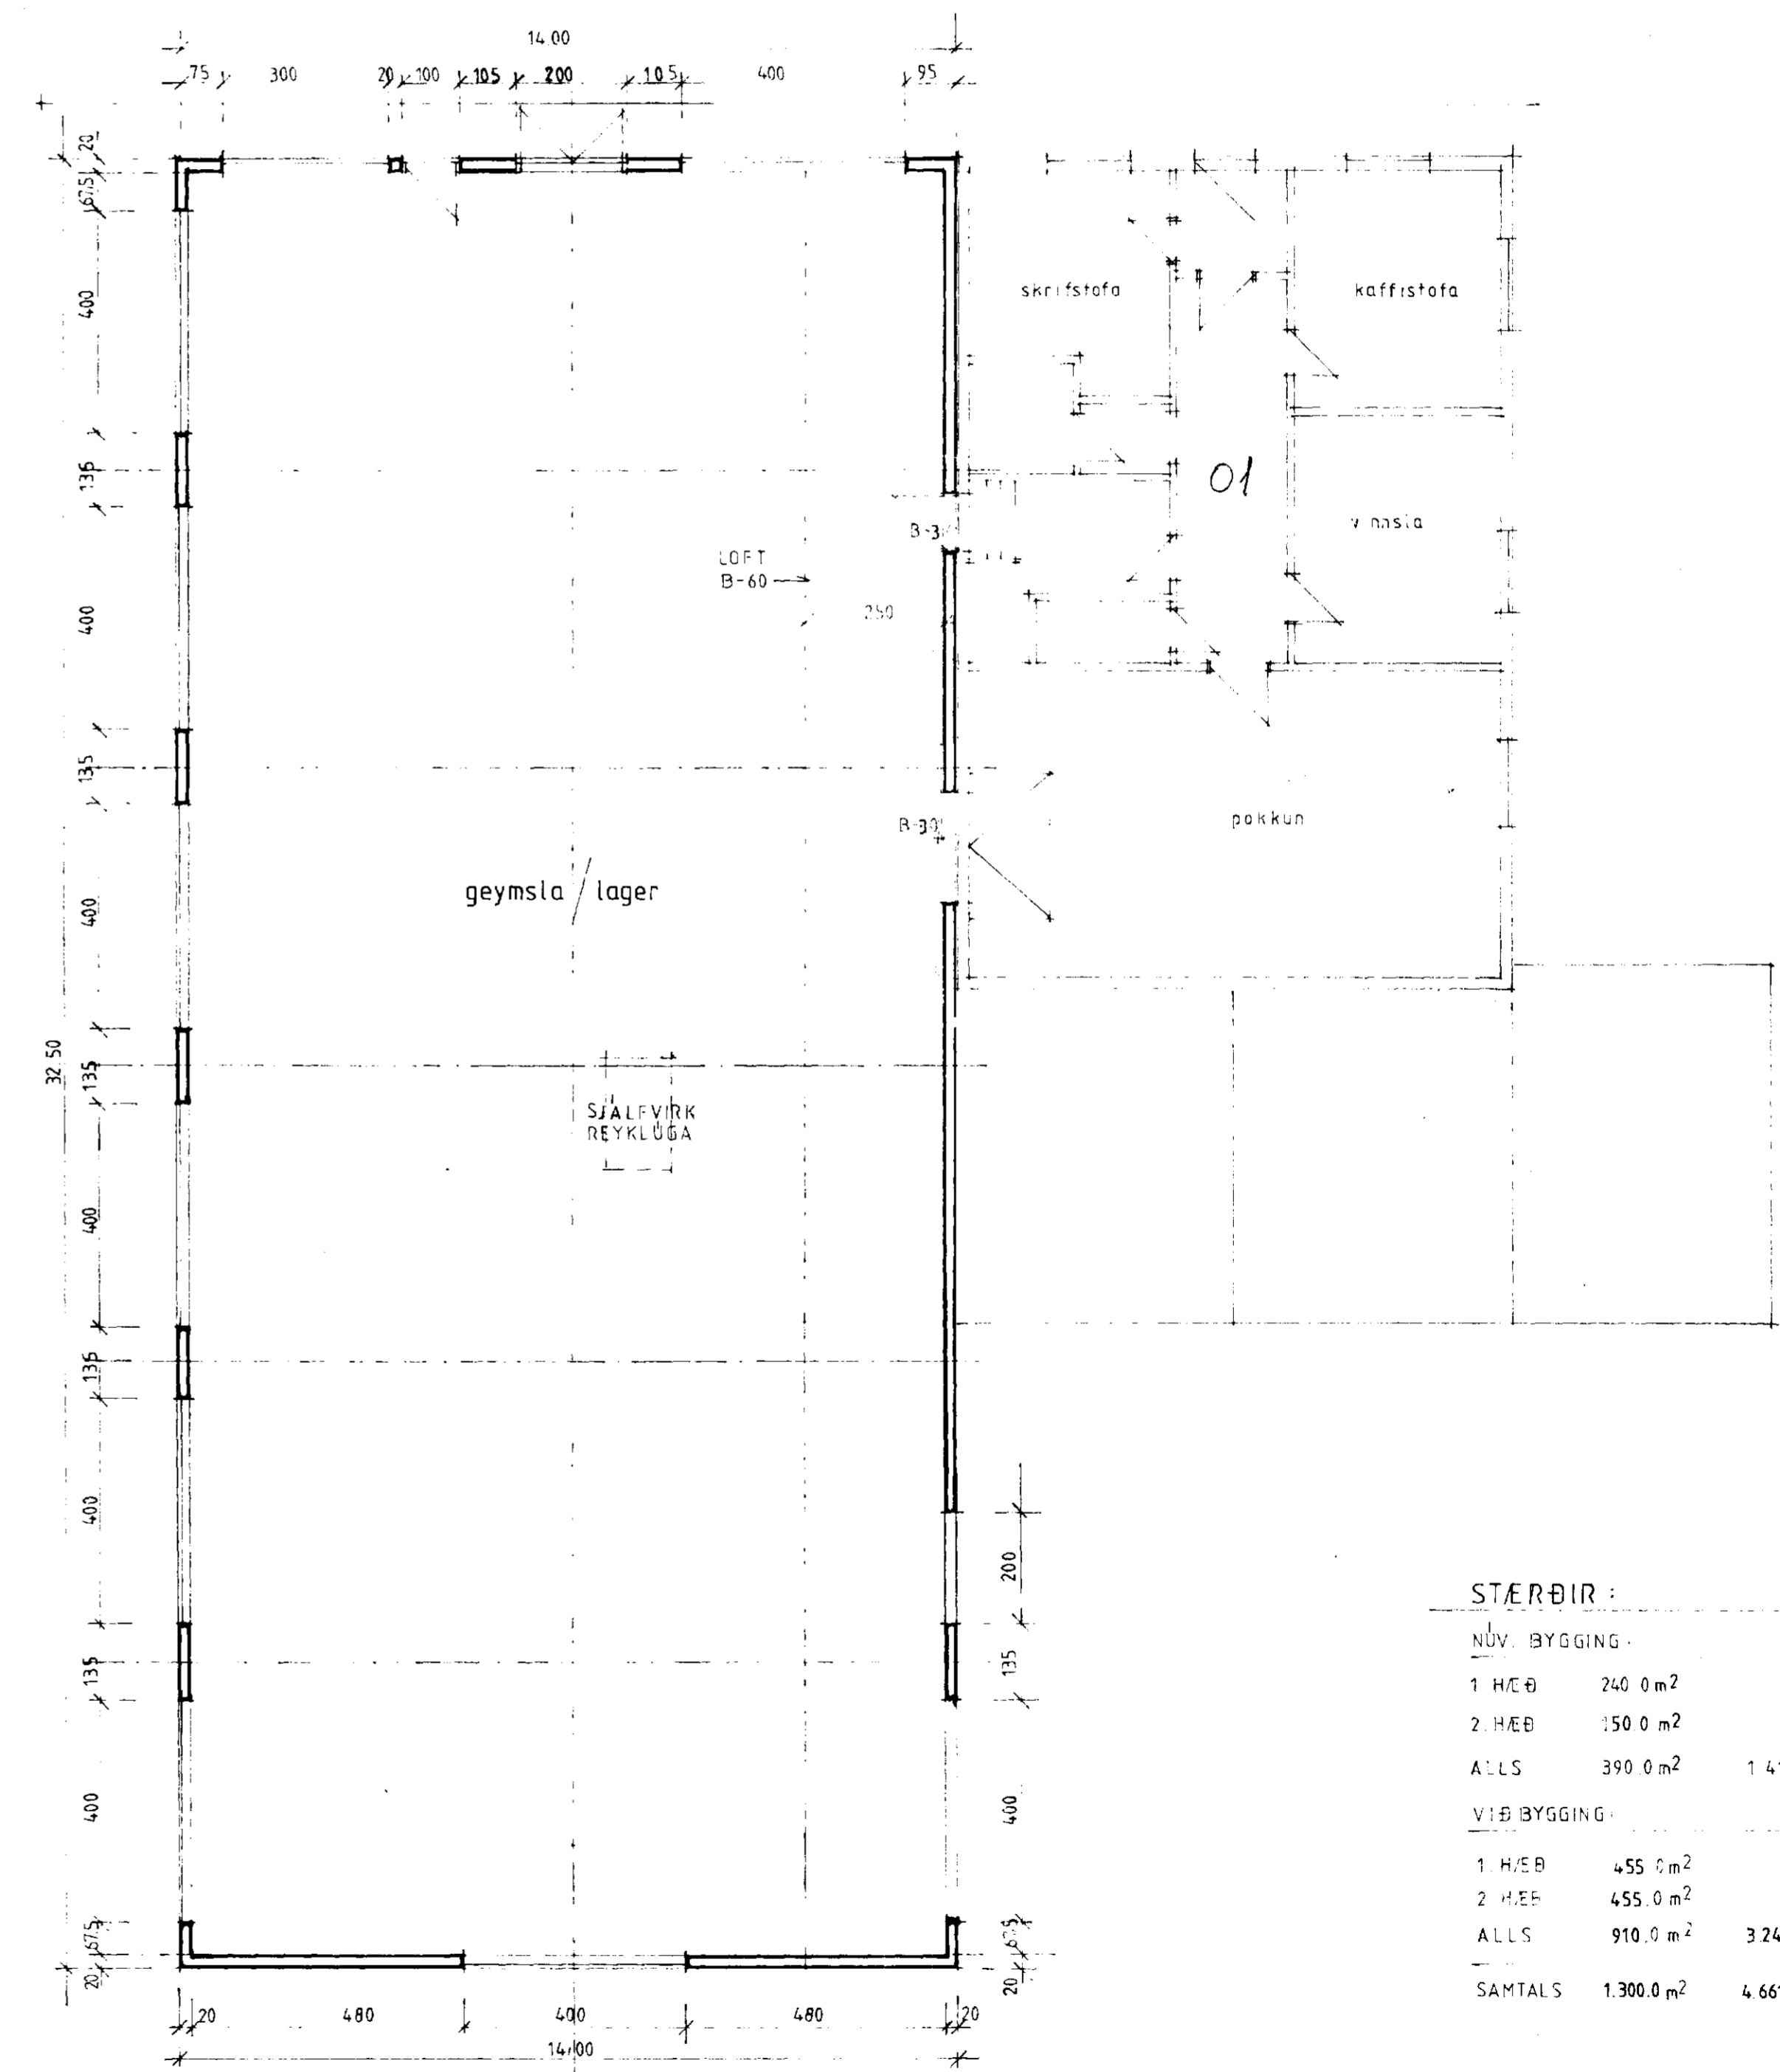


# Úr Gildi

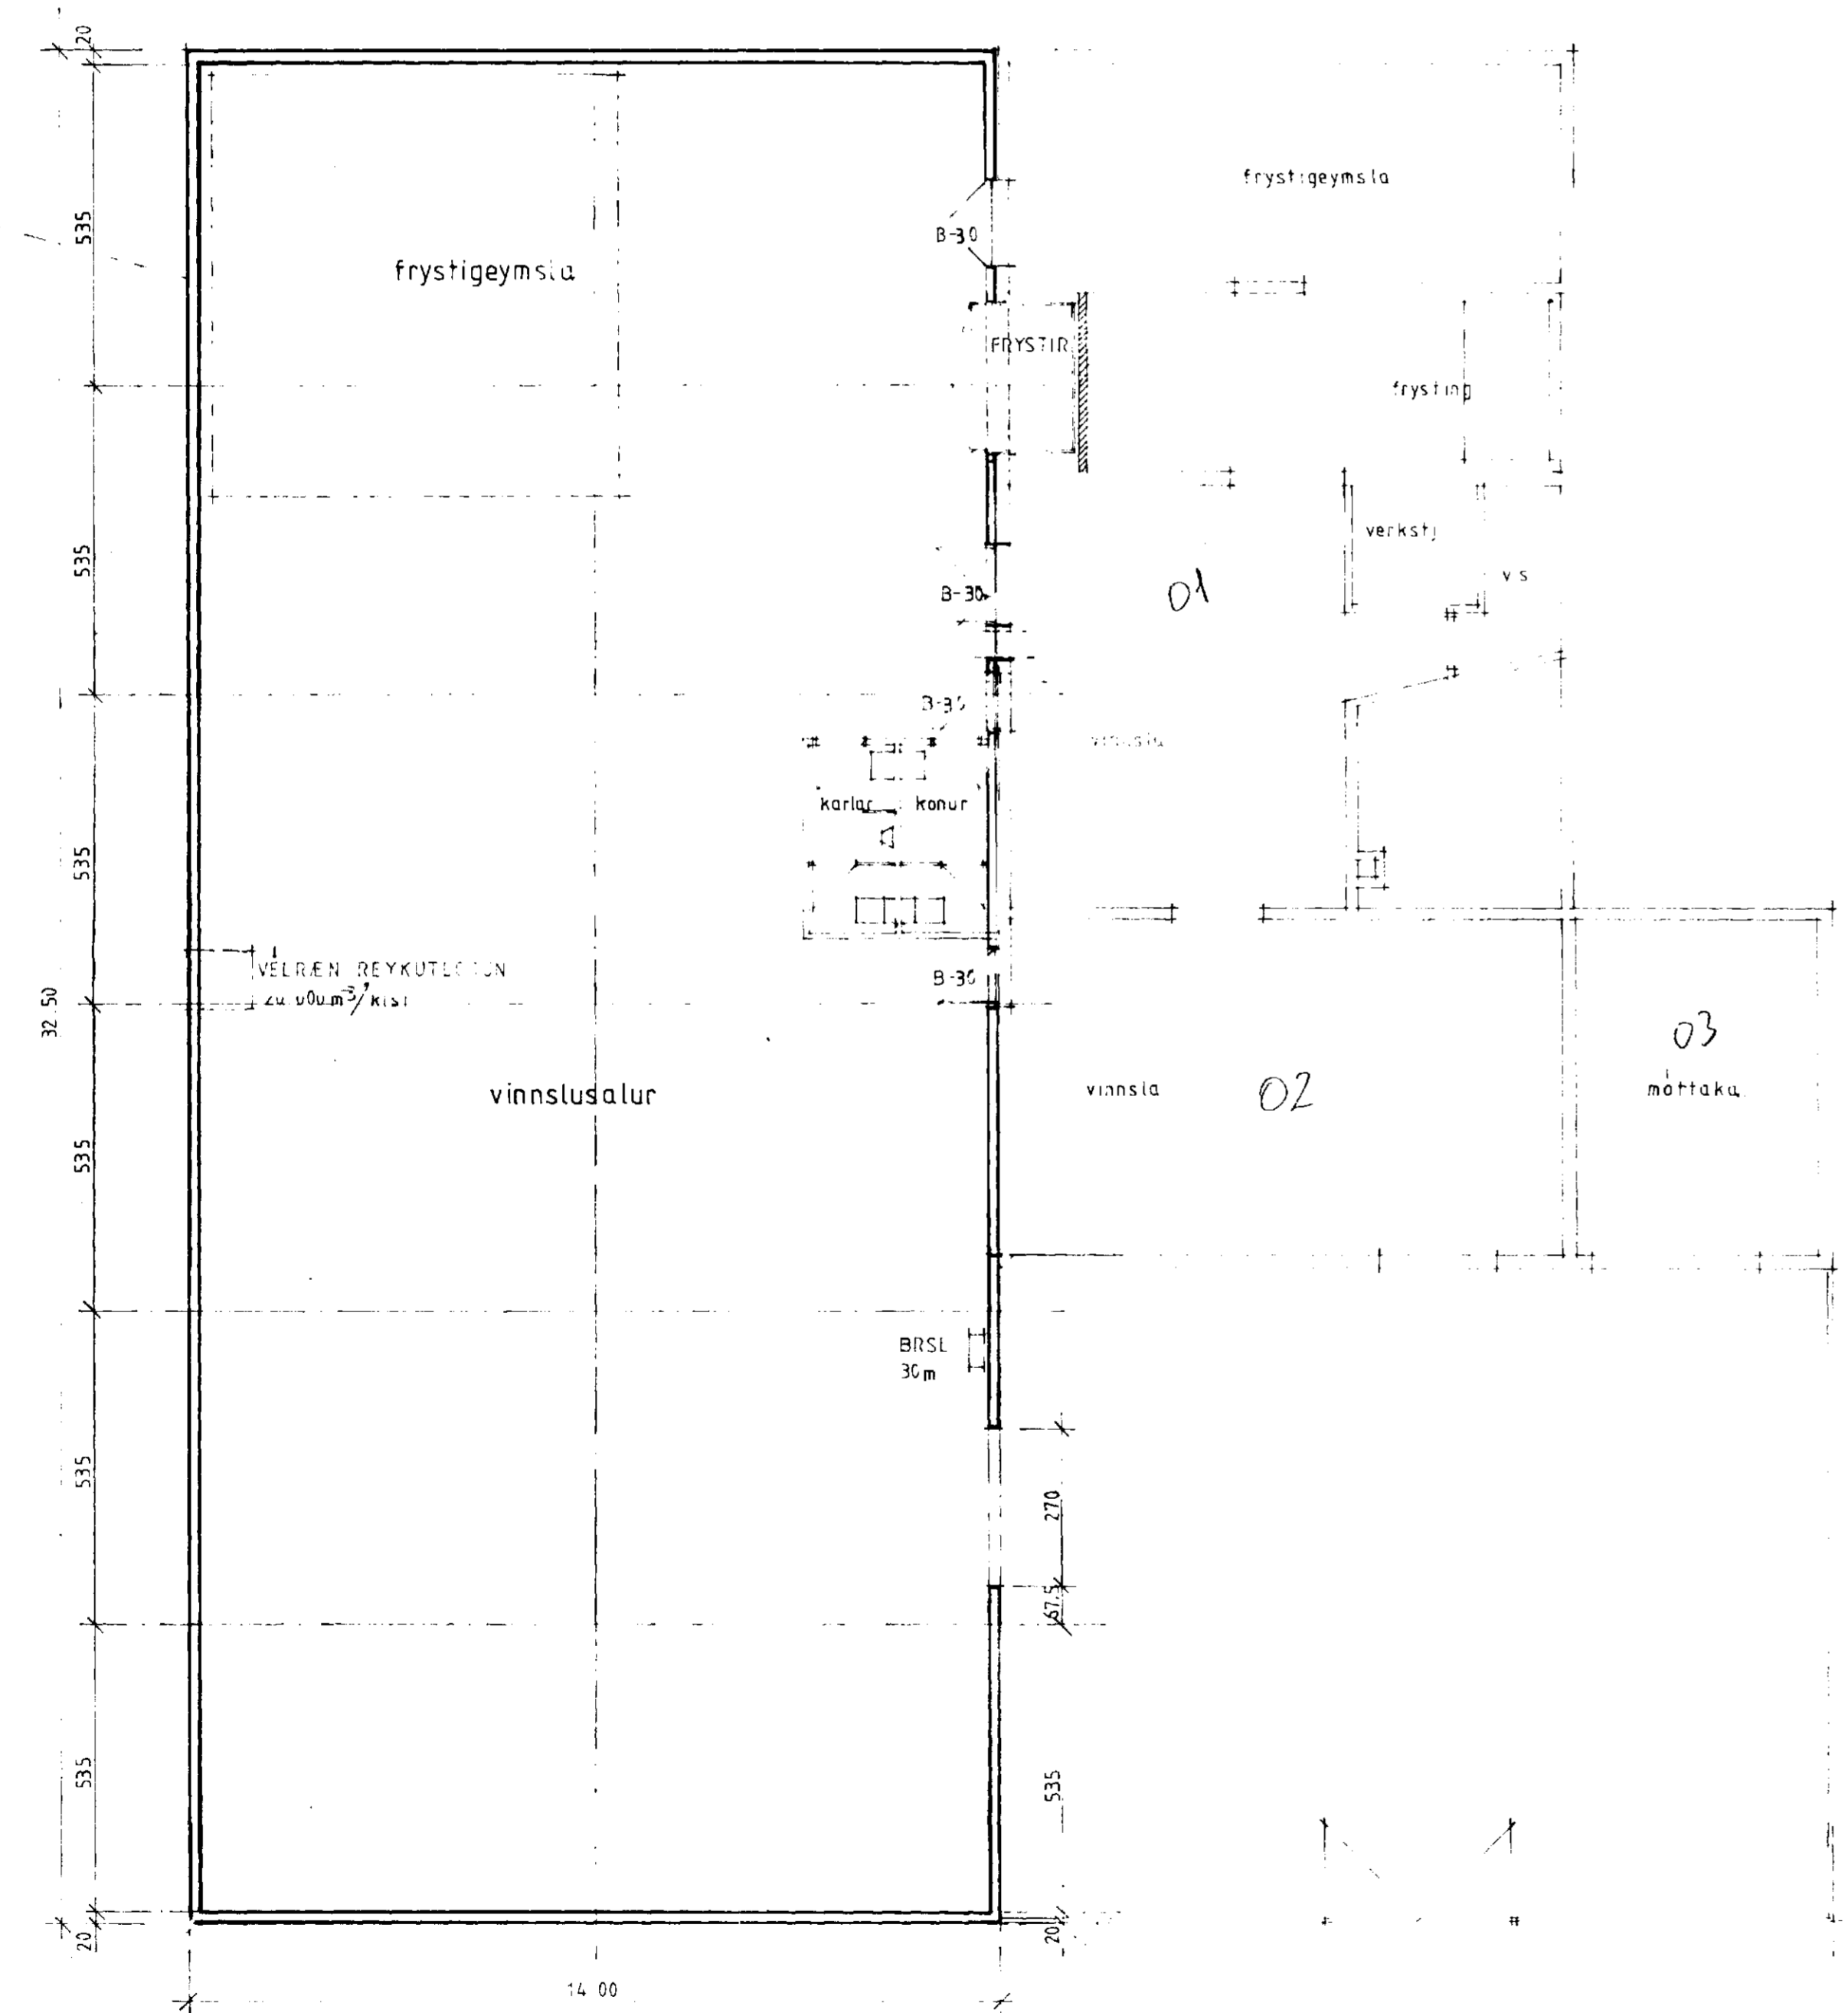

**STÆÐIR:**

NÚV. BYGGING			
1. HÆÐ	240.0 m <sup>2</sup>		
2. HÆÐ	150.0 m <sup>2</sup>		
ALLS	390.0 m <sup>2</sup>	1.415.0 m <sup>3</sup>	
VIB. BYGGING			
1. HÆÐ	455.0 m <sup>2</sup>		
2. HÆÐ	455.0 m <sup>2</sup>		
ALLS	910.0 m <sup>2</sup>	3.246.4 m <sup>3</sup>	
SAMTALS	1.300.0 m <sup>2</sup>	4.661.4 m <sup>3</sup>	

DAGS. BREYTT  
 03.12.90 HURÐIR OG GRÖSSAR  
 23.01.91 HÚS LÉNGD, HURÐIR, SNYRTINGAR

MELABRAUT 17  
 GRUNNMYNDIR 1:100  
 01.10.90 01  
 Arsæll Vignisson arkitekt  
 Reykjavíkurvegi 60 s. 65 30 61