



SNID B-B 1:100

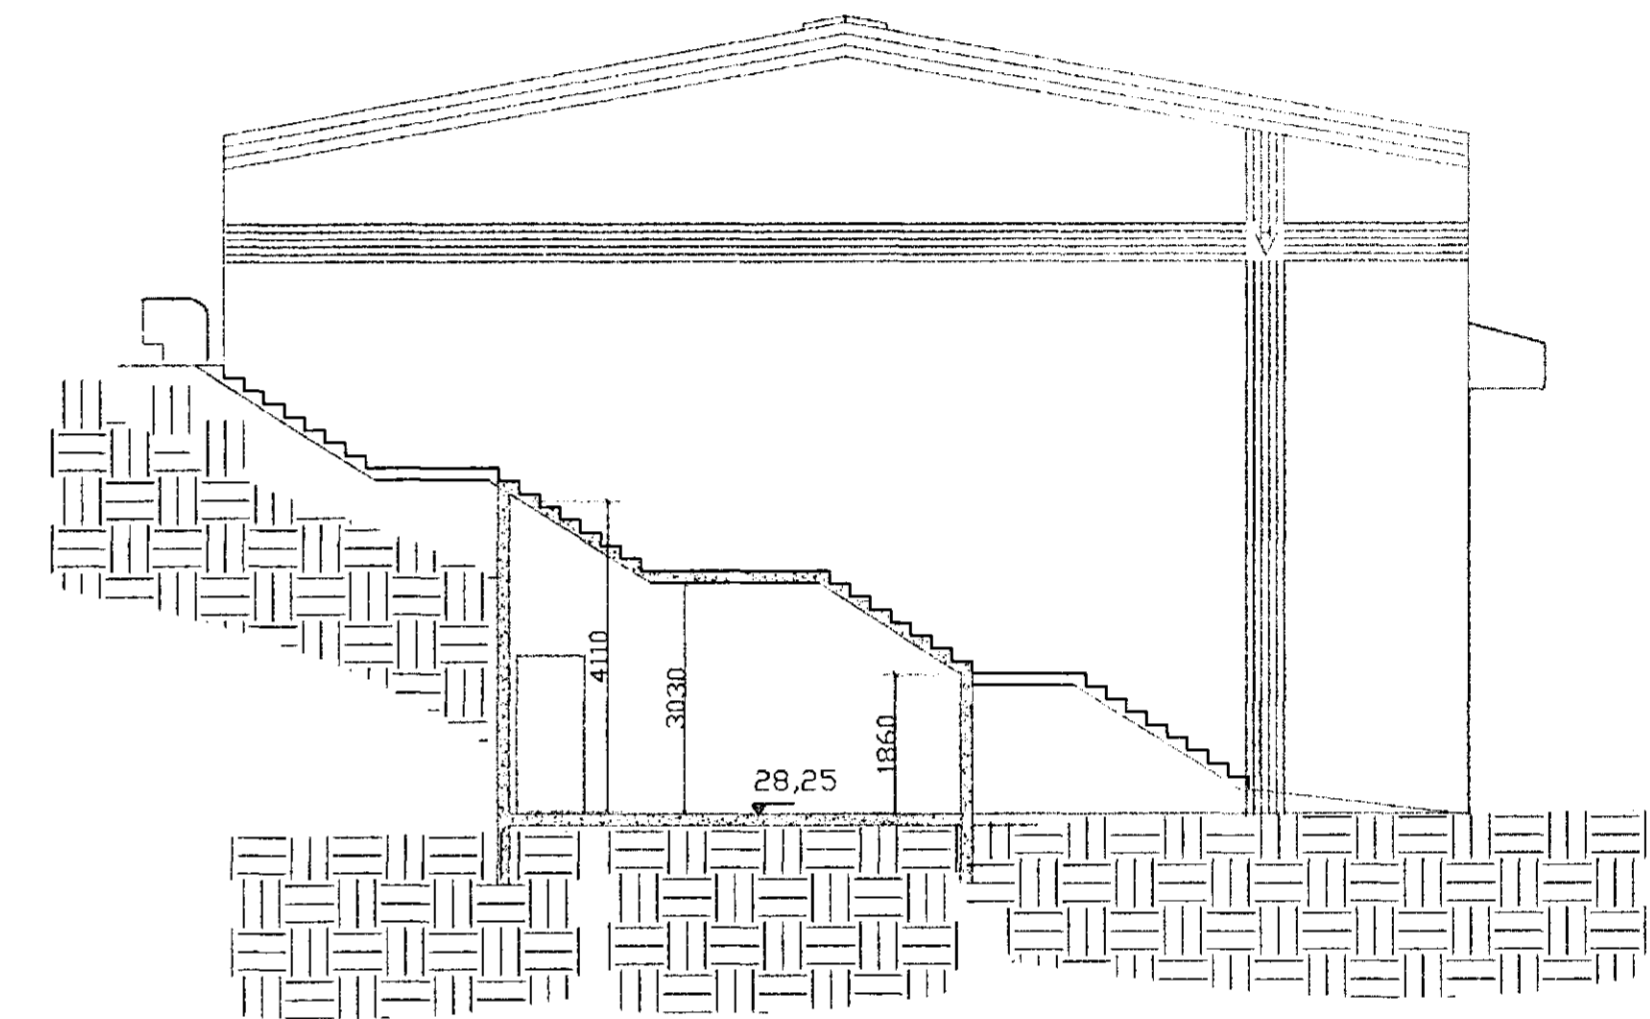

SNID C-C 1:100

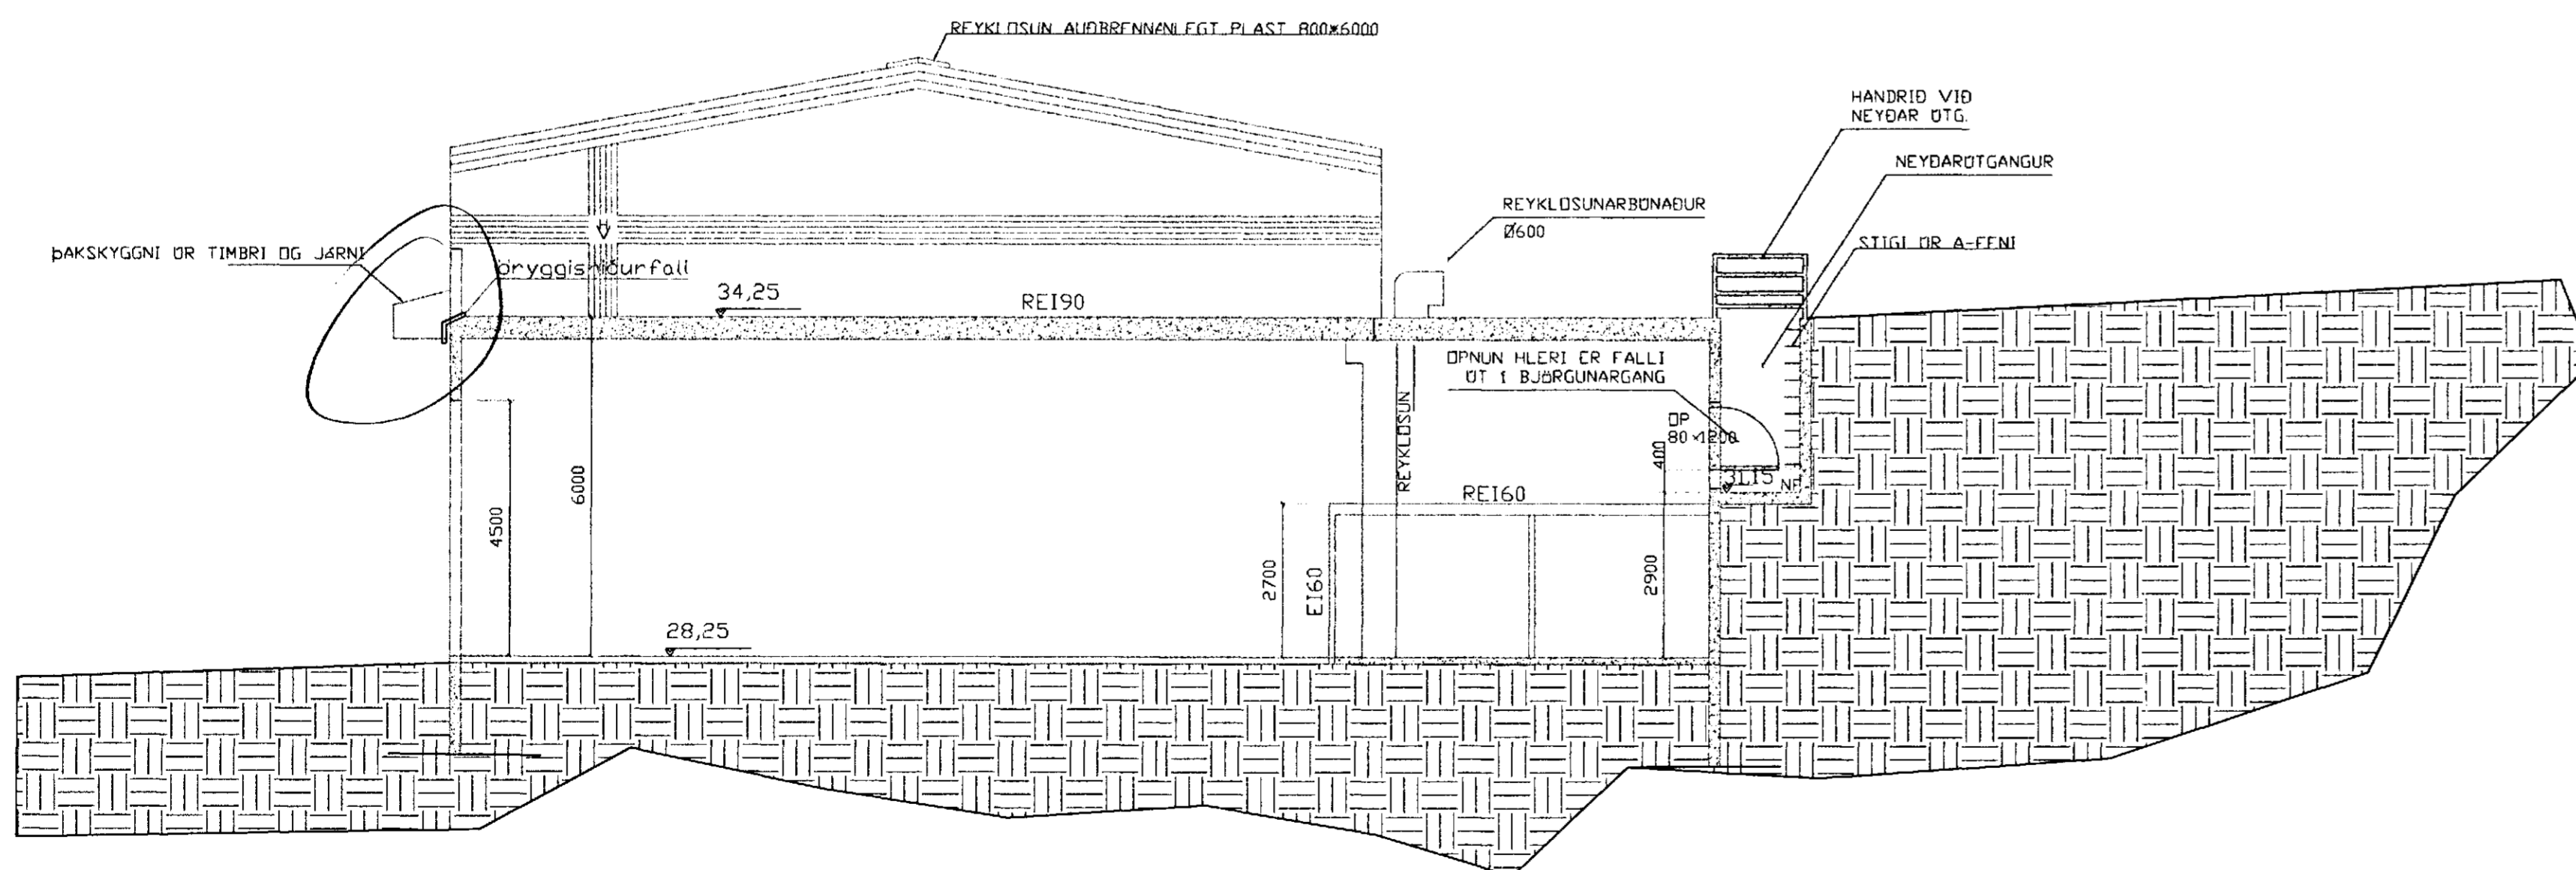

SNID A-A 1:100

SKÝRINGAR TEIKNINGASKRÁ

- BLAD 0 - 01 GRUNNMYNDR, BYGGINGALÝSING ÖG ALMENNAR SKÝRINGAR
- BLAD 0 - 02 AFSTÖÐUMYND LÖÐAR ÖG ÖTLIT AUSTUR ÖG NÖRÐUR
- BLAD 0 - 03 ÖTLIT SUÐUR ÖG VESTUR
- BLAD 0 - 04 SNEIÐINGAR

BP	DAGS	FÖLJI BREITINGA	SÍGN

MELABRAUT 21 HAFNARFIRÐI

SNEIÐINGAR

MÆLIKV 1:100

DAGS NÓV. 97

VERK NR. 9757

TEIKN. NR. 0 - 04

HANNAÐ Sp 241148-3009

TEIKNAD Sp

YFIRFARID

**TÆKNIPJÓNUSTA** SIGURÐAR ÞORLEIFSSONAR ehf  
STRANDGÖTU 11 220 HAFNARFIRÐI  
SÍMI 555-4255 FAX 565-2875  
E-mail taeknipjonusta@islandia.is

