


Breytt 13.6 72
 Jóh

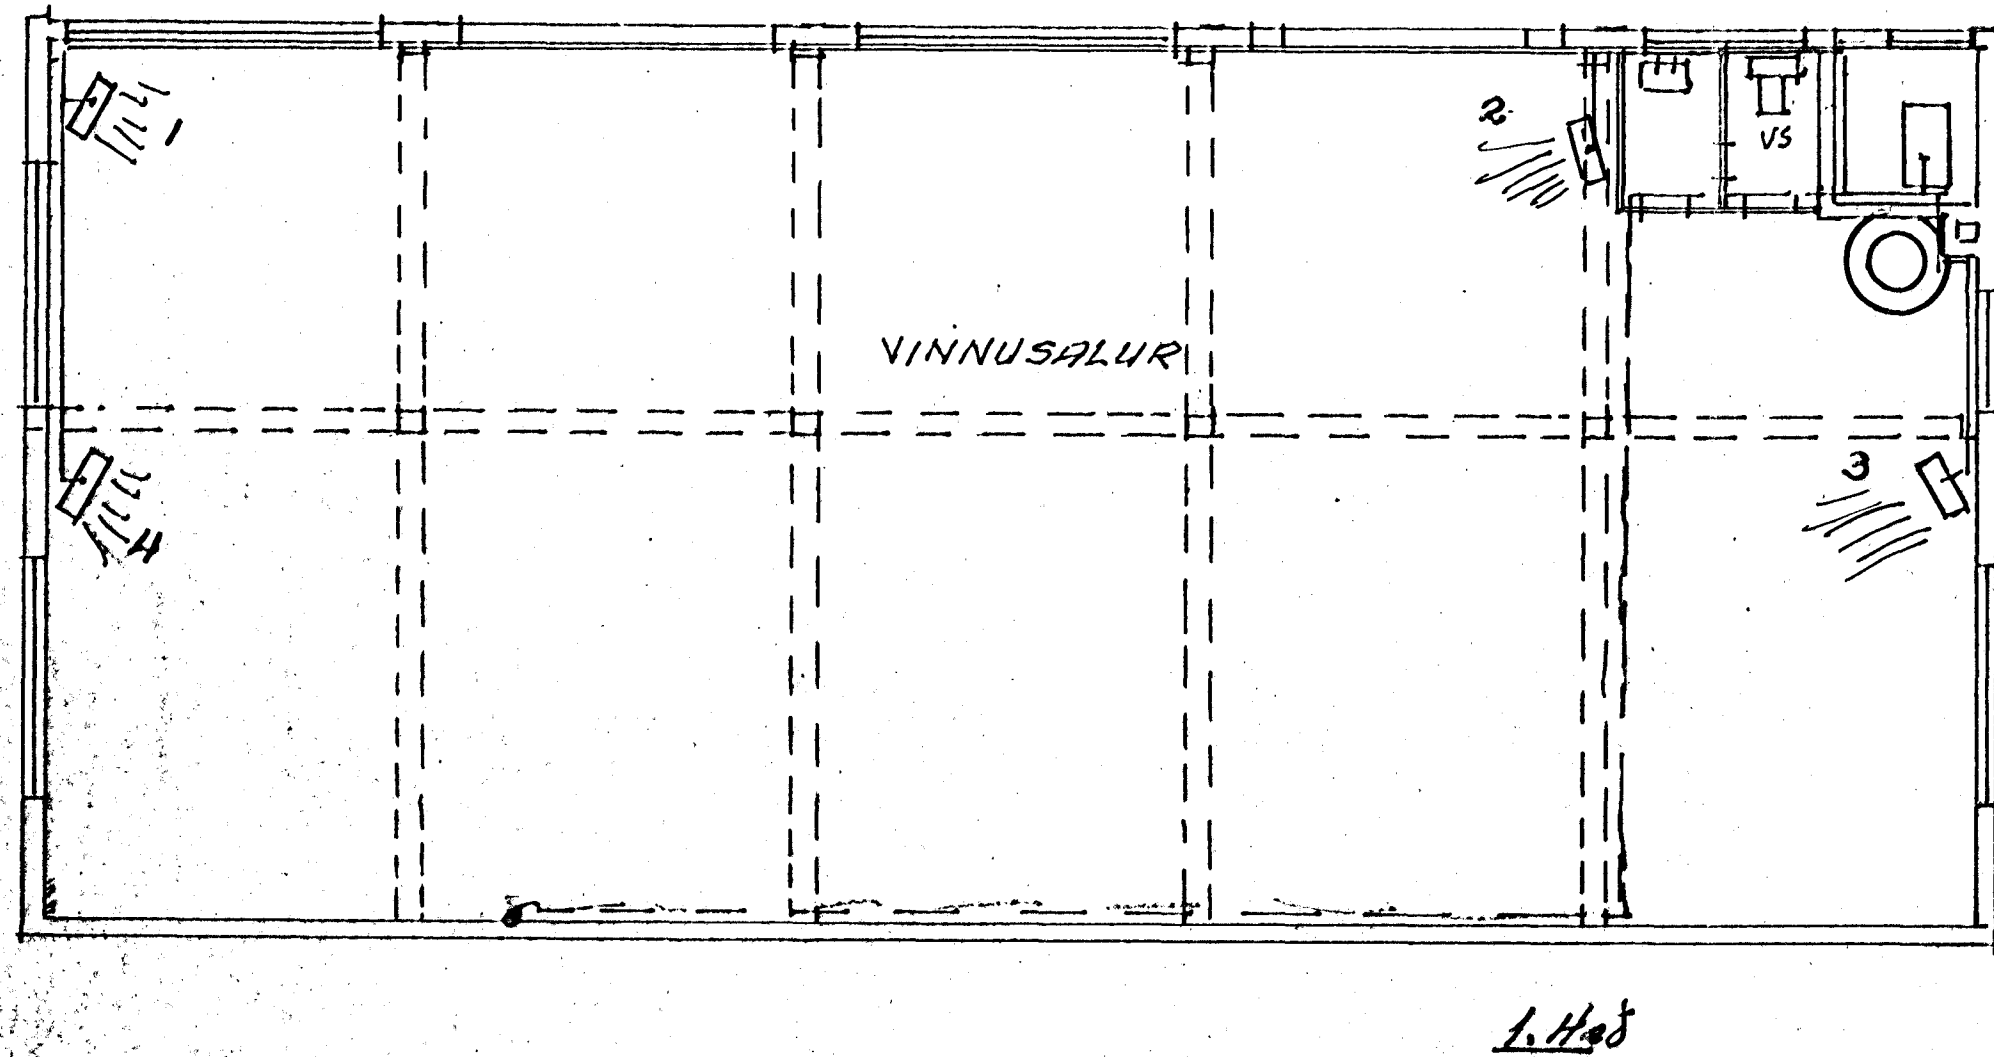

HITALÖGN Í MELLA- BRAUT 23 NETAVERKS.	H.	DAÐI.	Þ. 72
	1/100	TEIGN.	L.H.
Kóluinn & fjörsón- telningi mlfó	TEIGN. NR	7003	
	BL. 1.		