

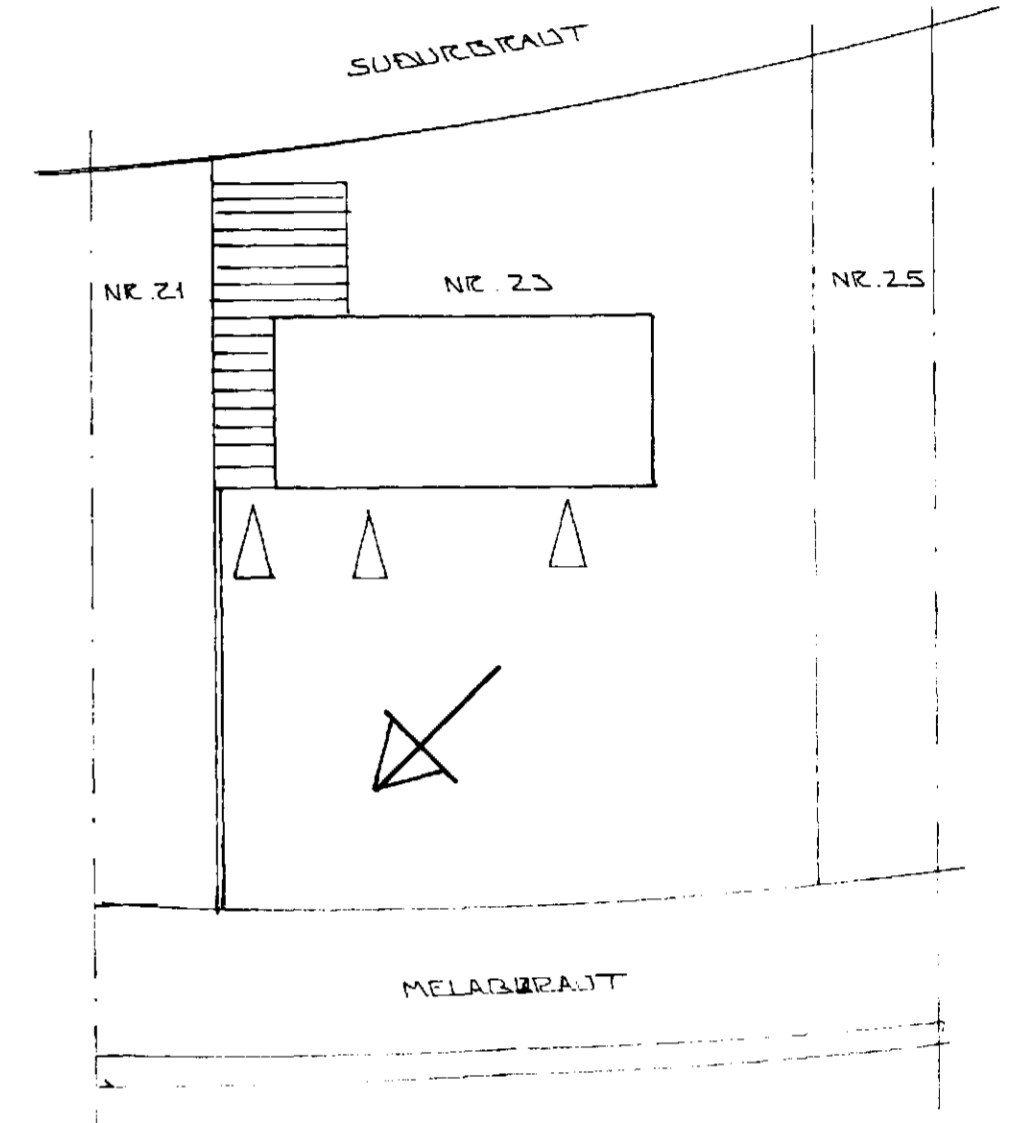
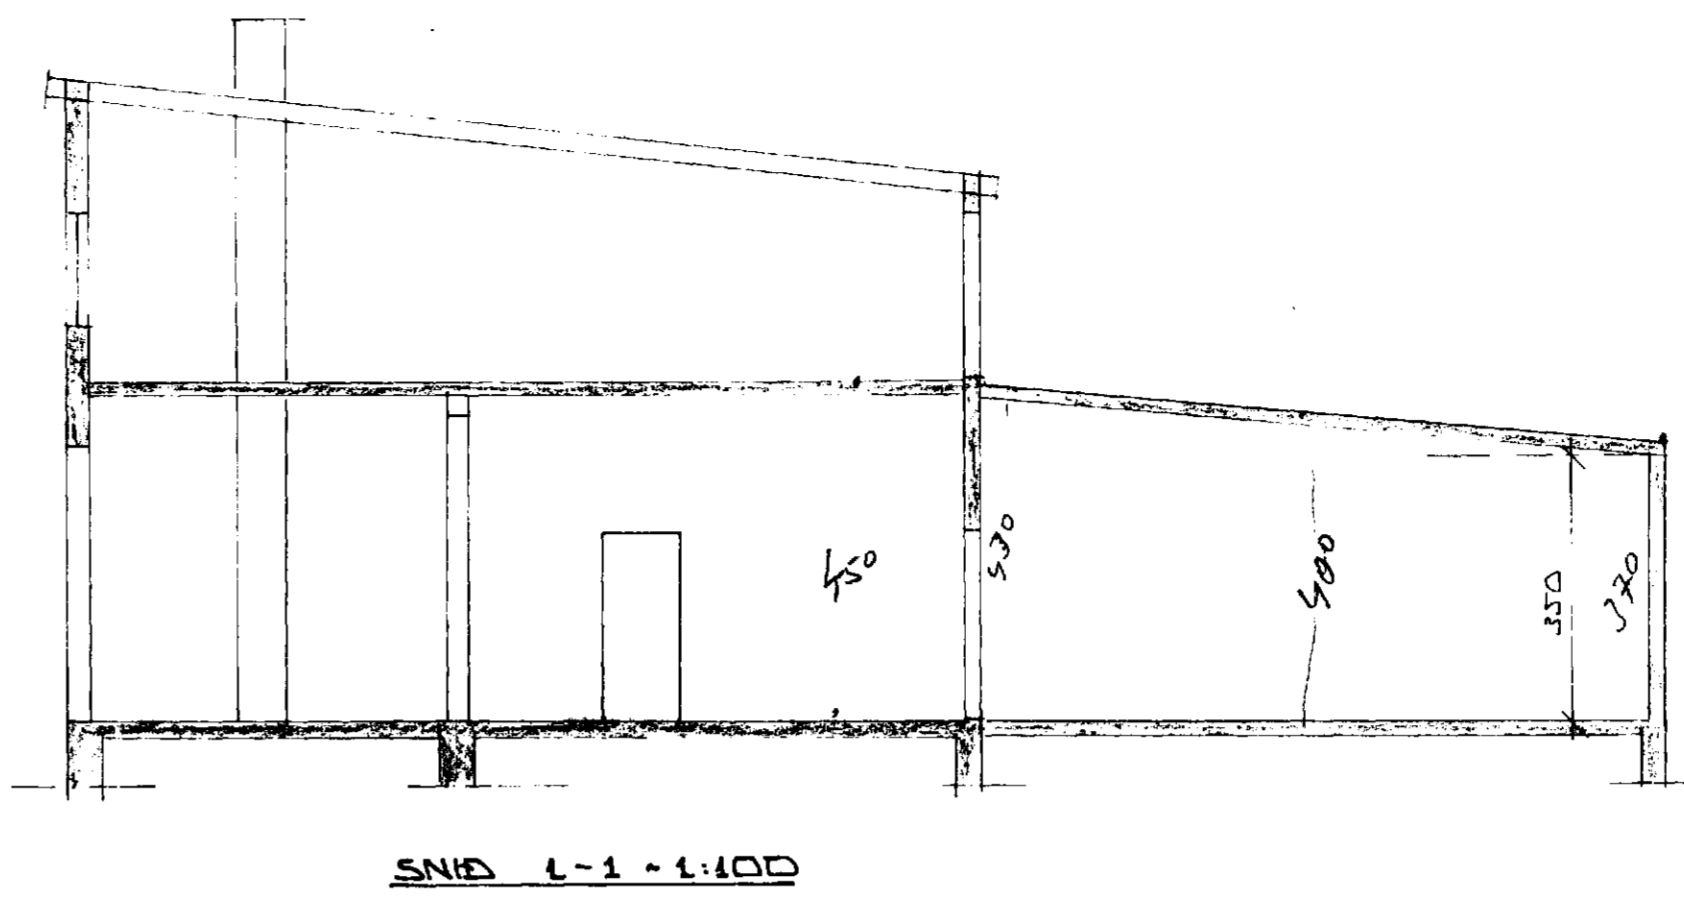
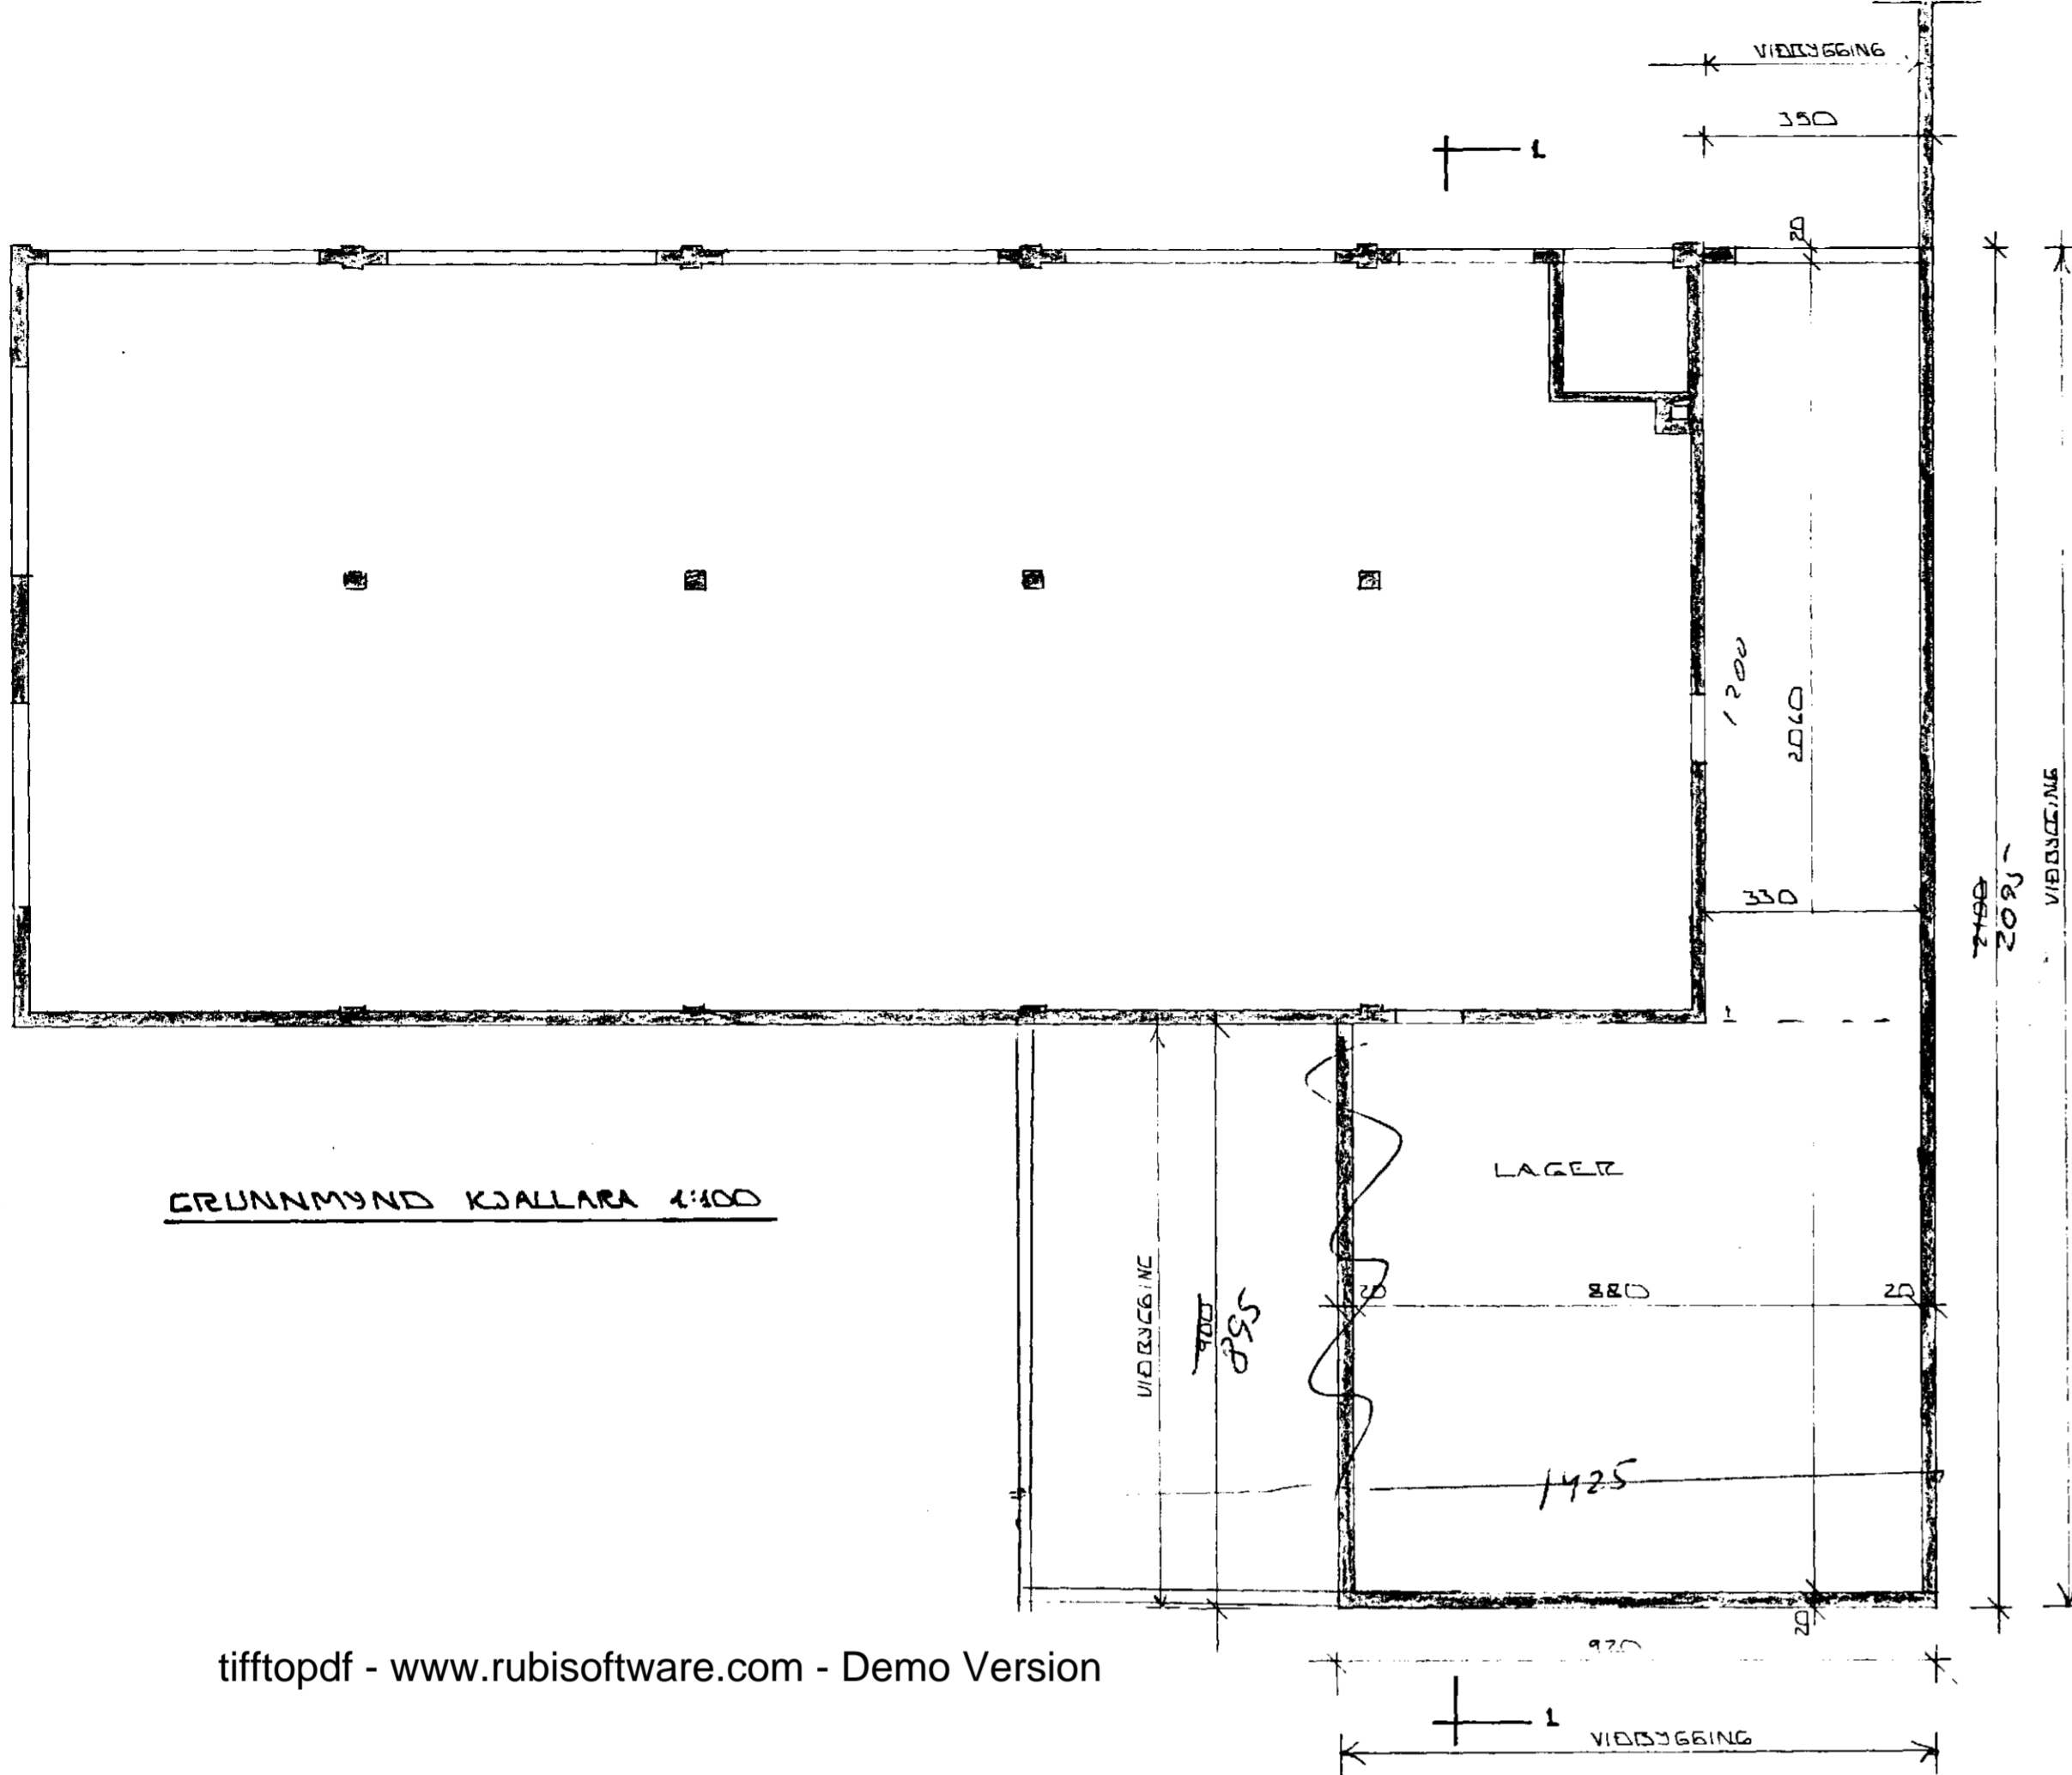
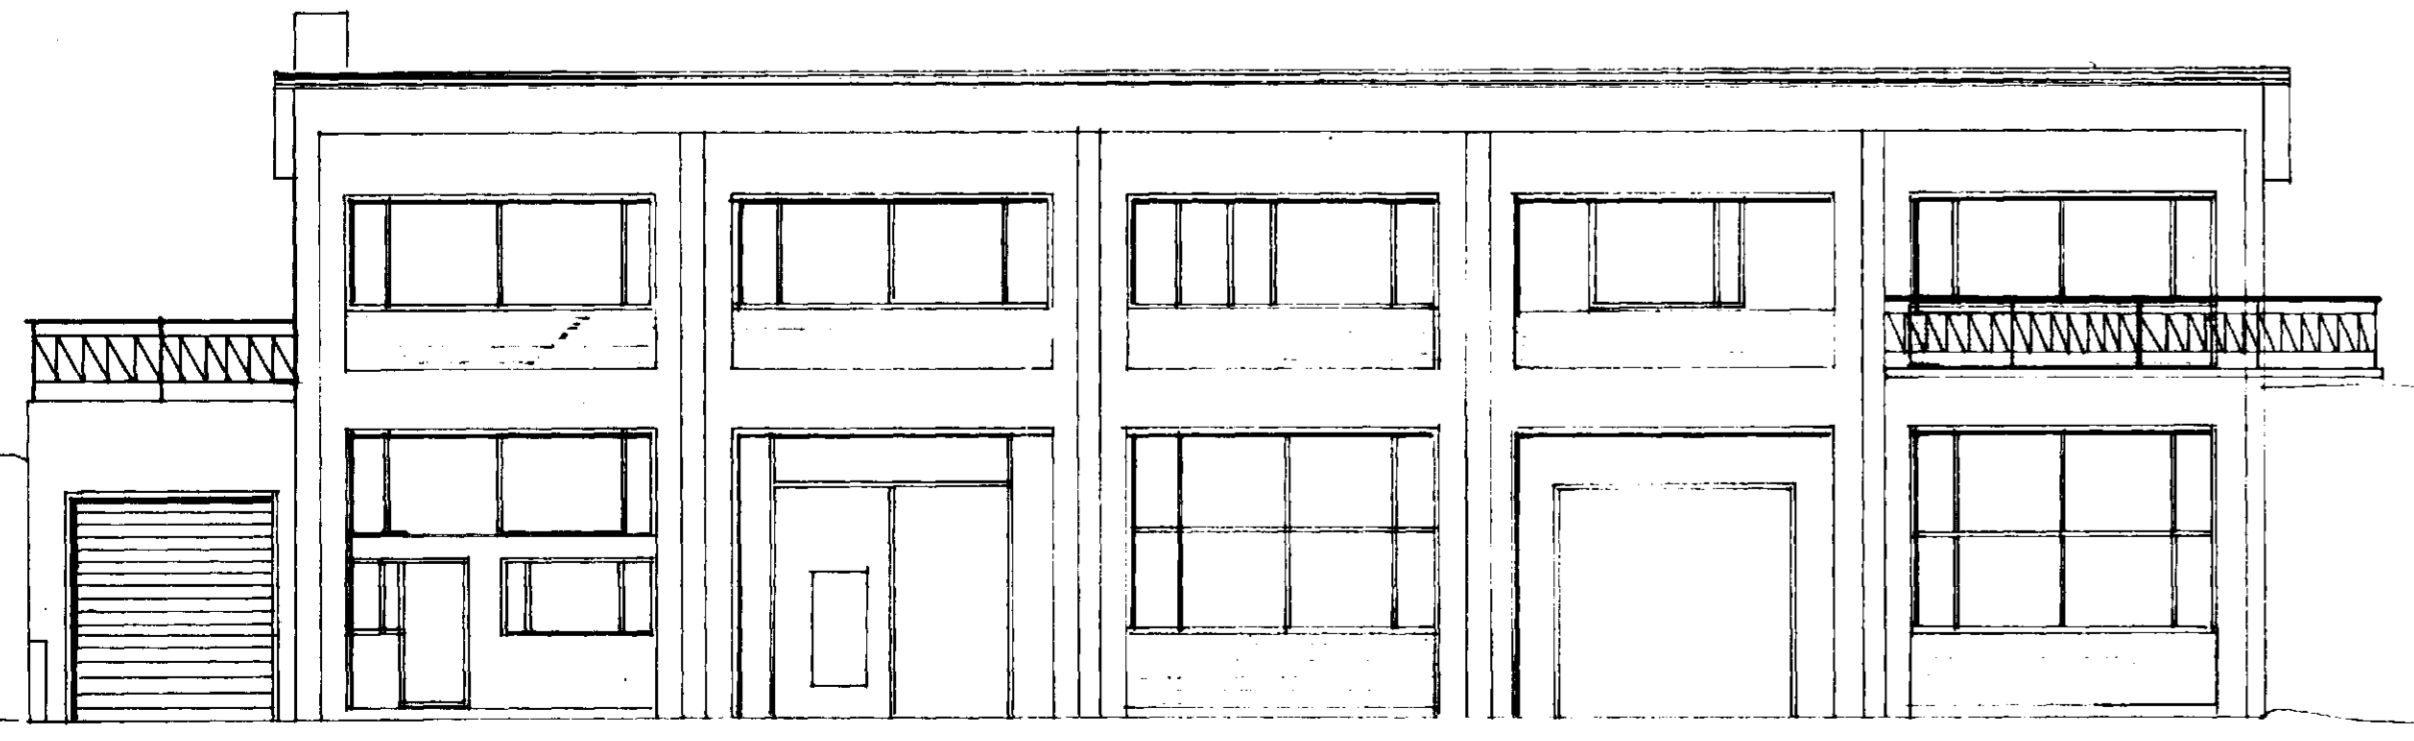


Gemblikt á fundi bygginga-  
nefndar þ. 13/2 1985  
BYGGINGAULLYKINGIN  
Í HAFNARFIRDI  
5/1/85

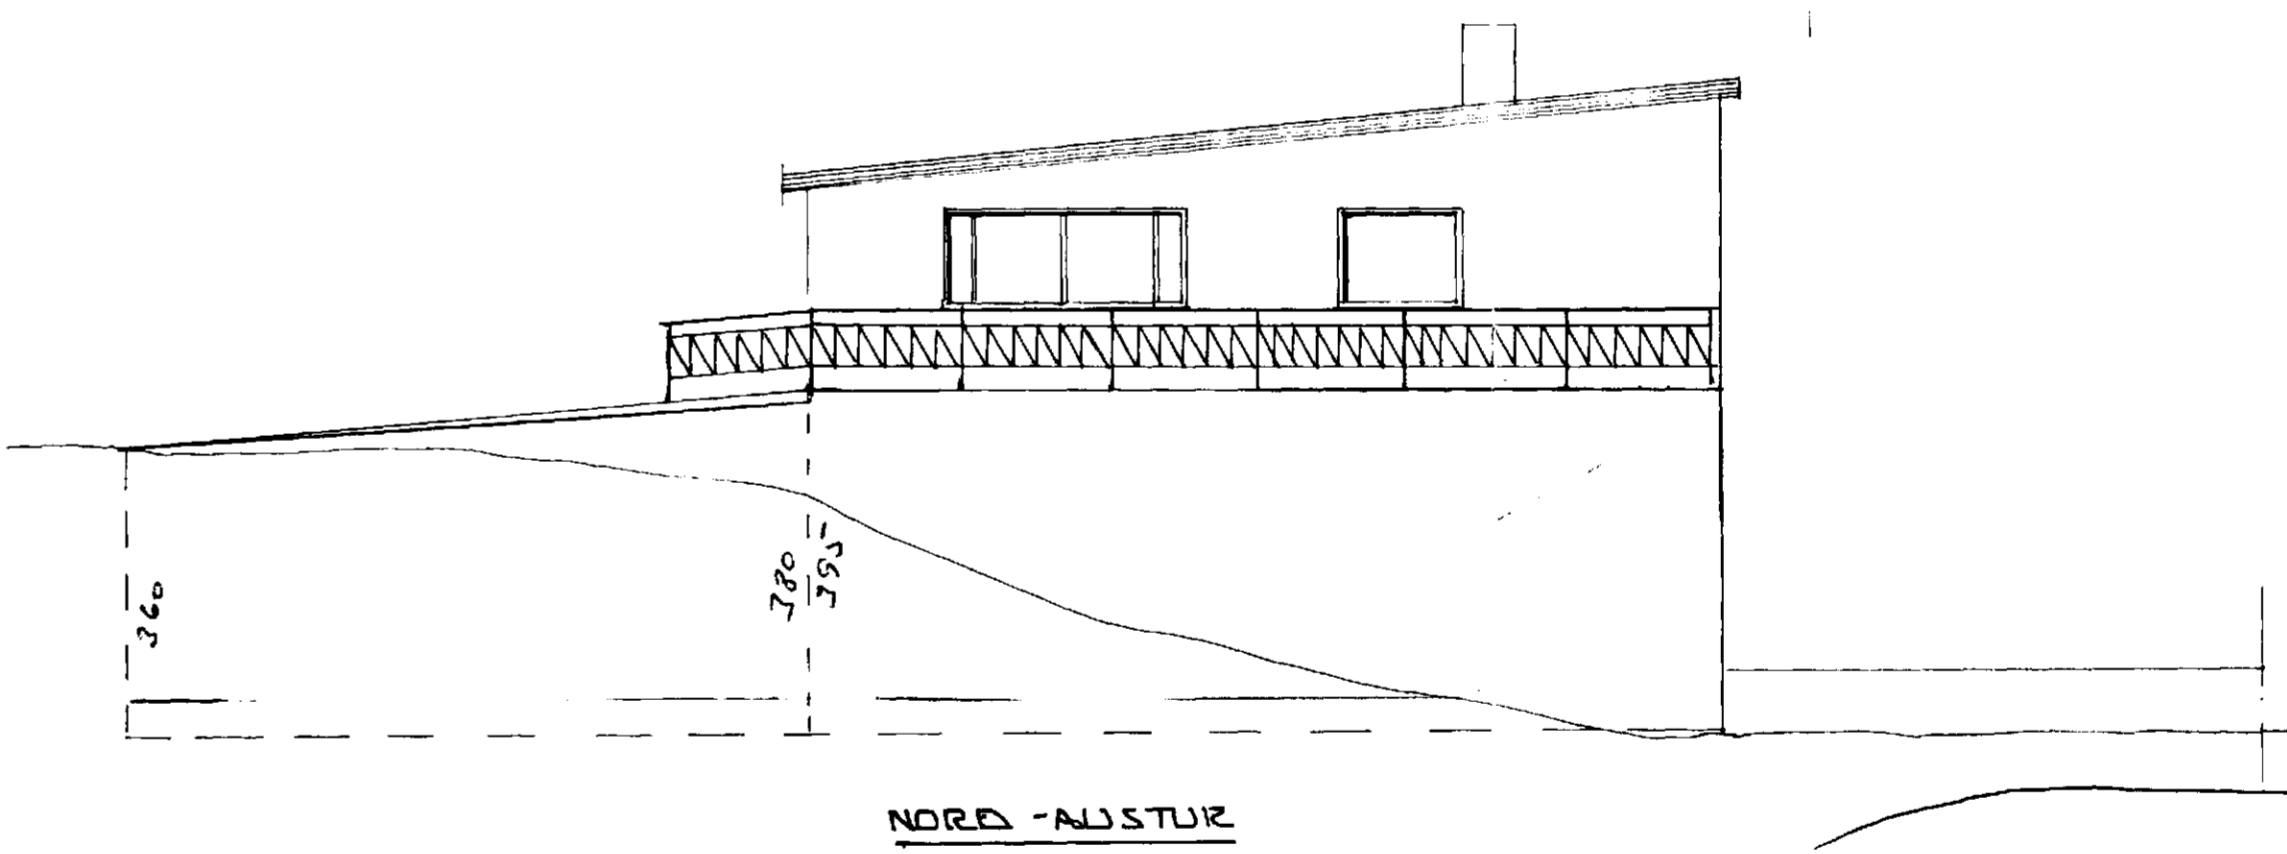

tiffpdf - www.rubissoftware.com - Demo Version

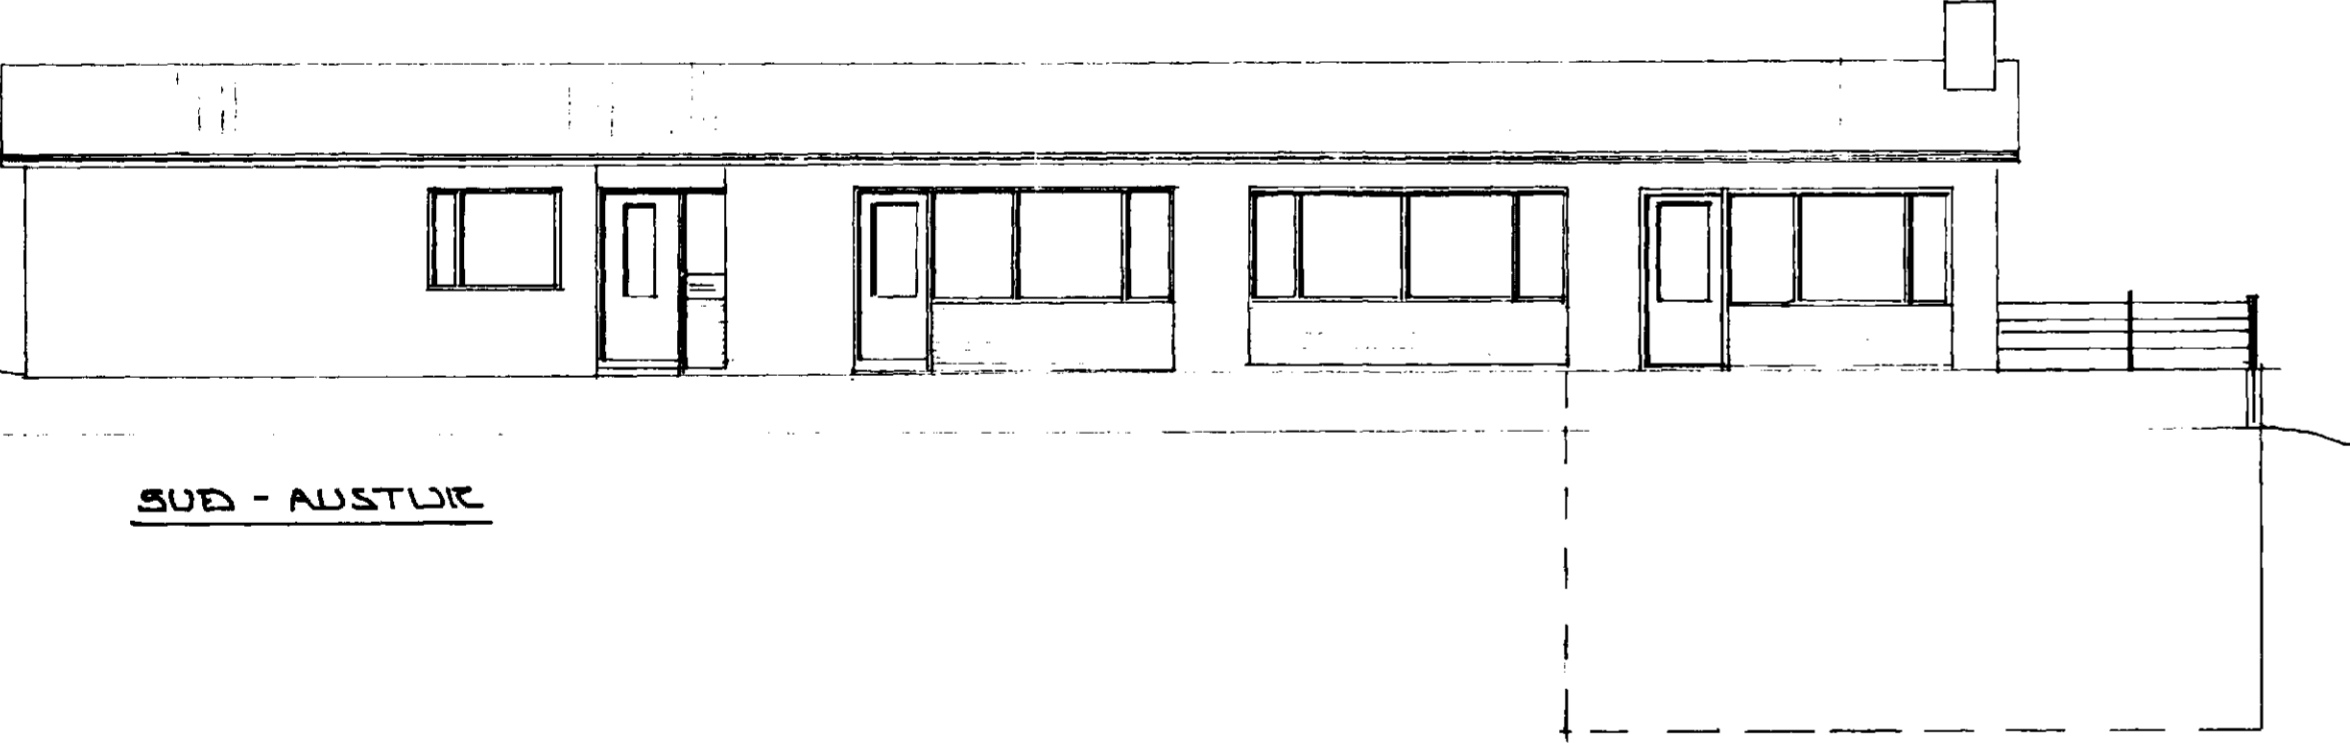

02  
 $350 \times 12,00 = 4200 \text{ m}^2 \times 4,5 = 18900$   
 $1425 \times 895 = 1275375 \text{ m}^2 \times 2,7 = 3443912,5$   
 $1778 \text{ m}^2$   
 $169,5 \text{ m}^2$   
 $395 \times 1659 = 655305$   
 $4779$   
 $3220$   
 $62000$   
 $638$

01  
6020-0230-02

BR NR	DAGS	EDLI	BREYTINGAR	SIGN
MELABRAUT 23 HAFNARFIRDI				DAGS FRÓF '85
VIÐBYGGING VIÐ KJALLARA.				HAJAJAB
ÚTLIT OG GRUNNMYND				TEIKAUÐI
MELIKV.				VERK NR 8408
SIGURÐUR ÞORLEIFSSON TEKNIFRÉÐINGUR F.M.F.I.				BLAÐUR
STRANDGÖTU 11 HAFNARFIRDI SÍMI 54751				