
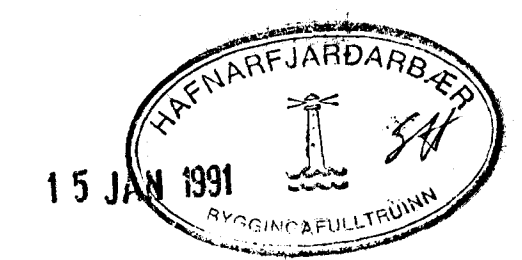


GRUNNMYND 1:50

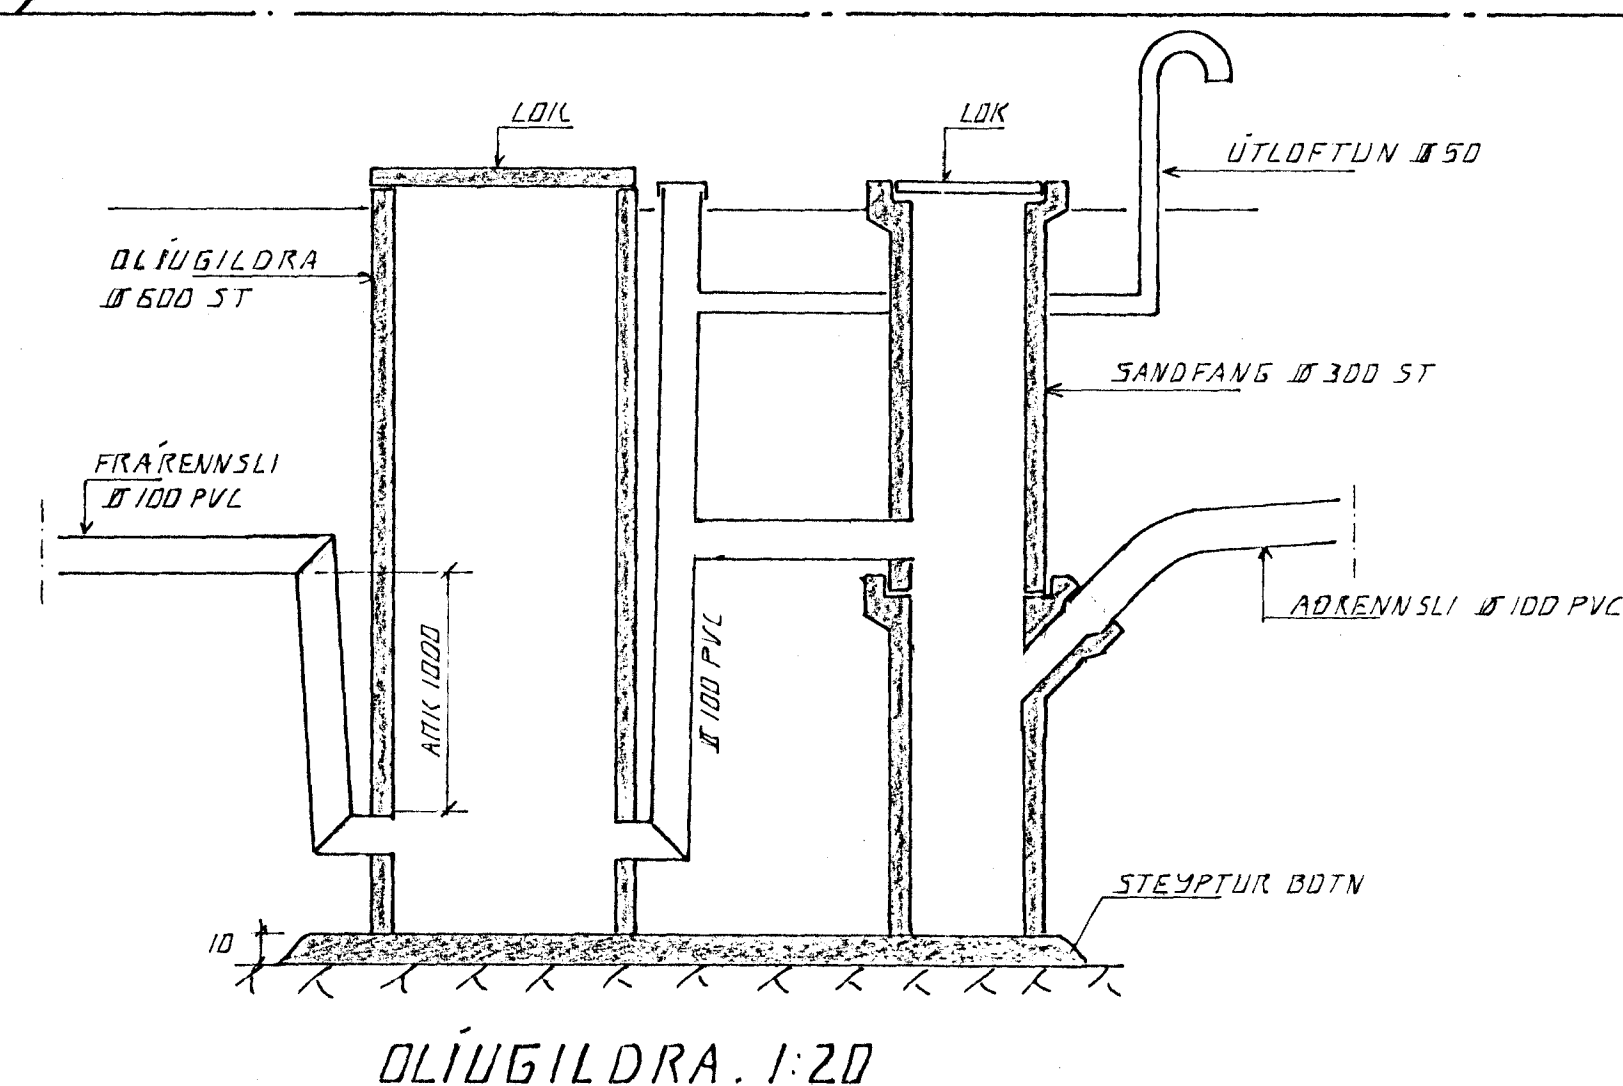

1 14191		SÉRMYND AF OLUGILDROU		921
BR. NR.	DAGS	EÐLI BREVTINGAR.		SIGN.
MELABRAUT 25		HAFNARFIRÐI		DAGS
GRUNNMYND - GRUNNLAGNA				MAÑNAD
MÆLIKV. 1:50				TEIKNAD
SIGURÐUR ÞORLEIFSSON		TEKNIKERINGUR F.T.F.I.		VERK NR.
STRANDGÖTU 11		HAFNARFIRÐI		8926
SÍMI 54751/54255				BLAD NR.
				2-02A