
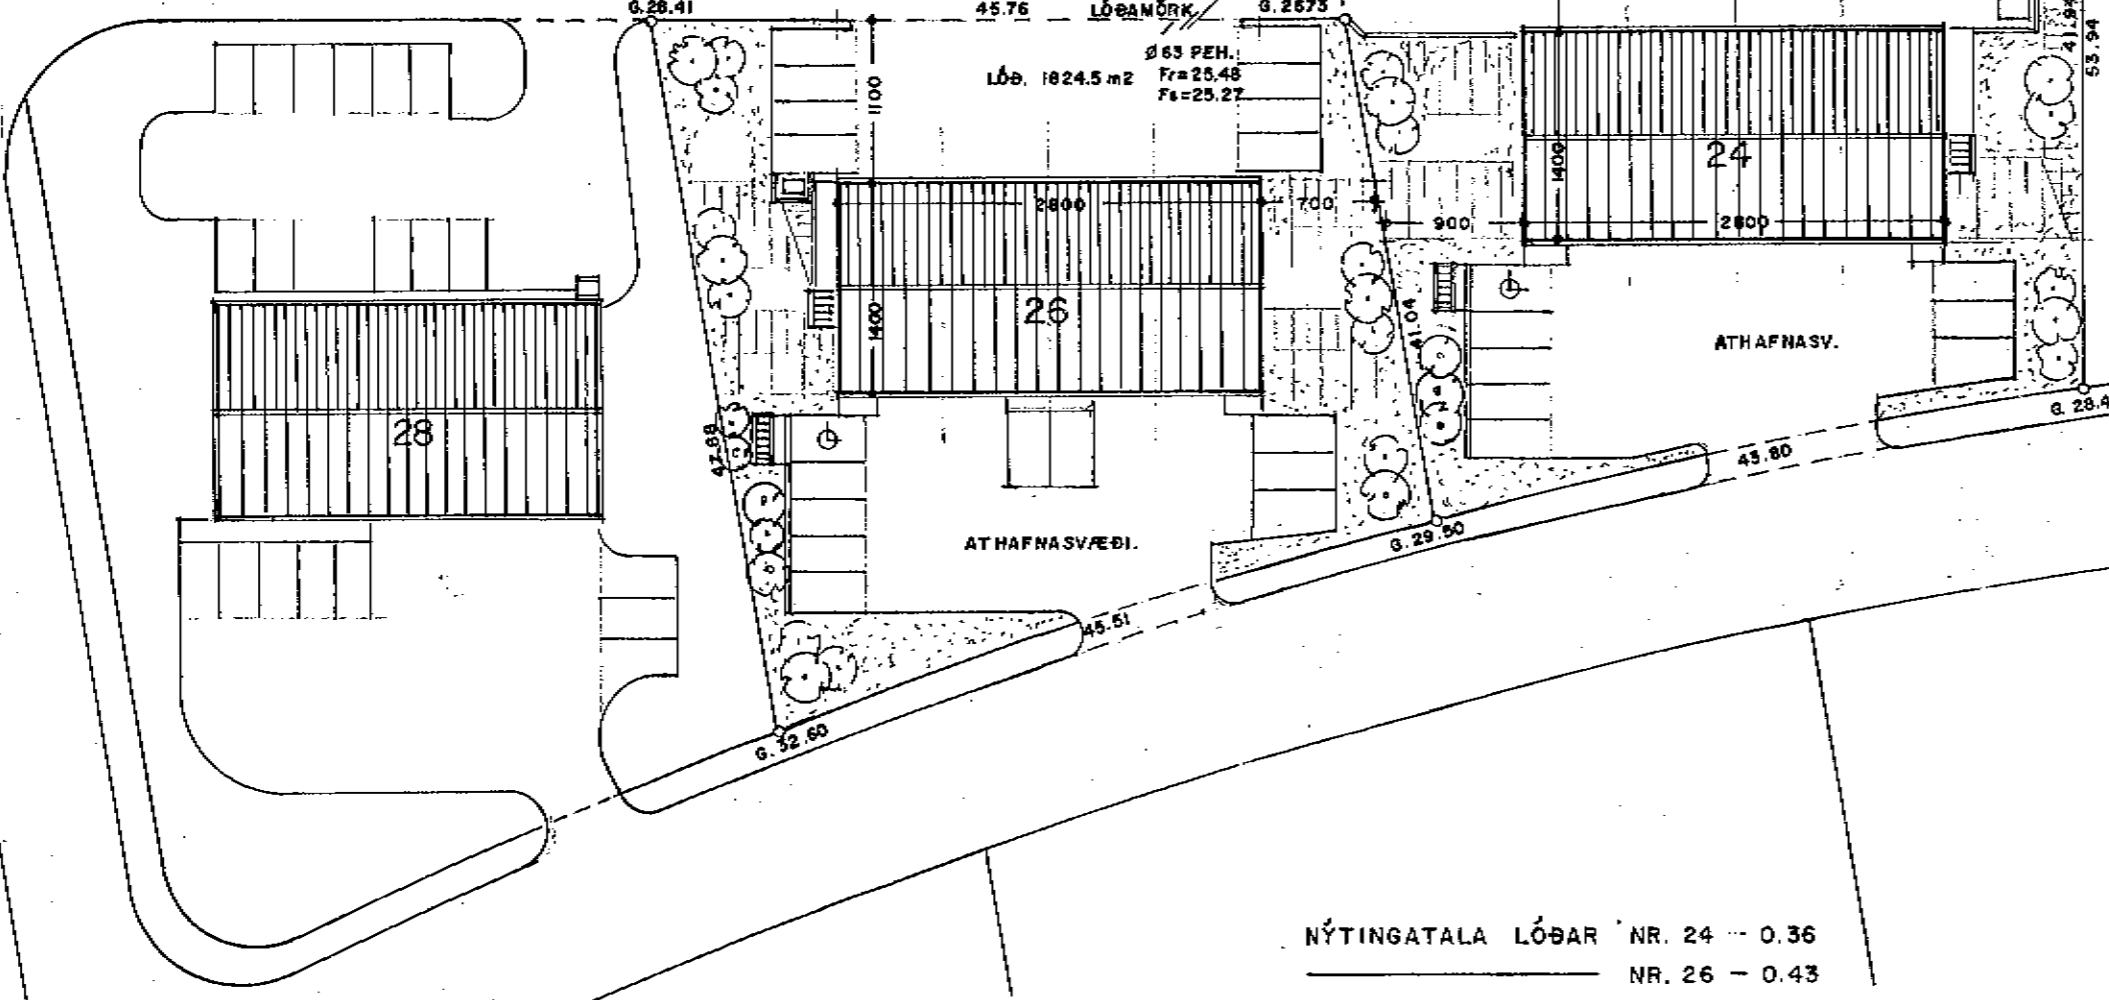
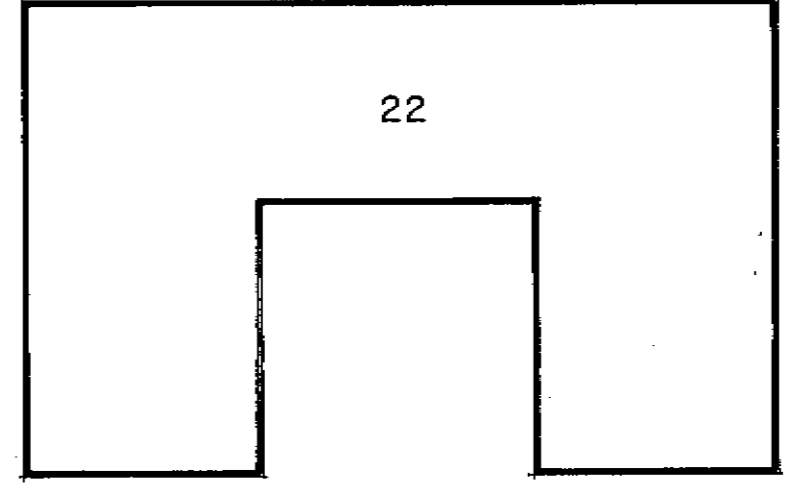
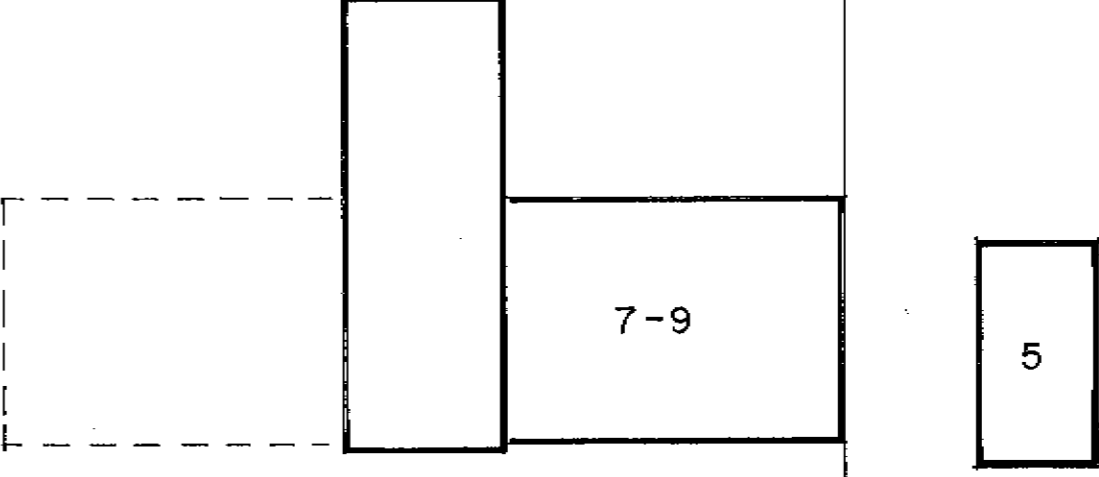
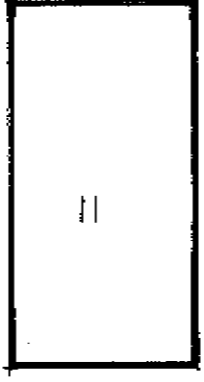


EYRARTRÖÐ.

HVALEYRARBRAUT.

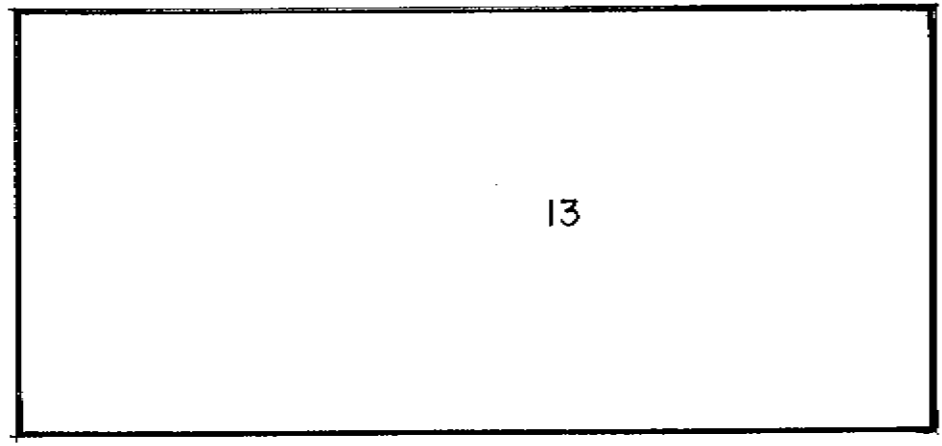

NÝTINGATALA LÓBAR NR. 24 - 0.36
NR. 26 - 0.43

MELABRAUT.

AFSTÖÐUMYND. 1:500

BREYTT. BILASTÆÐUM VIÐ 2. HÆÐ
Á HÚSINU NR. 26. 10.-1.-2004.

MELABRAUT 24-26 HAFNARFIRÐI. AFSTÖÐUMYND.

VERK. NR. 199 DAGS. 17.-11.-1998 MÁL. 1:500
TEIKN. NR. 01 BREYTT.

JON GUÐMUNDSSON ARKITEKT *Jon Guðmundsson*
VINNUSTOFA.: SKÚLAGÖTU 63 REYKJAVÍK. Sími. 552-5055