


E. Sigurðsson

BLAÐ 2

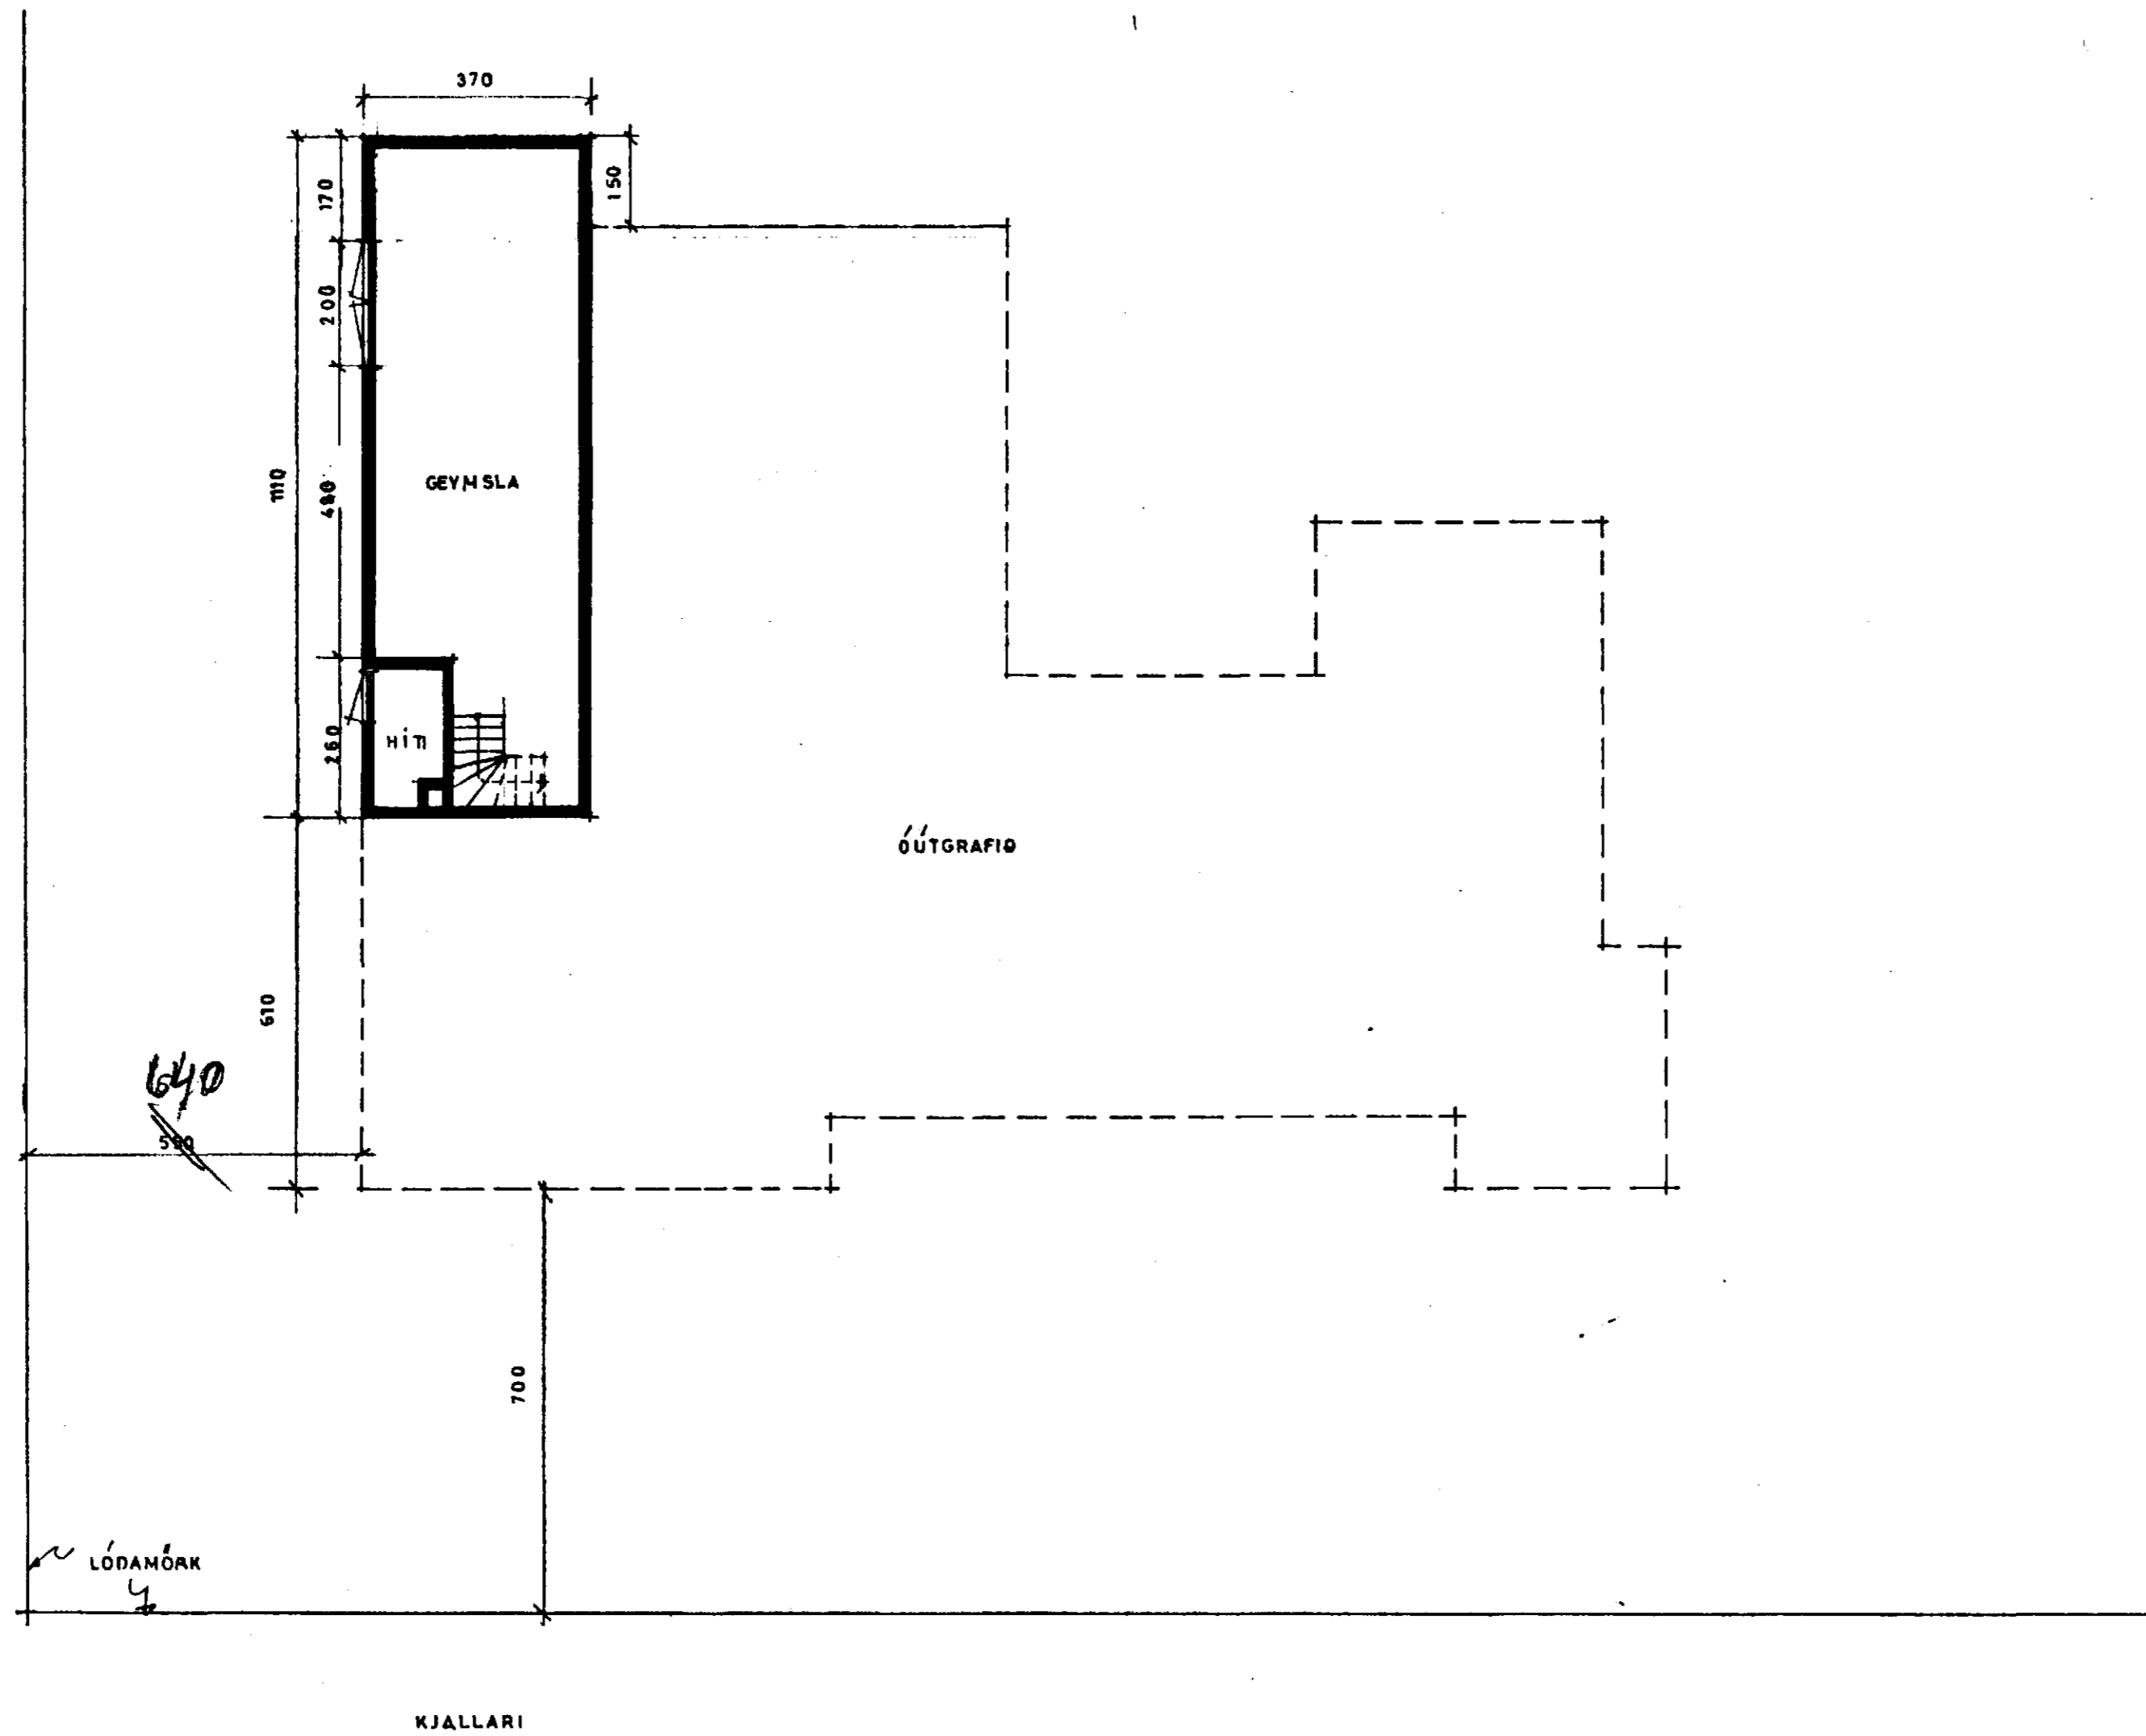

$$\begin{array}{r}
 370 \times 11,10 = 41,0 \text{ m}^2 \\
 \times 2,35 \\
 \hline
 96,0 \text{ m}^3
 \end{array}$$

E. H. HERTERDÓTTIR