


7218
BL. 5

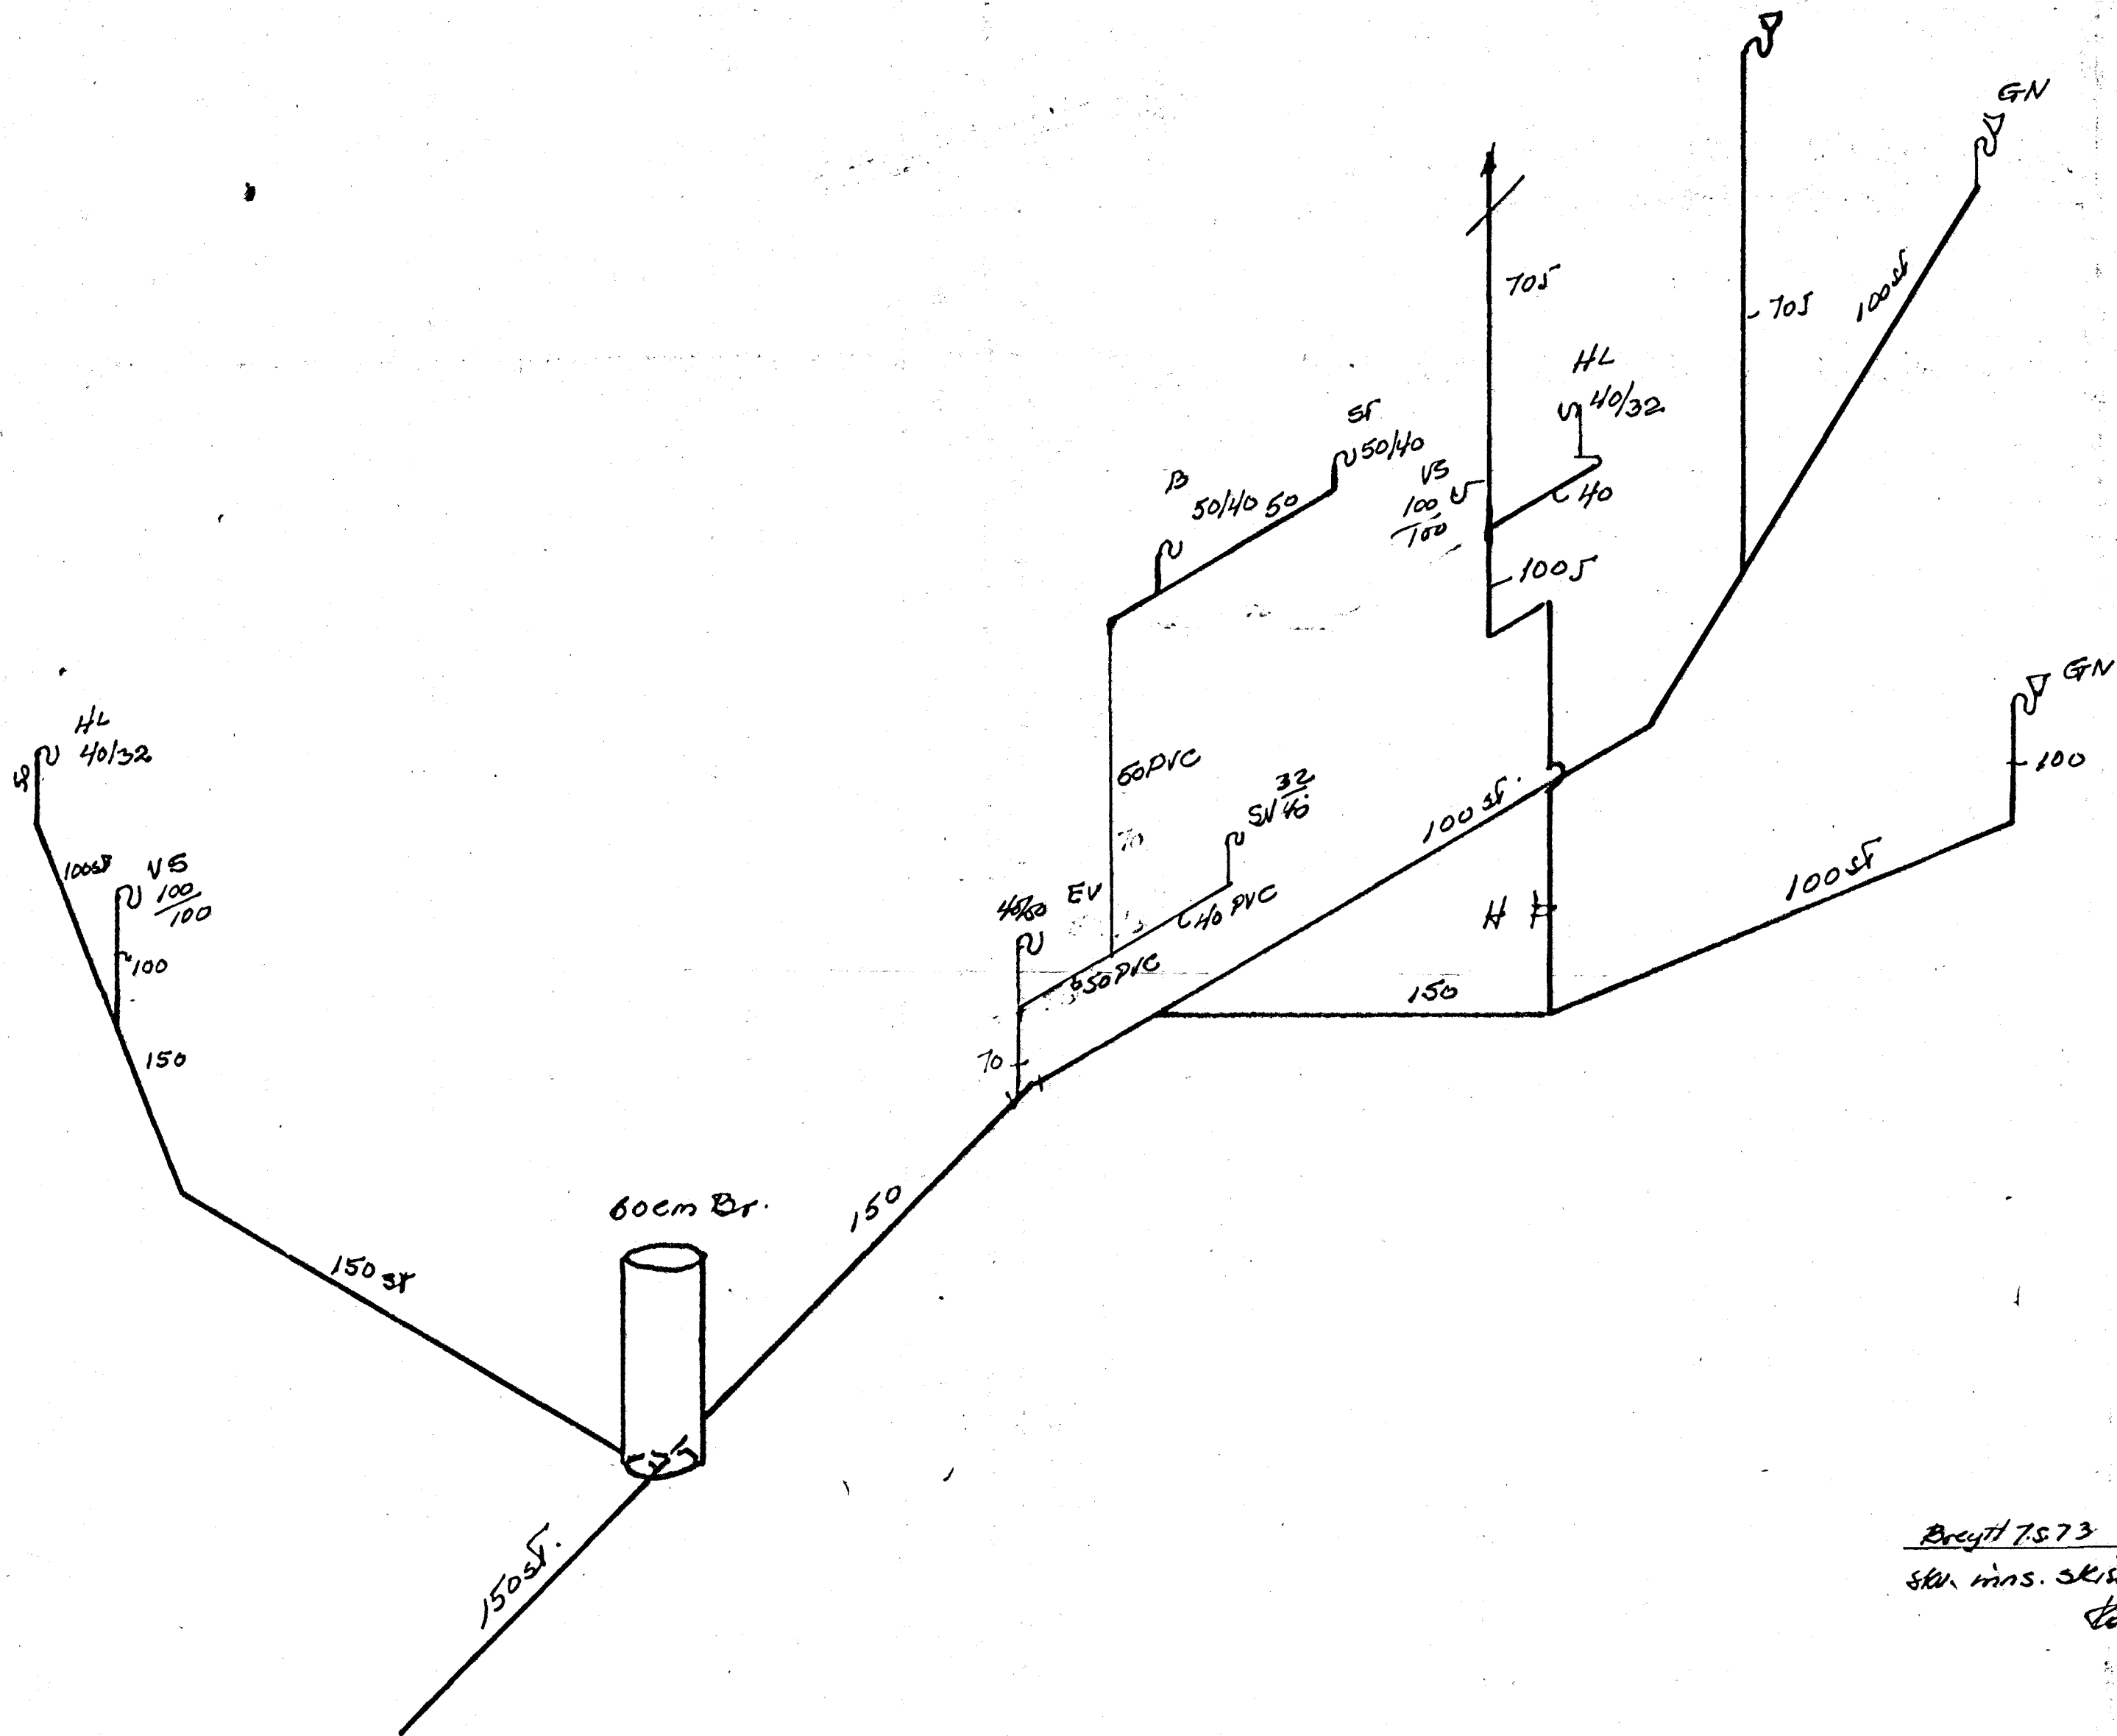

Bright 7.5.73
SKR. ins. skissu
Jab.

MIBVANGUR 141	TEKNIK. NIB
Kolbaind & Co. Janssen	7218
	TEKNIK. NIB 16372