


ARÞÓÐUNYND 1:500

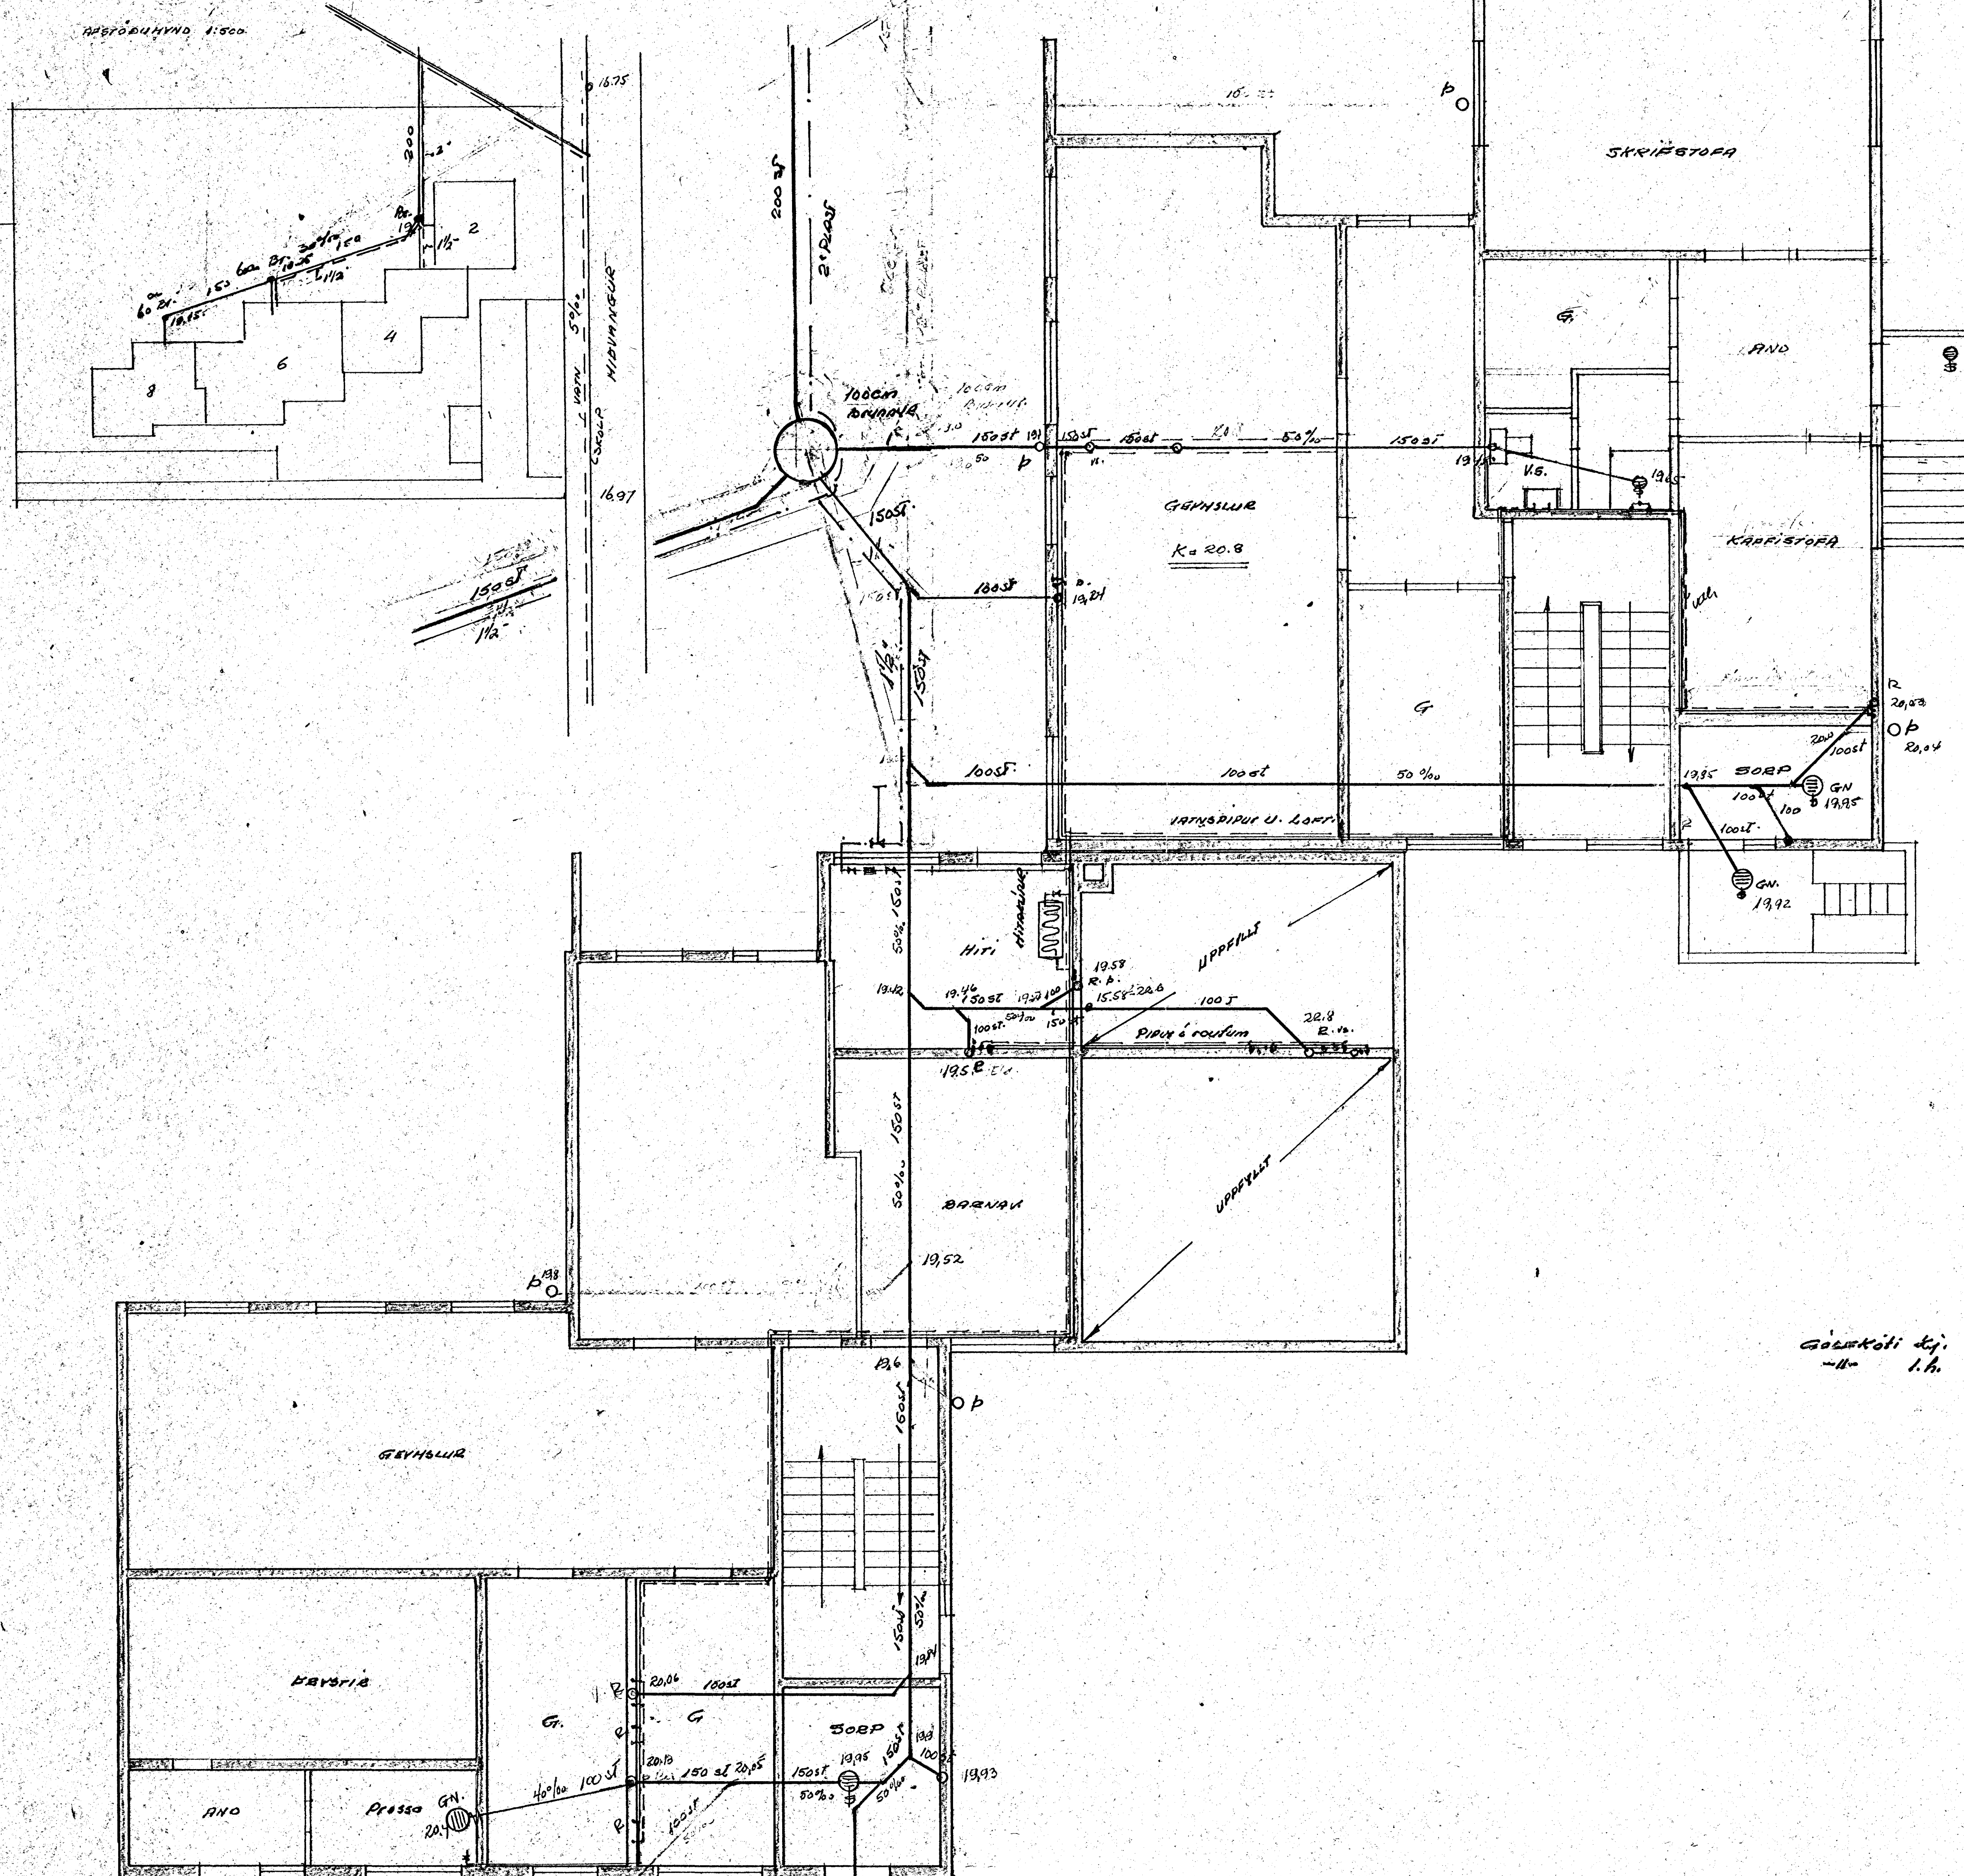

BREIT 20.12.71

Gólfkoti kj. = 20.8
-ll- l.h. = 233

Pr. 17.8.71
tbl.

MÍÐVANGUR 2-4 SKOLP & VATA KJALLARI	1:50	DRAS. 20.12.70
		TEIEM. K.K.G.J.
KOLBEINN K.F. JÓNSSON TECHN. HRFI		Dr. 10.2.71
		TEIEM. NB.
		7029
	Bl. 1.	