
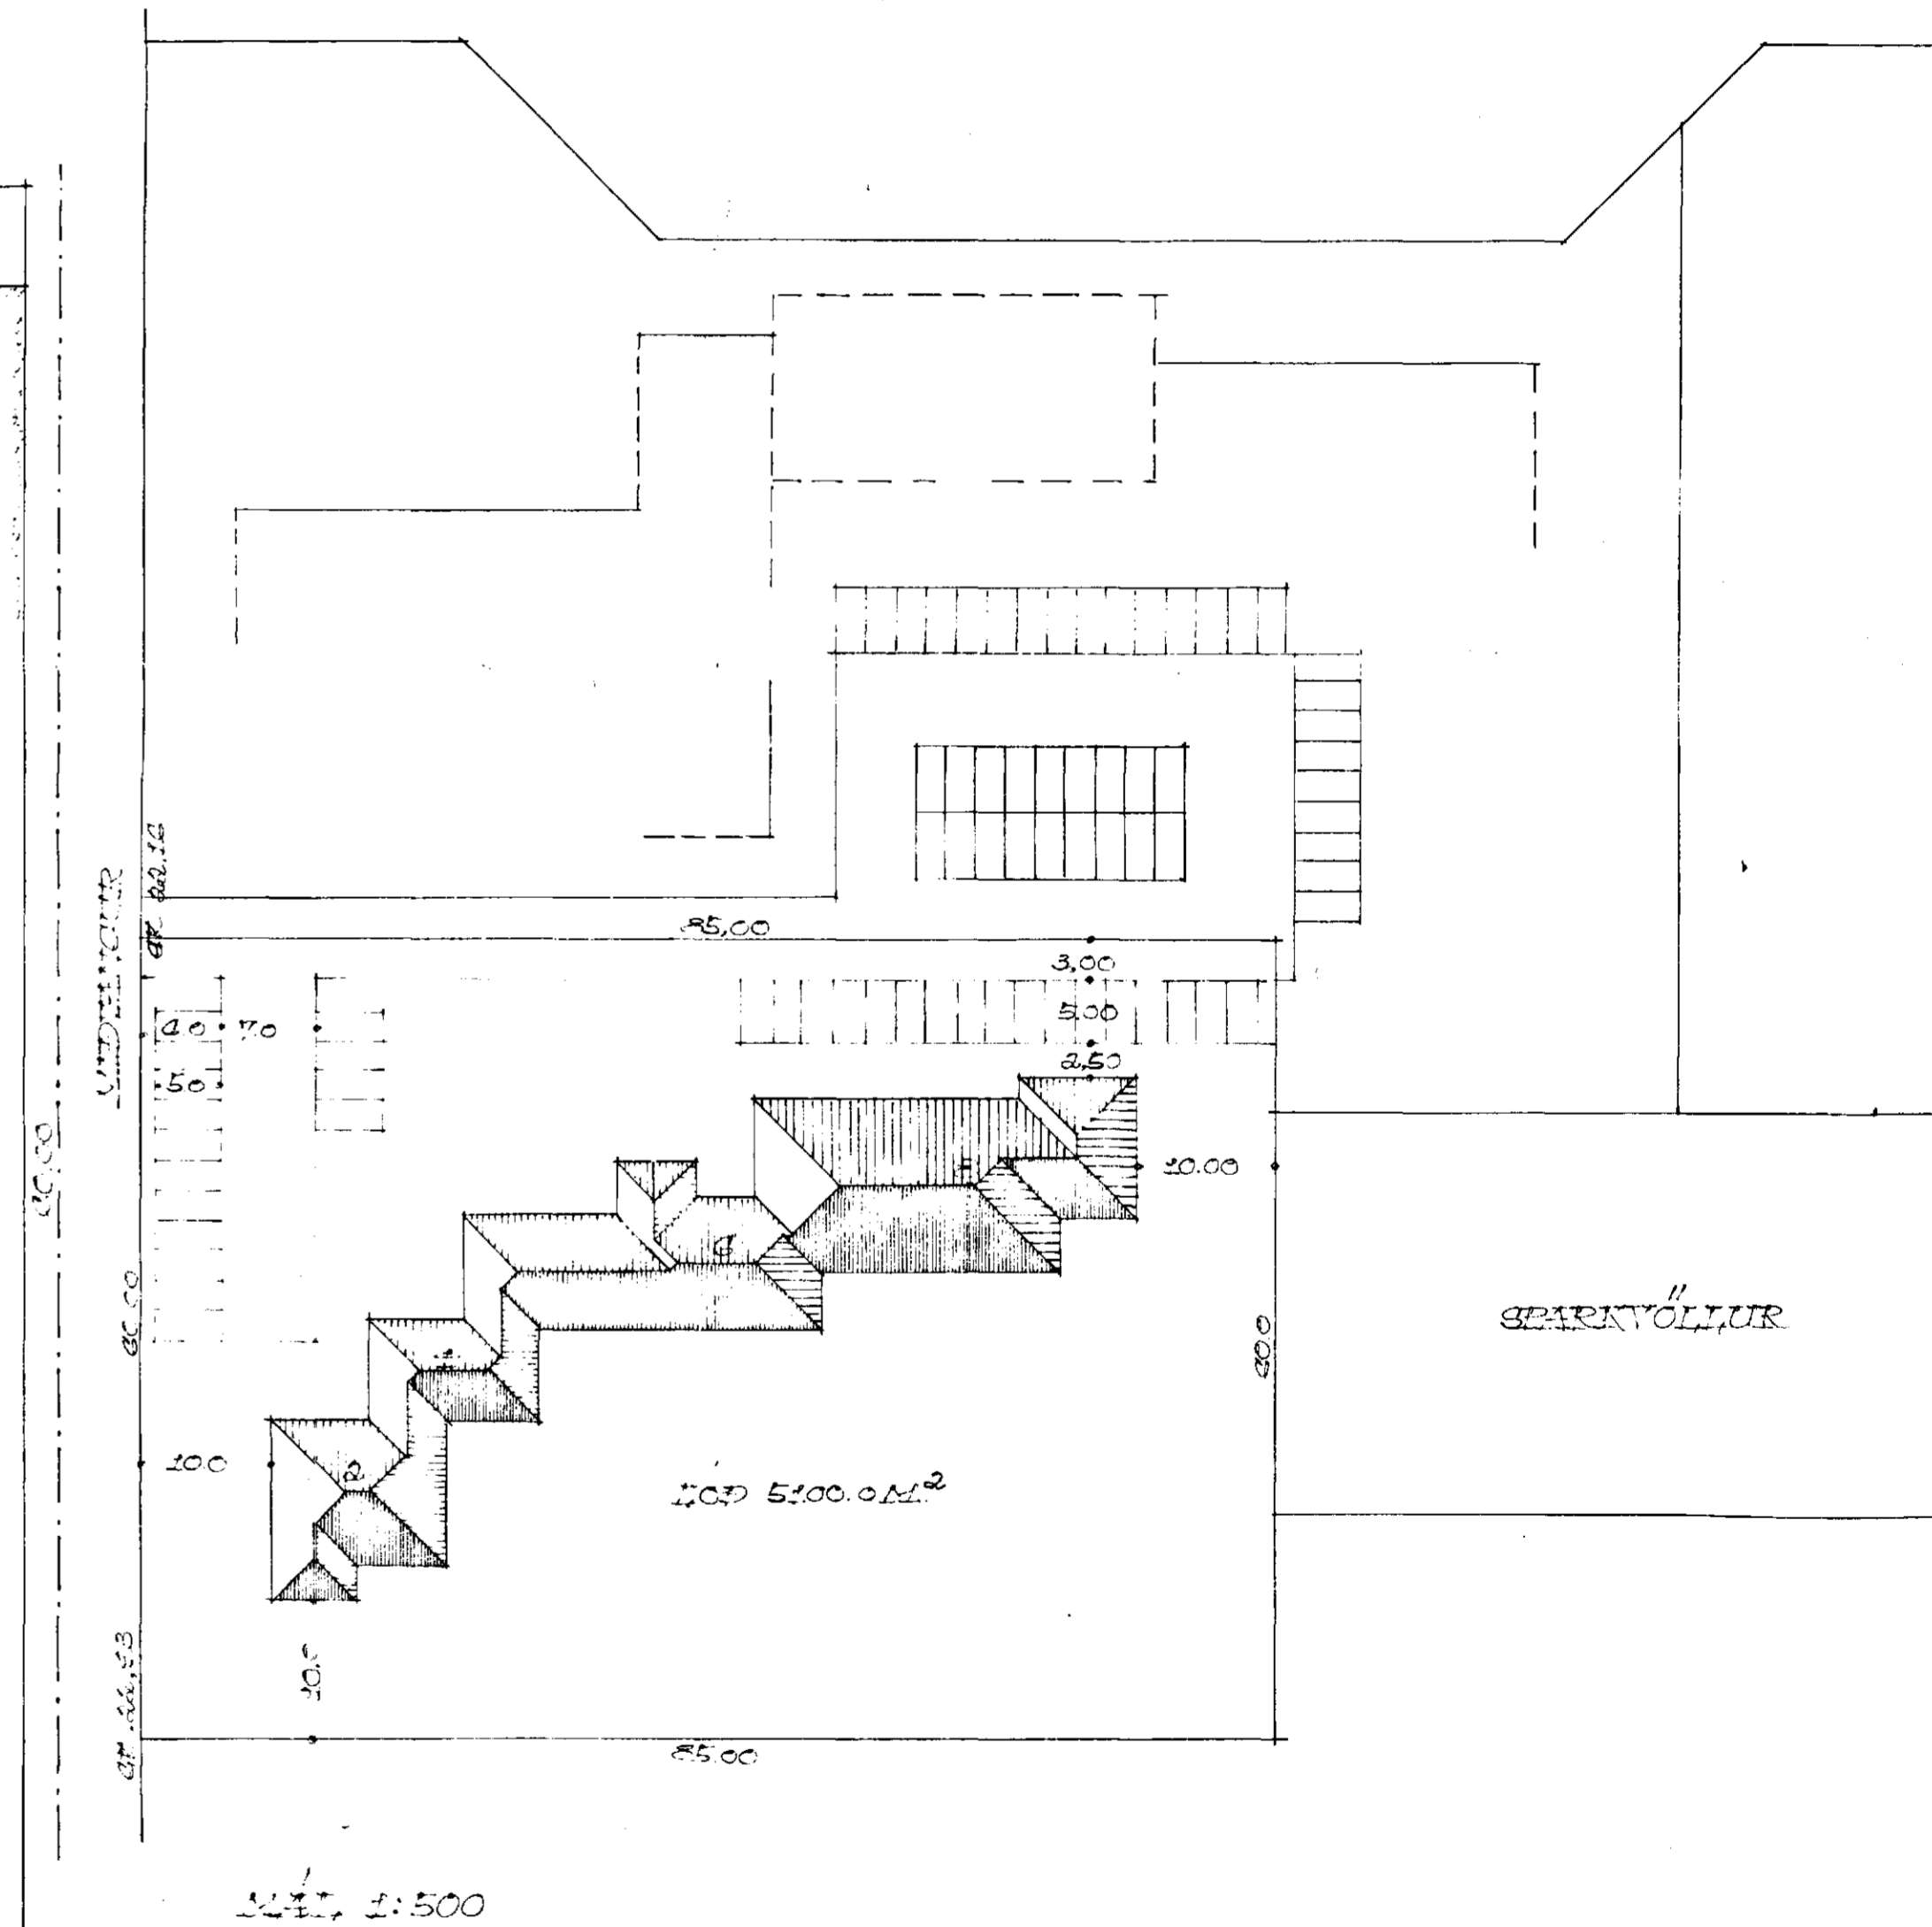


Setja smál skjólveggi á allar
gælt. SamíðHúll opnan-
legga glugga lagfæst.
Bent er á framgæti á gættum

FLATARMÁL HÚSS NR. 2 150,49 M²
FLATARMÁL HÚSS NR. 4 801,72 M²
FLATARMÁL HÚSS NR. 6 870,02 M²
FLATARMÁL HÚSS NR. 8 205,09 M²
ALLS 233,32 M²

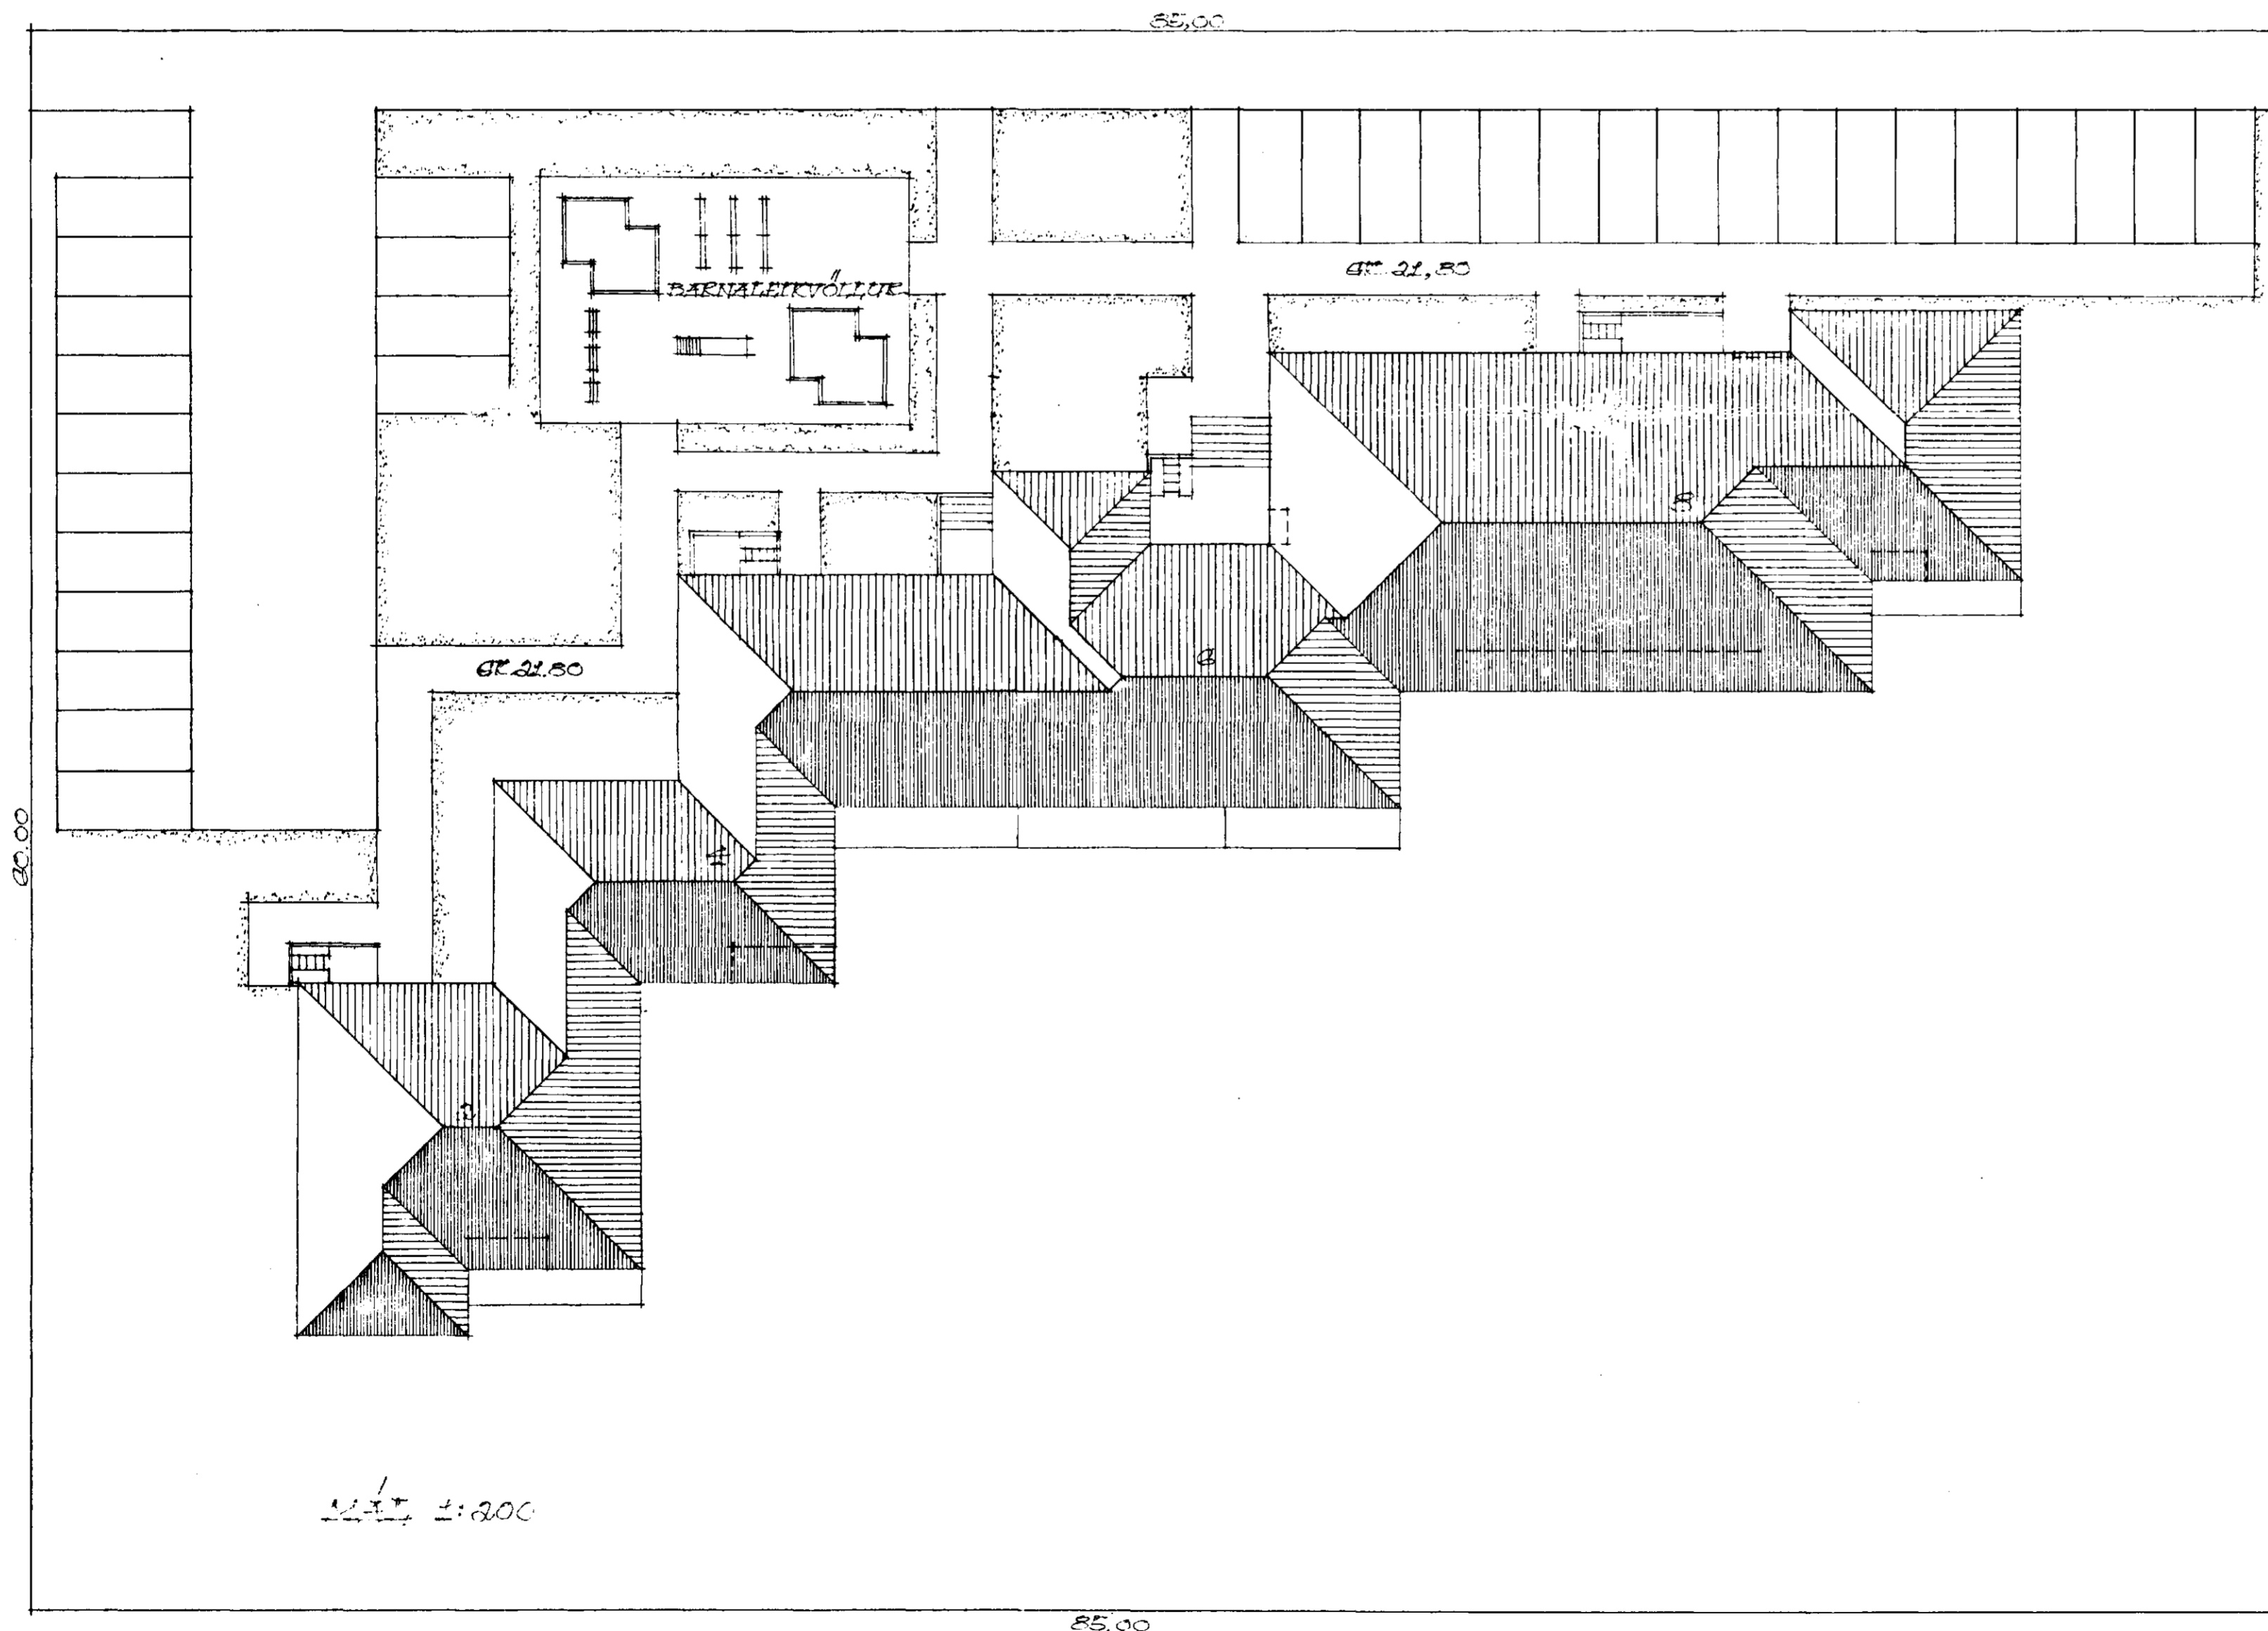

REFRUKJÓK I FEBRÚAR 1970
Sjartan Sveinsson