





Sampykkt þann

09 MAÍ 2001

Byggingafróunir í Hafnarfirði
Eriendur Hjálmarsson

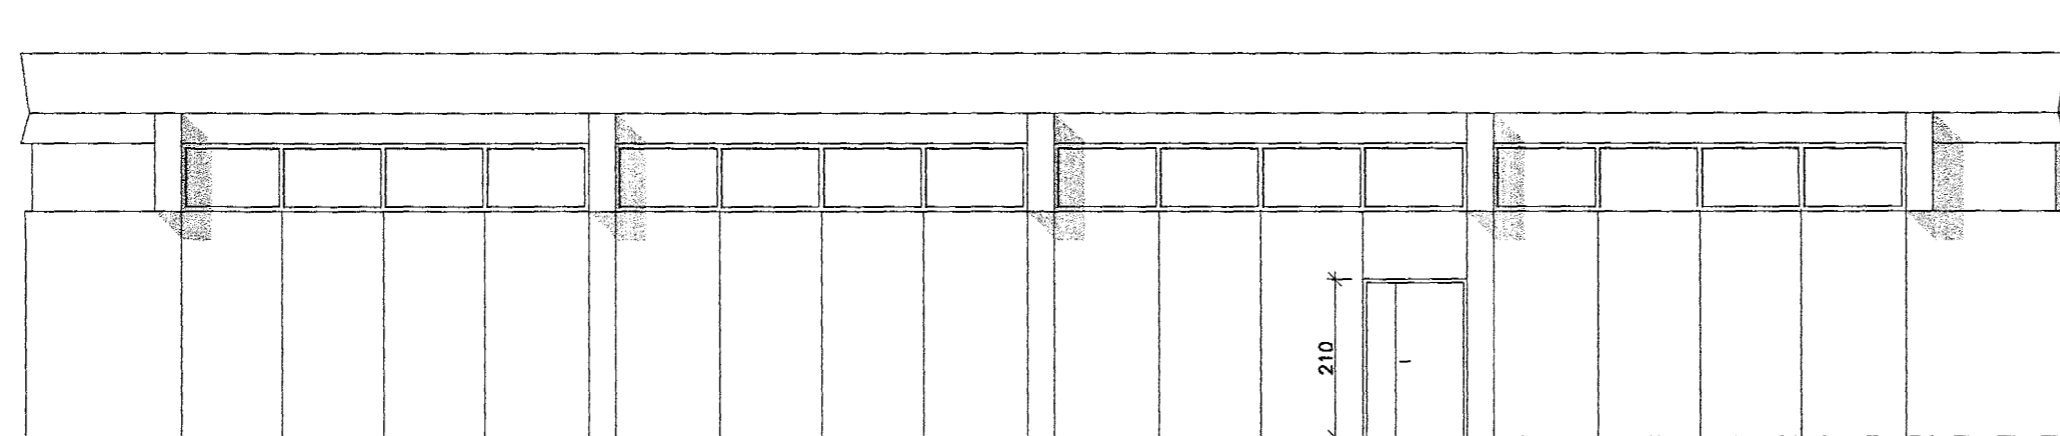

AUSTURHLID

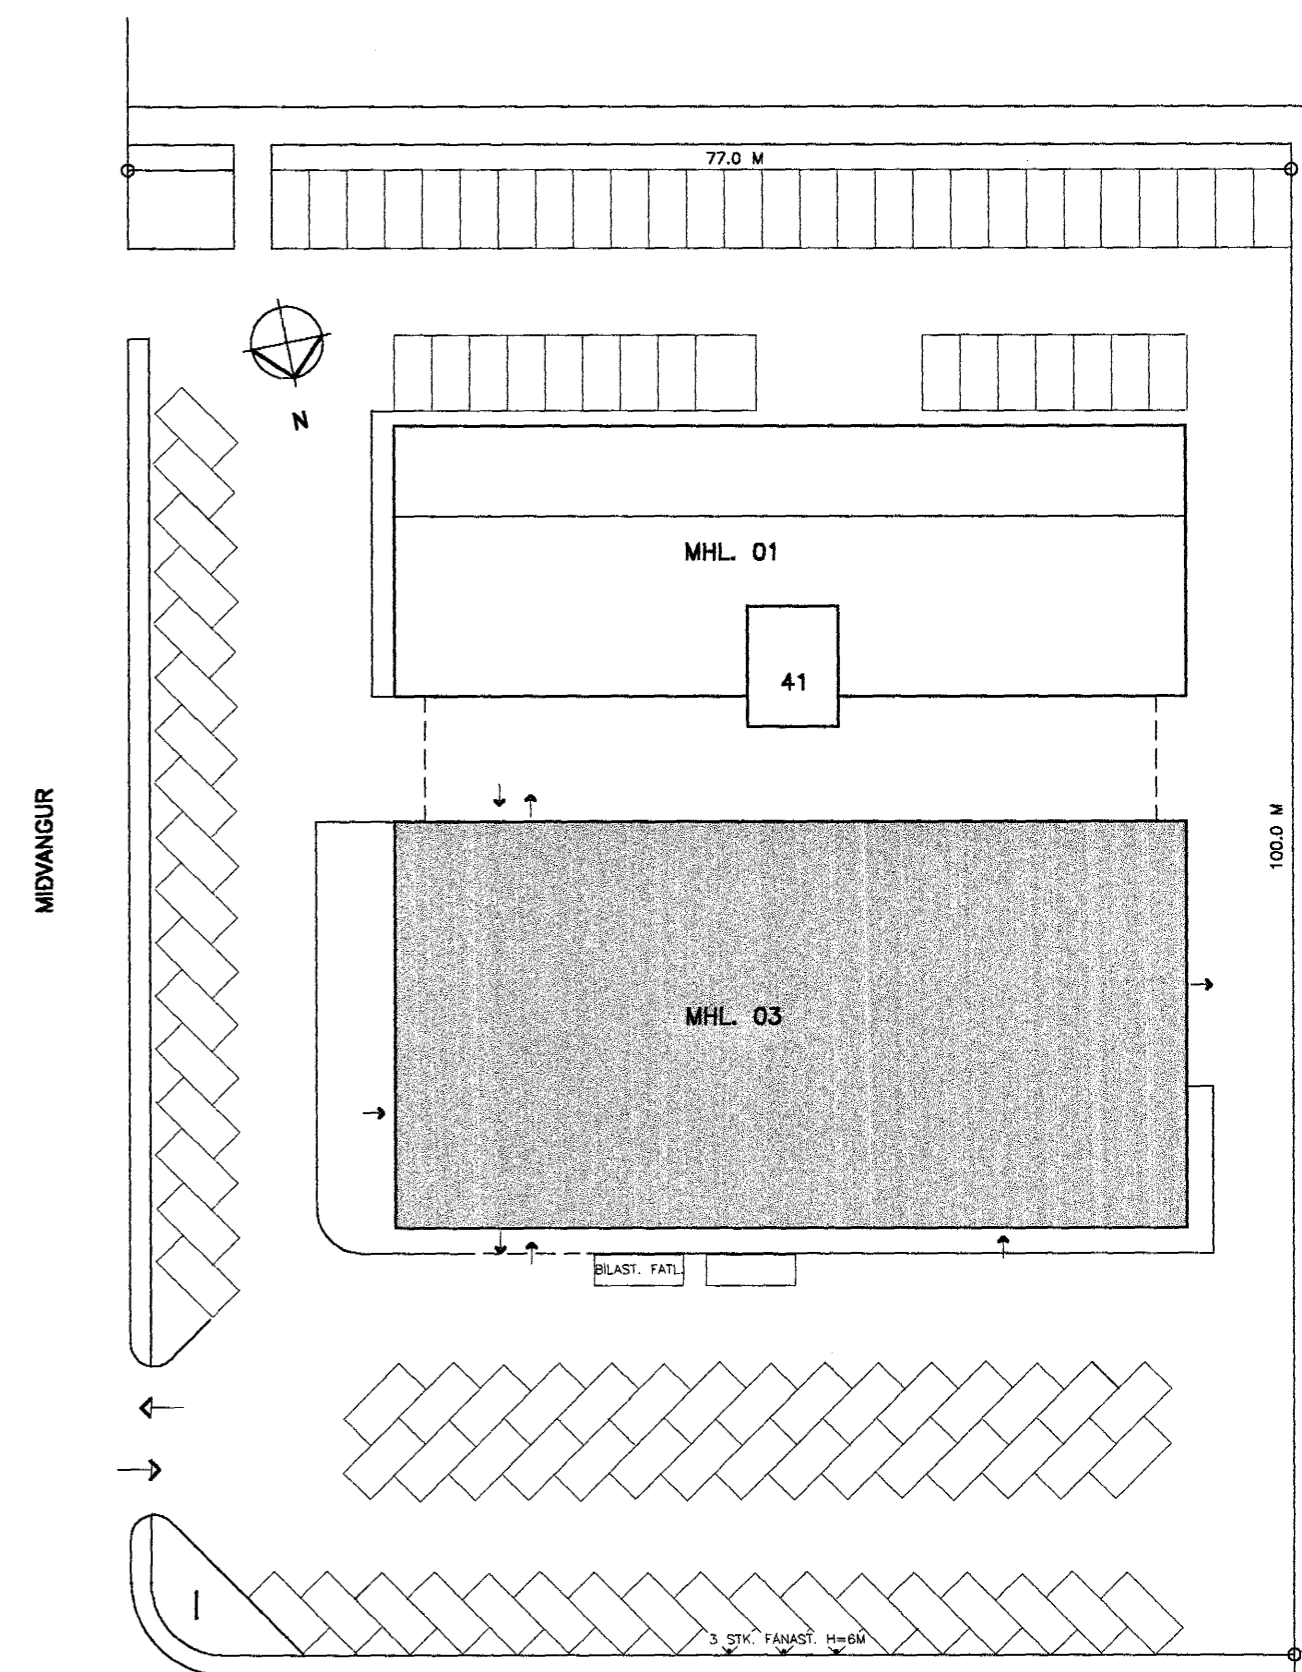

MIDVANGUR

HJALLABRAUT

AFSTÖÐUMYND M.1:500



NYJA
TEIKNISTOFAN HF
SÍÐUMÍLA 20
108 REYKJAVÍK
SÍMI 568 8899 FAX 568 0868

SAMKAUP MIDVANGUR 41 HAFNARFIRÐI

BREYTT NY HURD Á AUSTURHLID
ÚTLIT AUSTURHLID OG AFSTÖÐUMYND

VERK NR 2
MÁL 1:100 1:500 DAGS 27.03.2001

TEIKNAD Eriendur Hjálmarsson KT.190534-4489