


GRUNNMÝND 2. HÆÐ 1:100

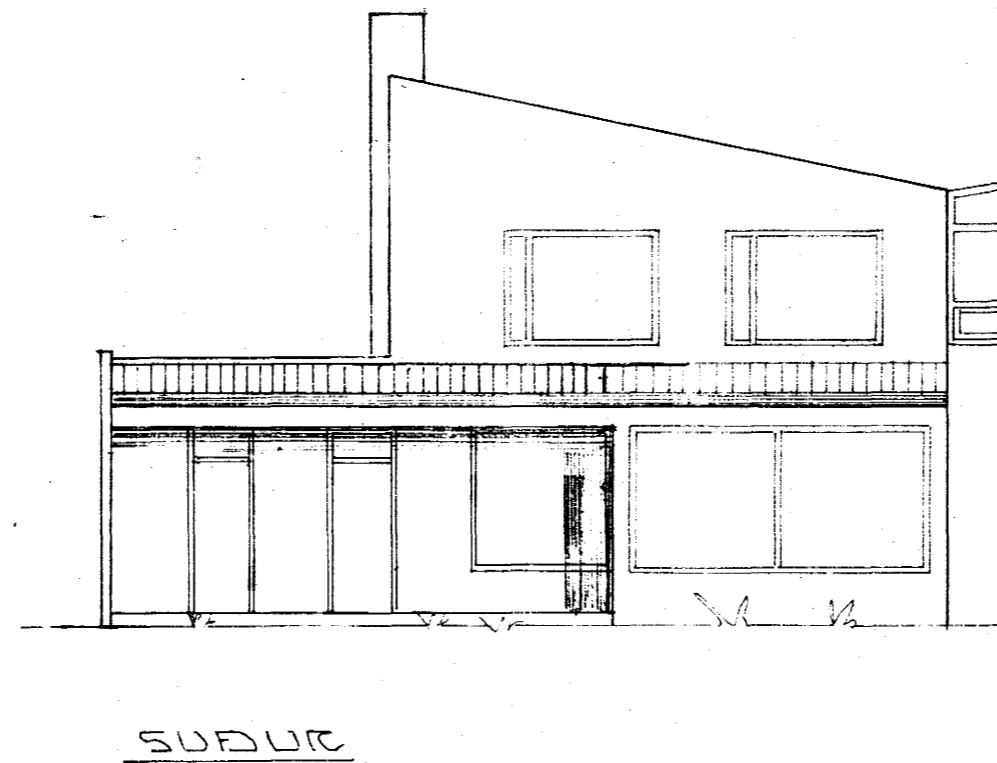

SUÐUR

SAMÞYKKUR BREVINGU A HÚSI NR. 73 SAMKV. TEIKNINGU


NR. 63 Karl Agústrsson

NR. 65 Þagbjört Guðjónsdóttir


NR. 67 Kristinn Guðmarsson 2808372029

NR. 69 Ólafur Haraldsson


NR. 71 Erling Þ. Ólafsson

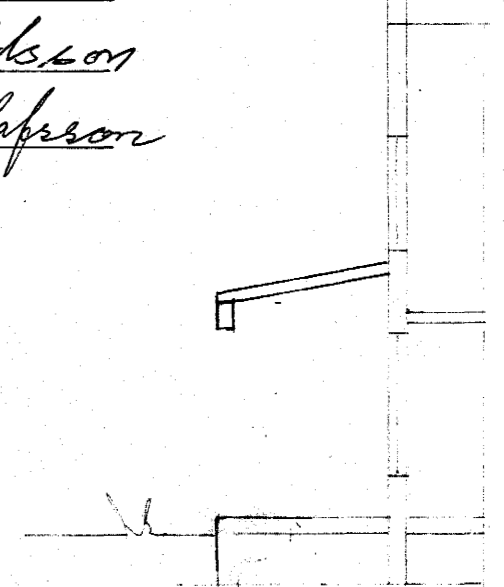


SNÍÐ B - B 1:100

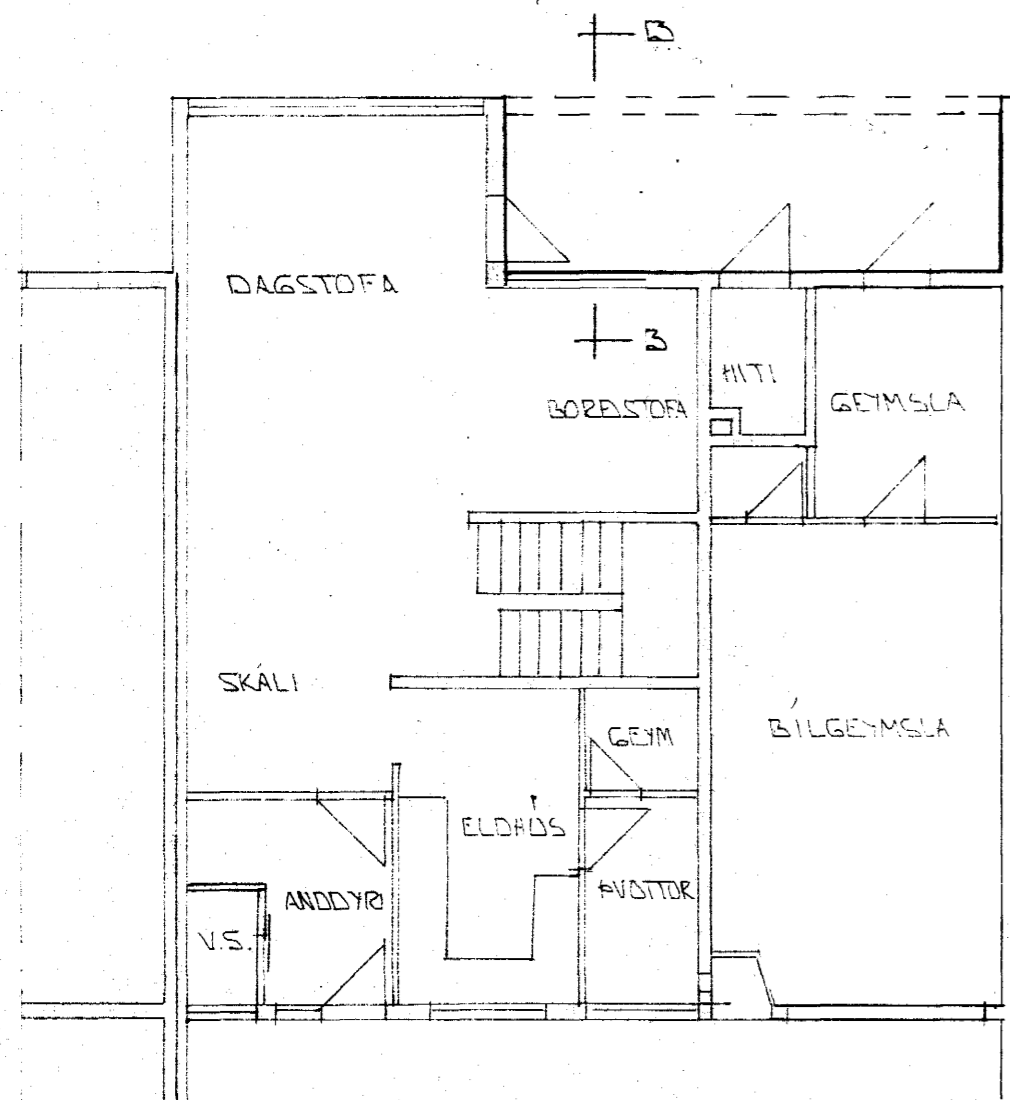

GRUNNMÝND 1. HÆÐ 1:100

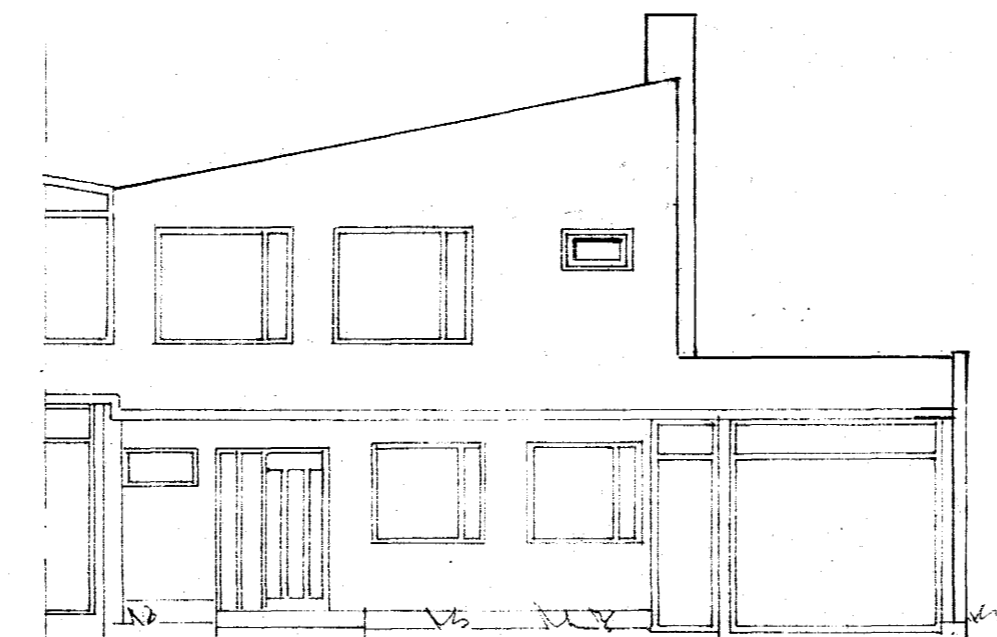

NORÐUR

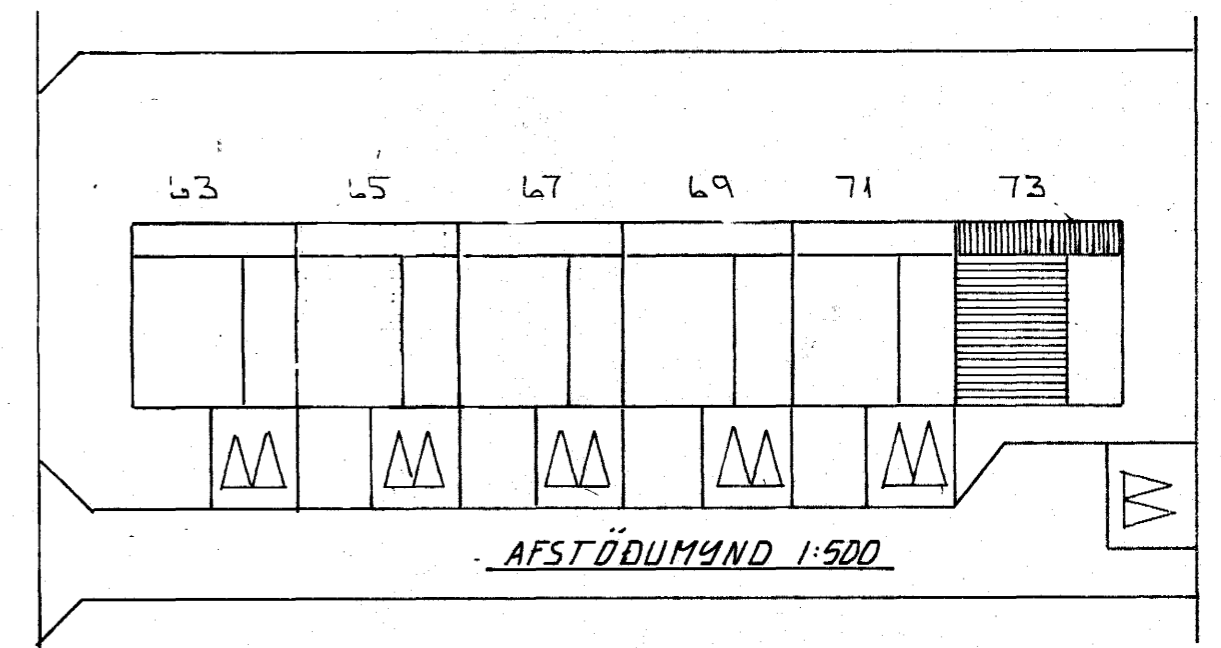

AFSTÖÐUMÝND 1:500

SKYRINGAR:

HÚS UPPHAFLEGA TEIKNAD AF KJARTANI SVEINSSYNI Í MAÍ '71.

BR.NR.	DAGS	EDLI BREVINGAR	SIGN.
		MÍÐVANGUR 73 HAFNARFIREI	DAGS MAÍ '94
		ÞAK YFIR SÓLPALL.	HANNAÐ 9/71
			TEIKNAD 6/71
			VERK NR. 9420
		MELIKV. 1:100	BLAD NR.
		SIGURÐUR ÞORLEIFSSON TEKNIFRÆÐINGUR F.T.F.I.	
		STRANDGÖTU 11 HAFNARFIREI SIMI 54751	