


AFSÖÐUNYND 1:500

SPARKVÖLLUR

18

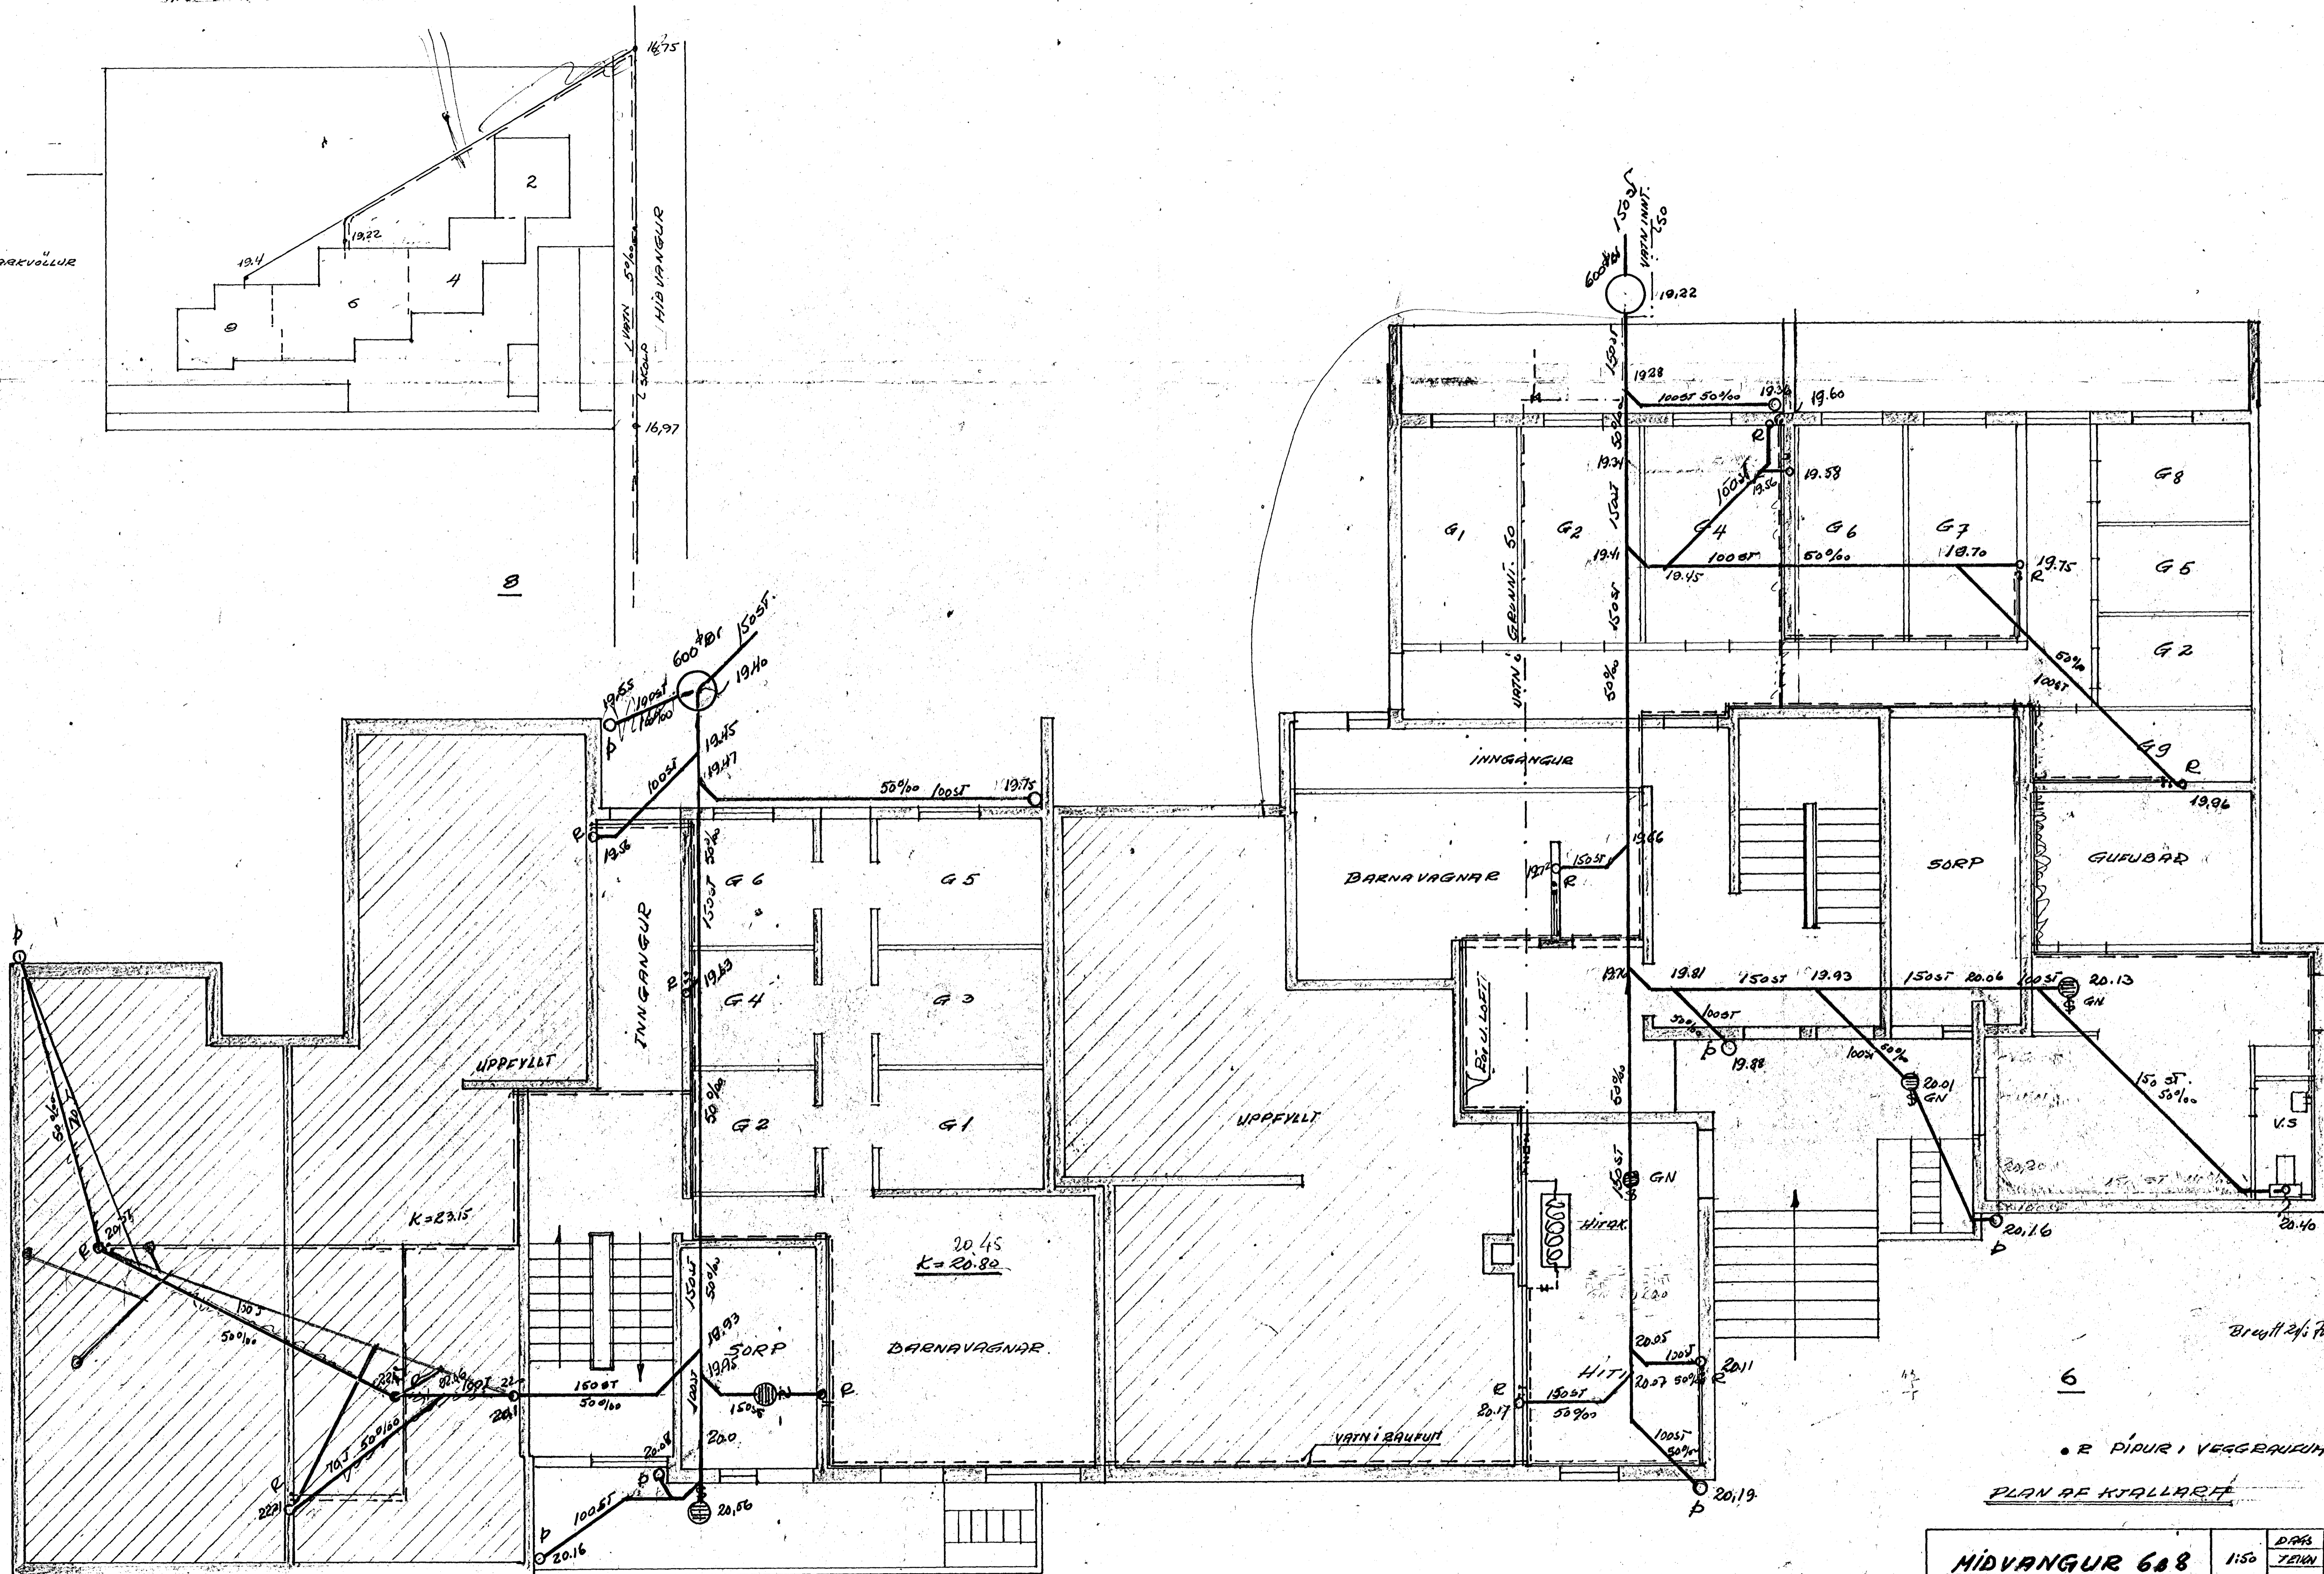

PLAN AF KTALLARIT

MIDVANGUR 608 SKOÐP & VATN Koblium & foun- Talsuði	1:50	DAGS TEYNI	20/11/70
	TALMEN NR 70103		BL. 1