

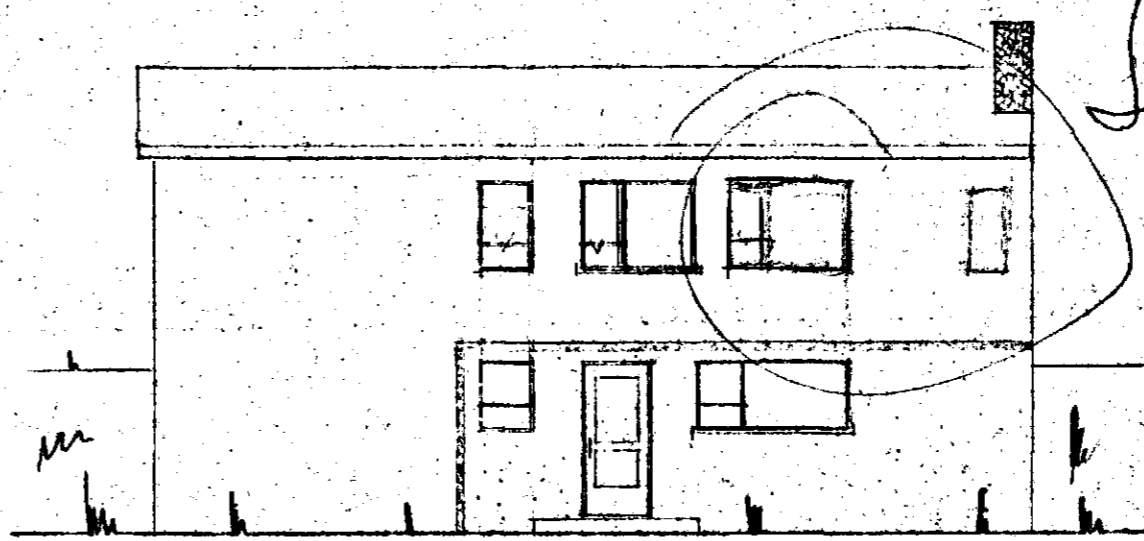
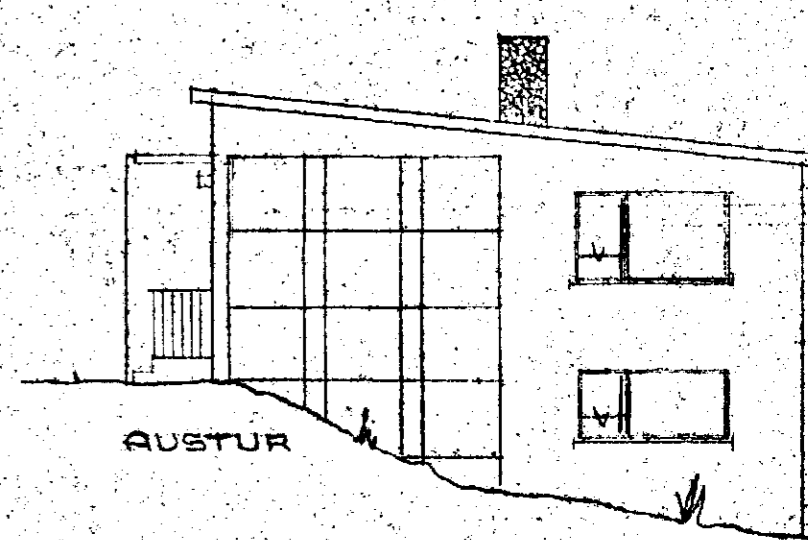
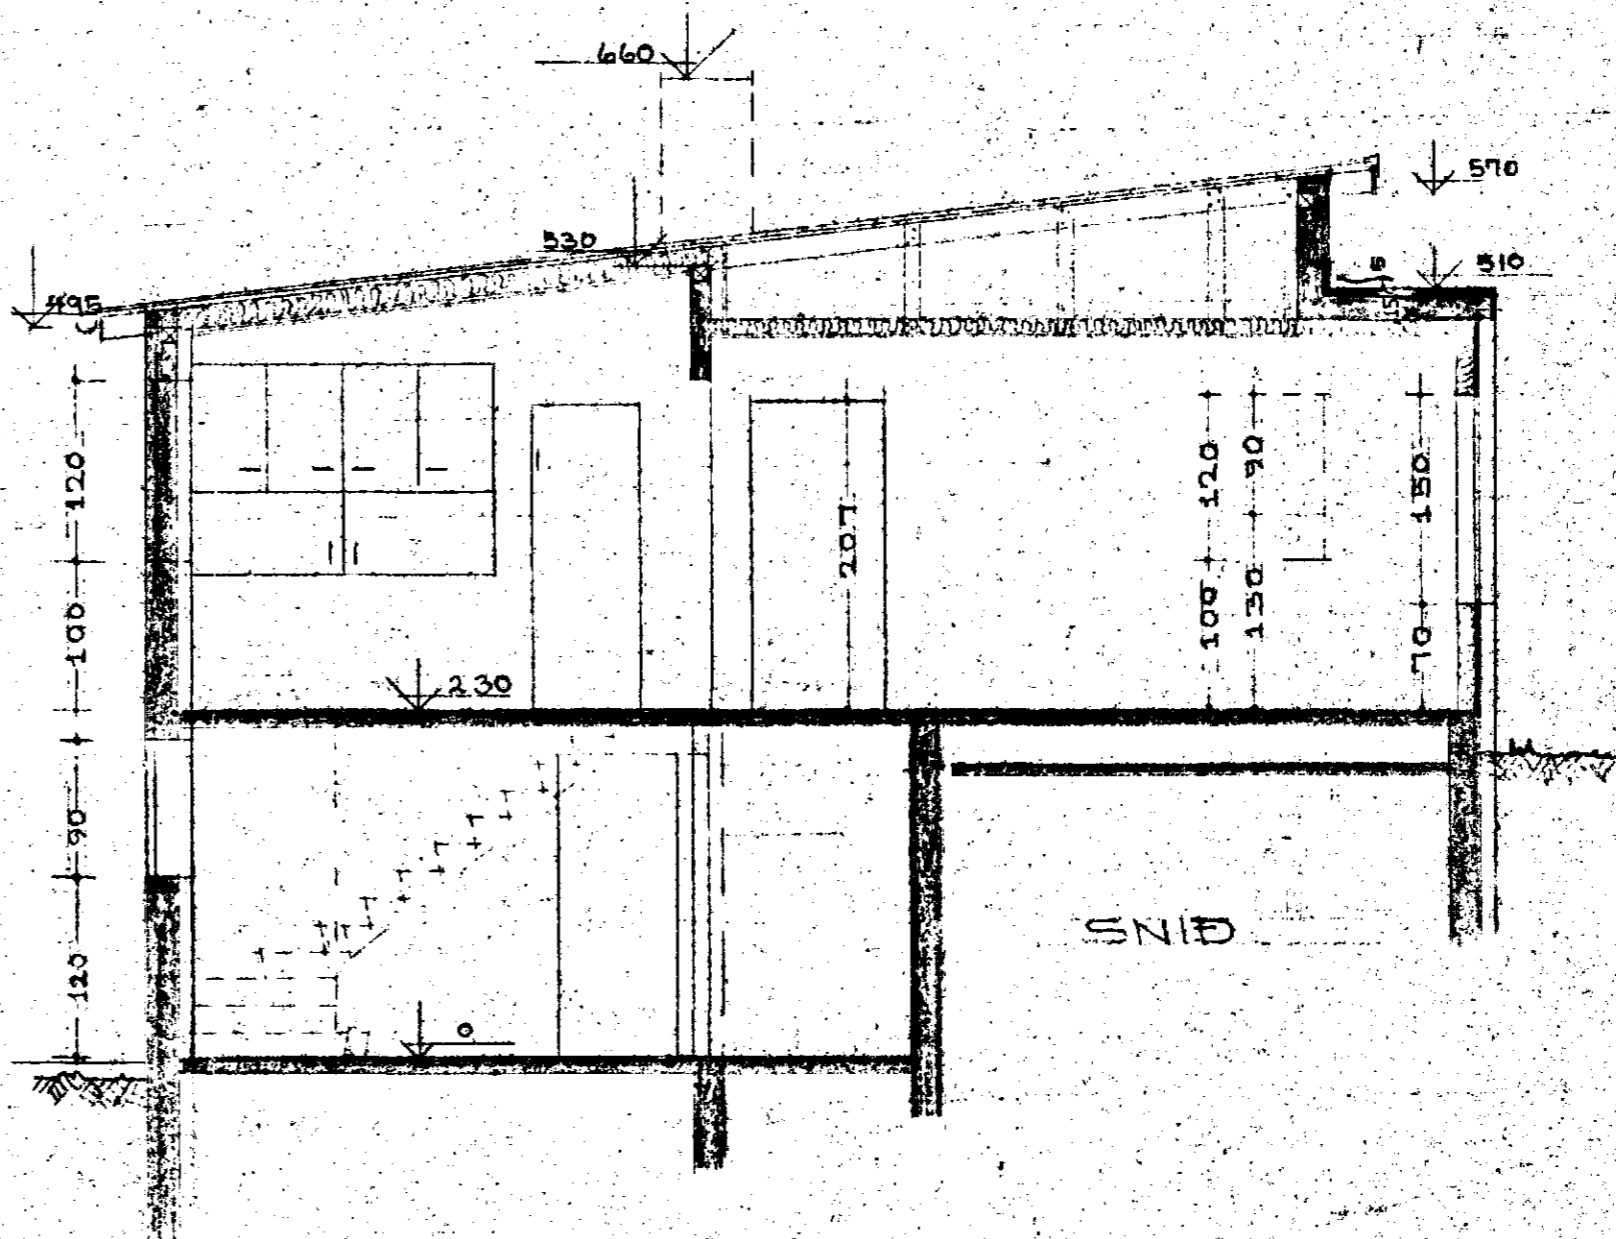
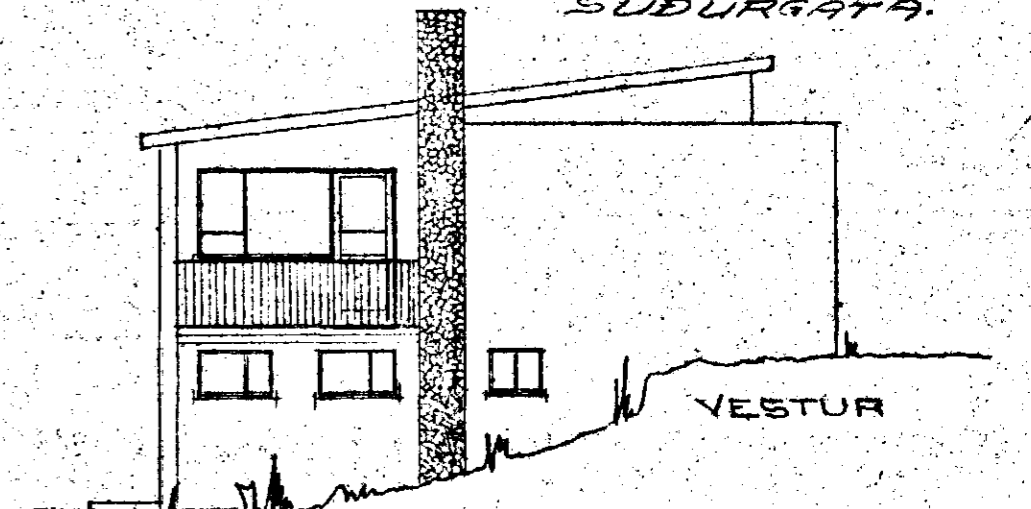


IBUDARHÚS BJÖRNS JÓNSSONAR
MÓABARÐI 16B

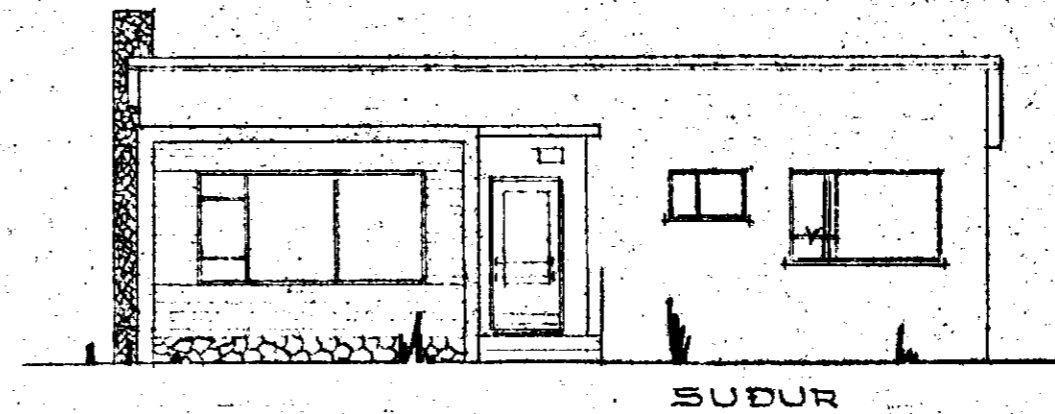

Gardur Gimlogsson
Einar Sigurdsson
24/2 '64

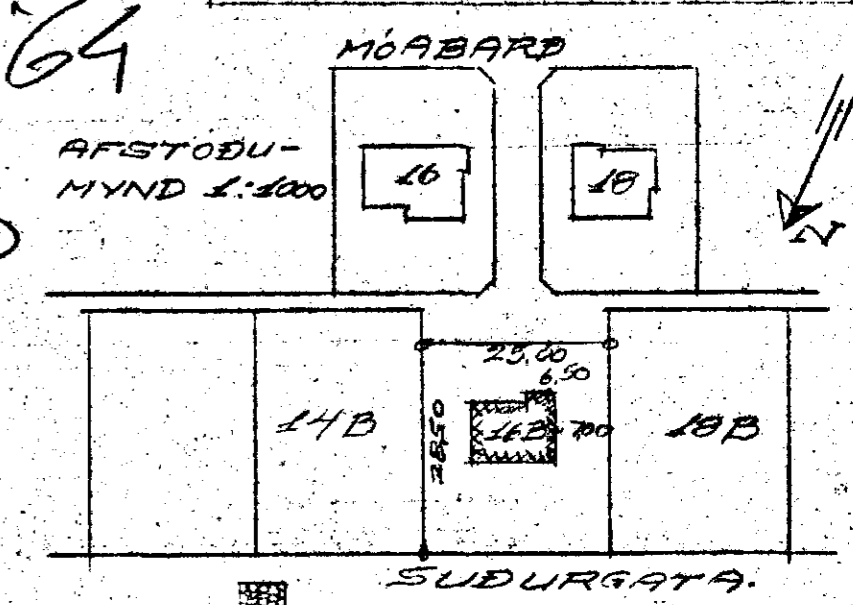

HÚSNÆÐISMÁLASTOFNUN RIKISINS		VERK
EINBYLISHÚS		VERK
VERK	GRUNNMYND OG	NR 14
SNÍÐ	M-1:50	
SVIÐ	UTLITSM. M-1:100	BLAÐ
DAGS	JAN 1959	NR 1
ARK.	<i>Haldur Halldórsson</i>	
TEIKN	<i>Eigfr Halldósson</i>	