


REVKJANESBRAUT NR 18 HAFNARFIRÐI M 1:100

Mólabara 18 B.



Samþykkt & fundi byggisá-
nefndar þ. 27/3/1963

BYGGINGAUFULTRÚINN
I HAFNARFIRÐI
Jón Bergman

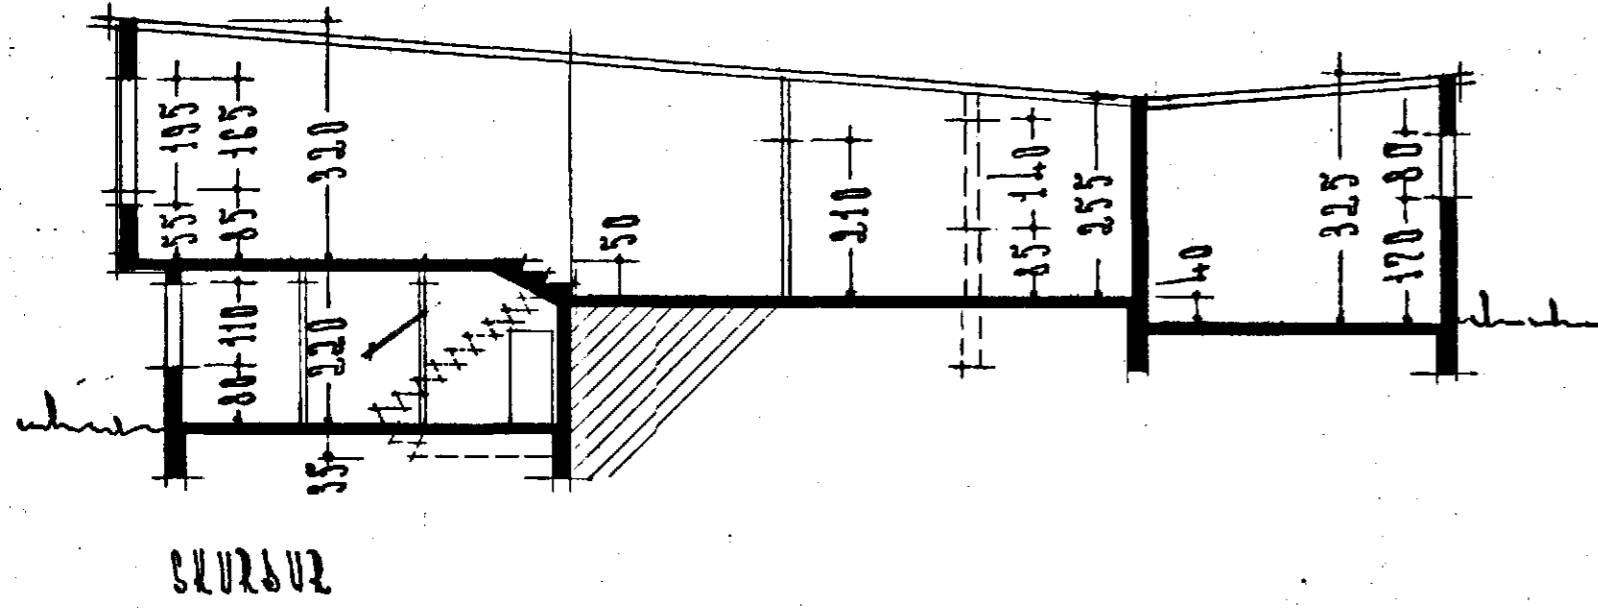

*Emma Þórunn
miska
Pjetli Pjettersson
Húsaásm.
Jón Pálsson
pípulm.*

HURÐ & HITAKLETA SKV. BYGGINGASAMF. HAFNARFIRÐI.
SÖKKLAR SKV. FYRIR MÆLUM VERTREÐINGIS

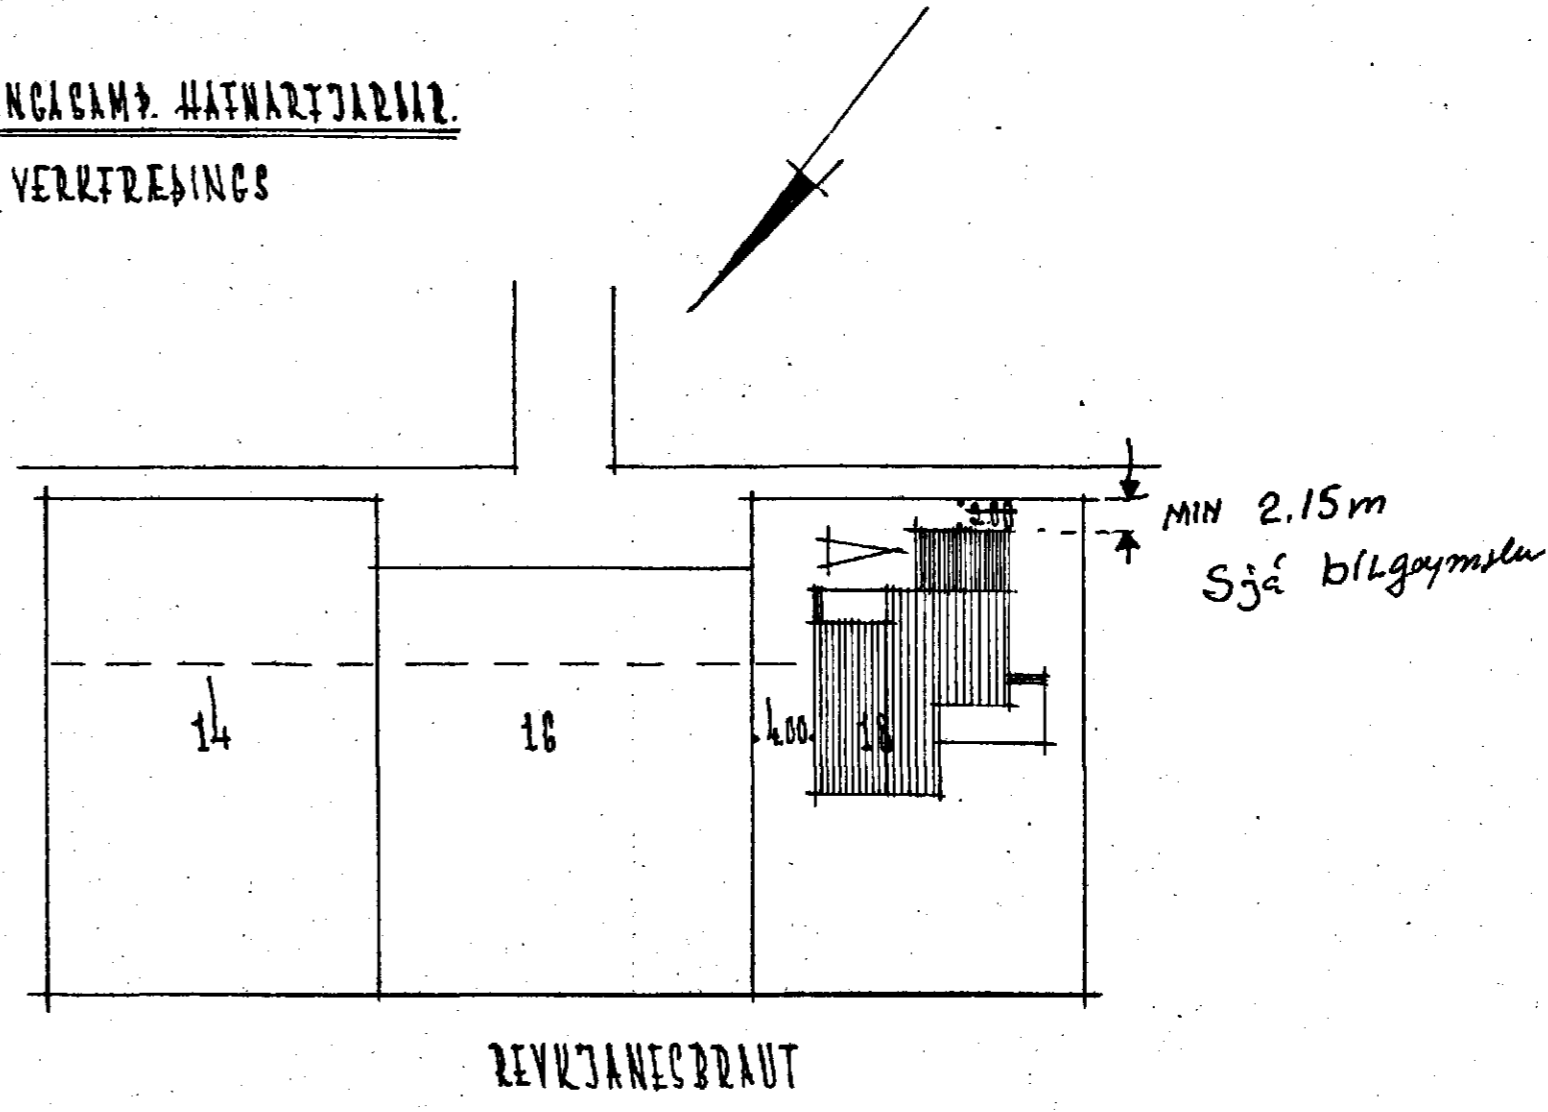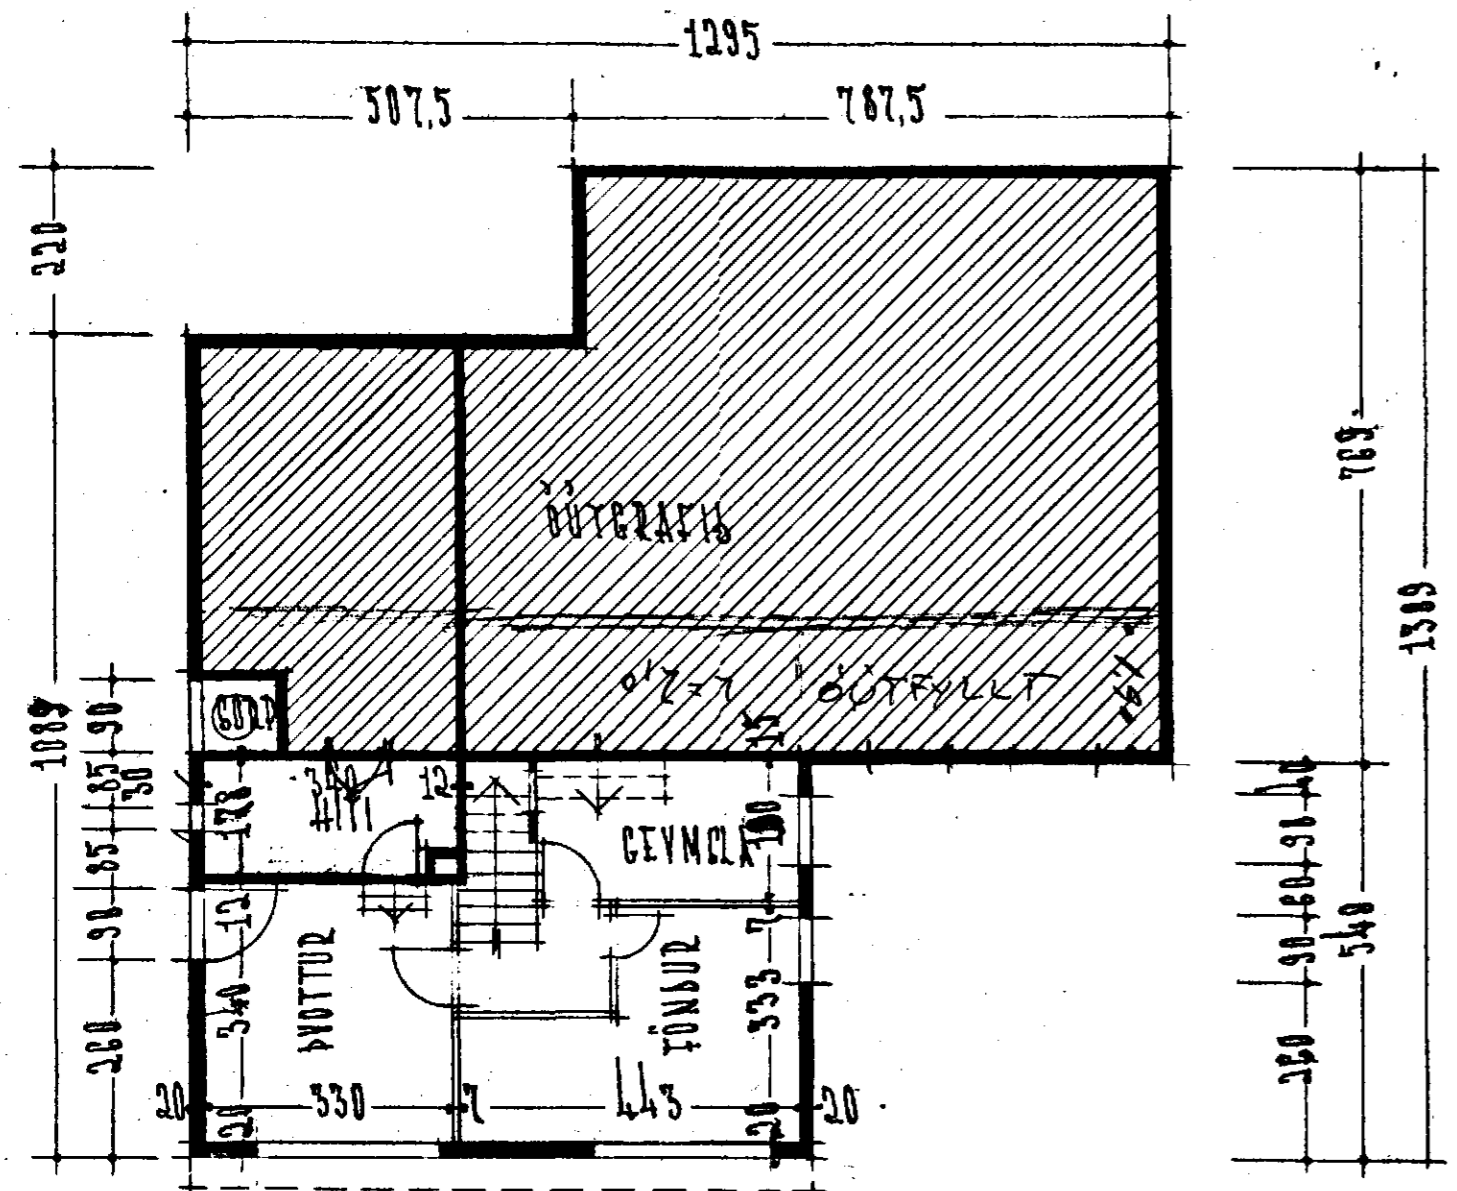

AFSTÖÐUMYNI M 1:500
FLATARMÁL 1. HEÐAR 138,25 M²

Seyftas setja glugga á kjallaran
20/5 Jón Bergman

90 240 215 240 35
820 475
1295

REVKJANÍK I MARS 1963
Hjartan Sveinsson