


Póalsteinn Egilsson
ONEFNDGATA No:




Móabard 26B

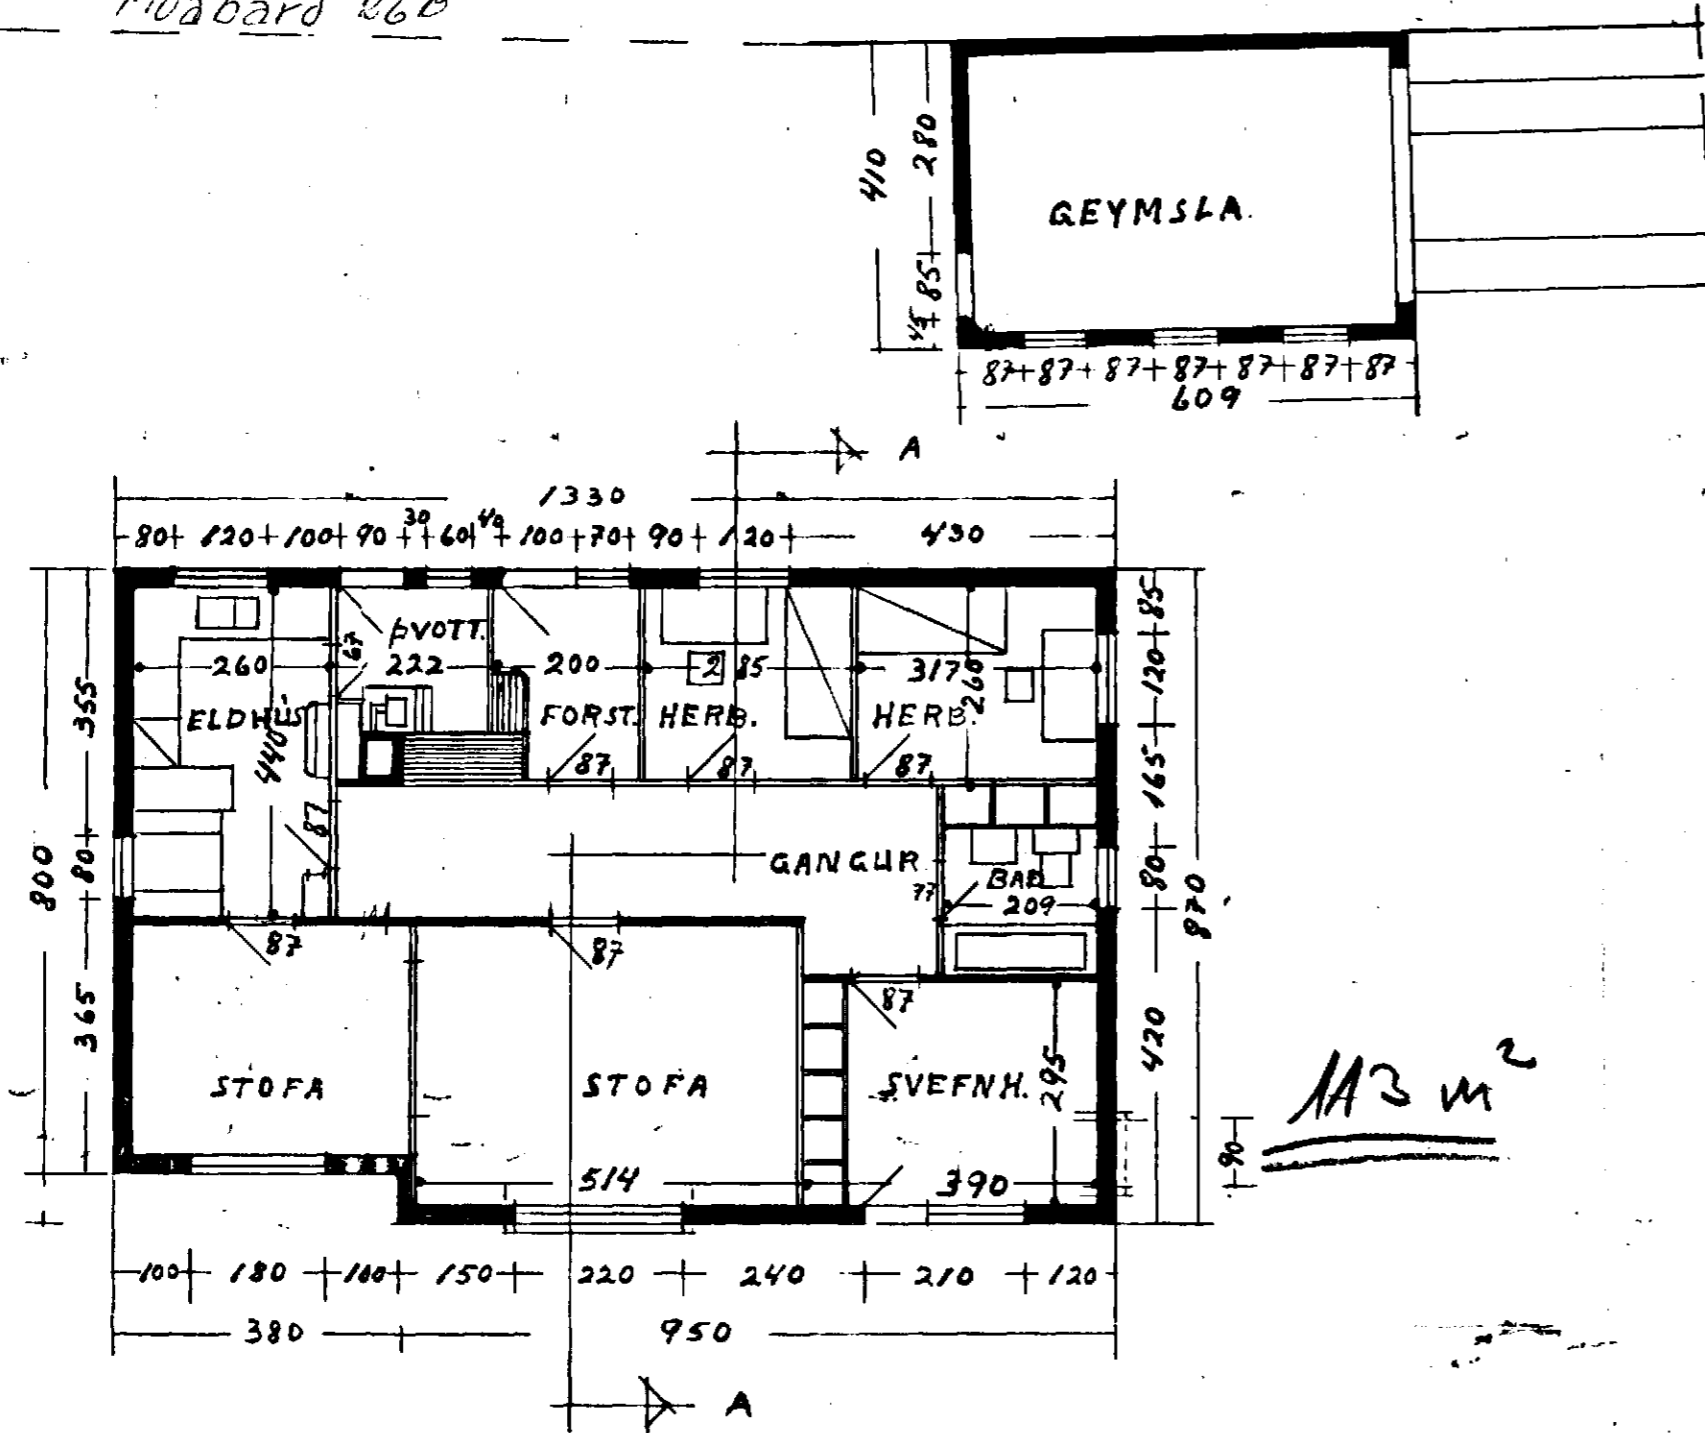




113 m²

M.K. 1:100

BREYTING MED PUNNTALINU.

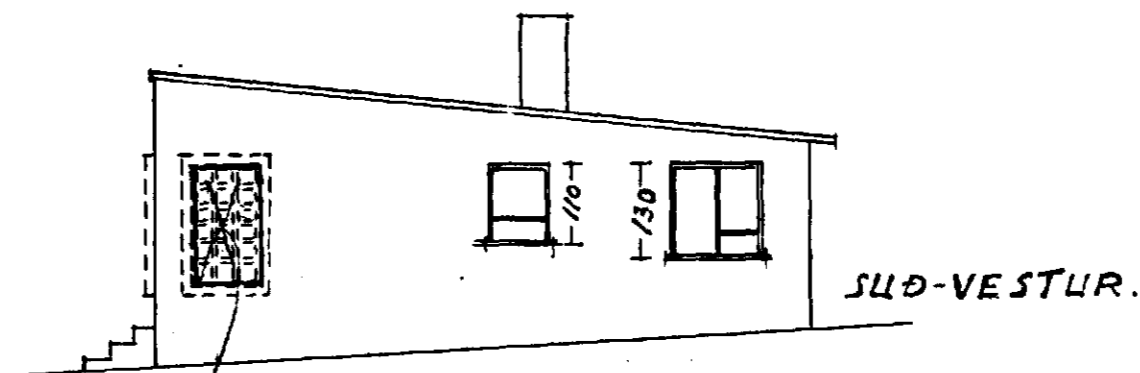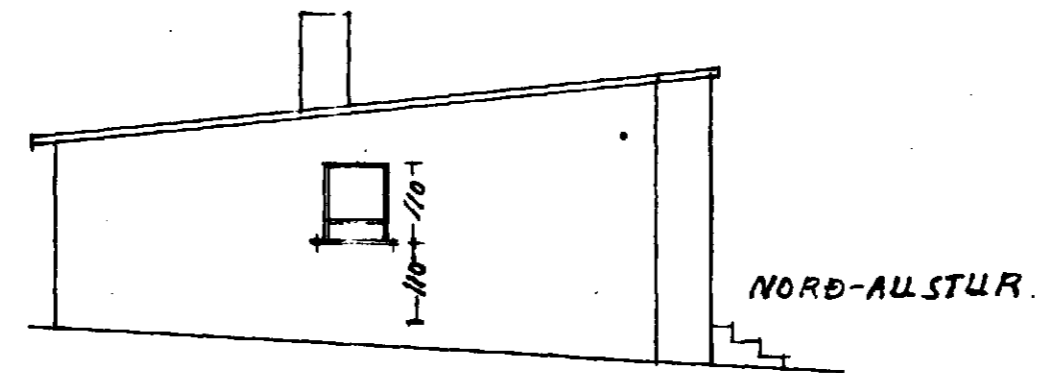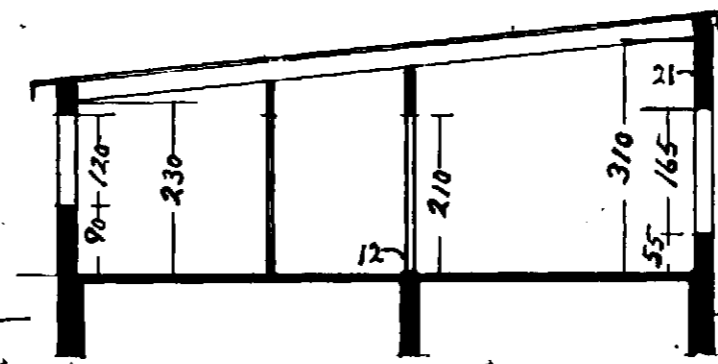

Heimilt af þessu málum
spora
8/1 F. H.

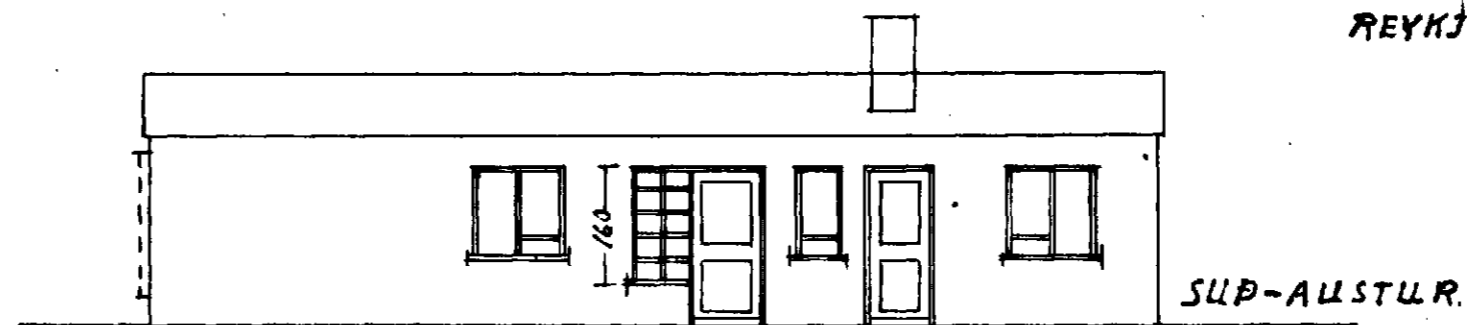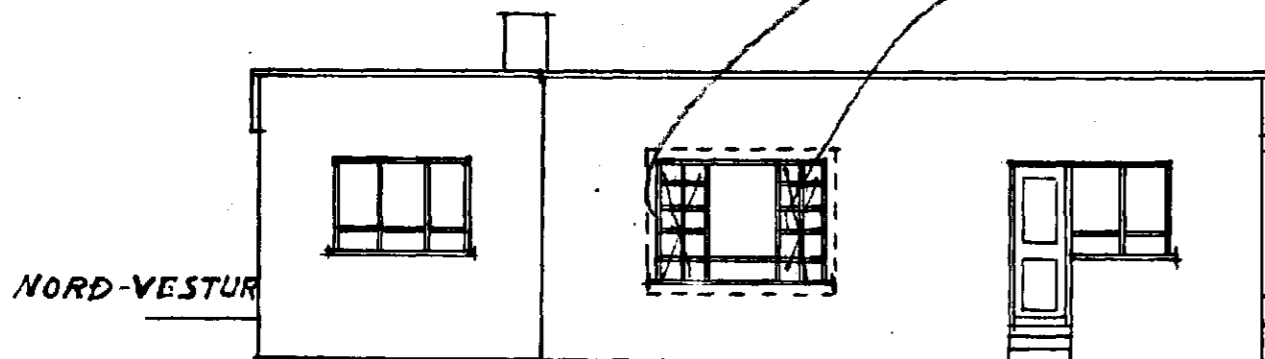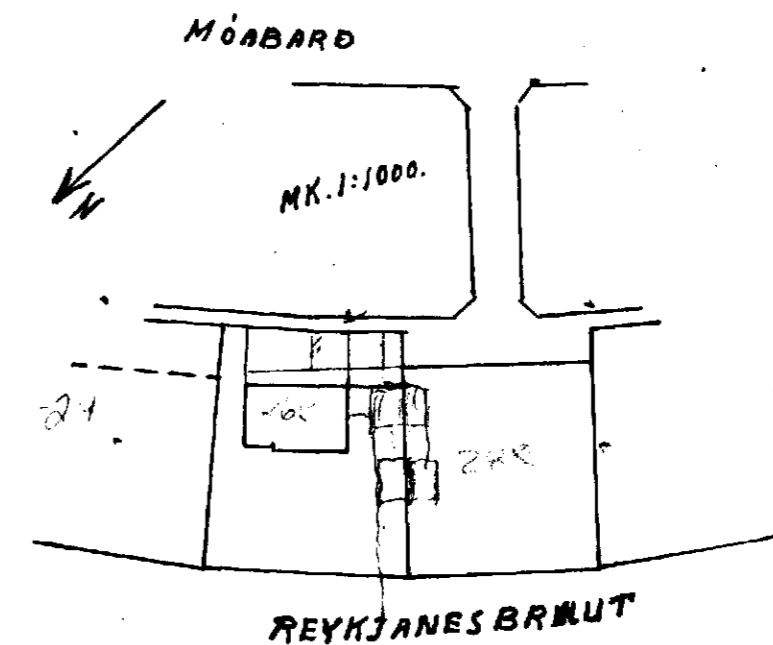

Hafnarfjörður 26. maí 1957.
Egill Egilsson.