



MÓABARÐ 36 . HAFNARFIRÐI

Samþykkt á fundi bygginga-  
nefndar þ. 23/4 1983  
BYGGINGAFULLTRÚINN  
Í HAFNARFIRÐI  
*[Signature]*

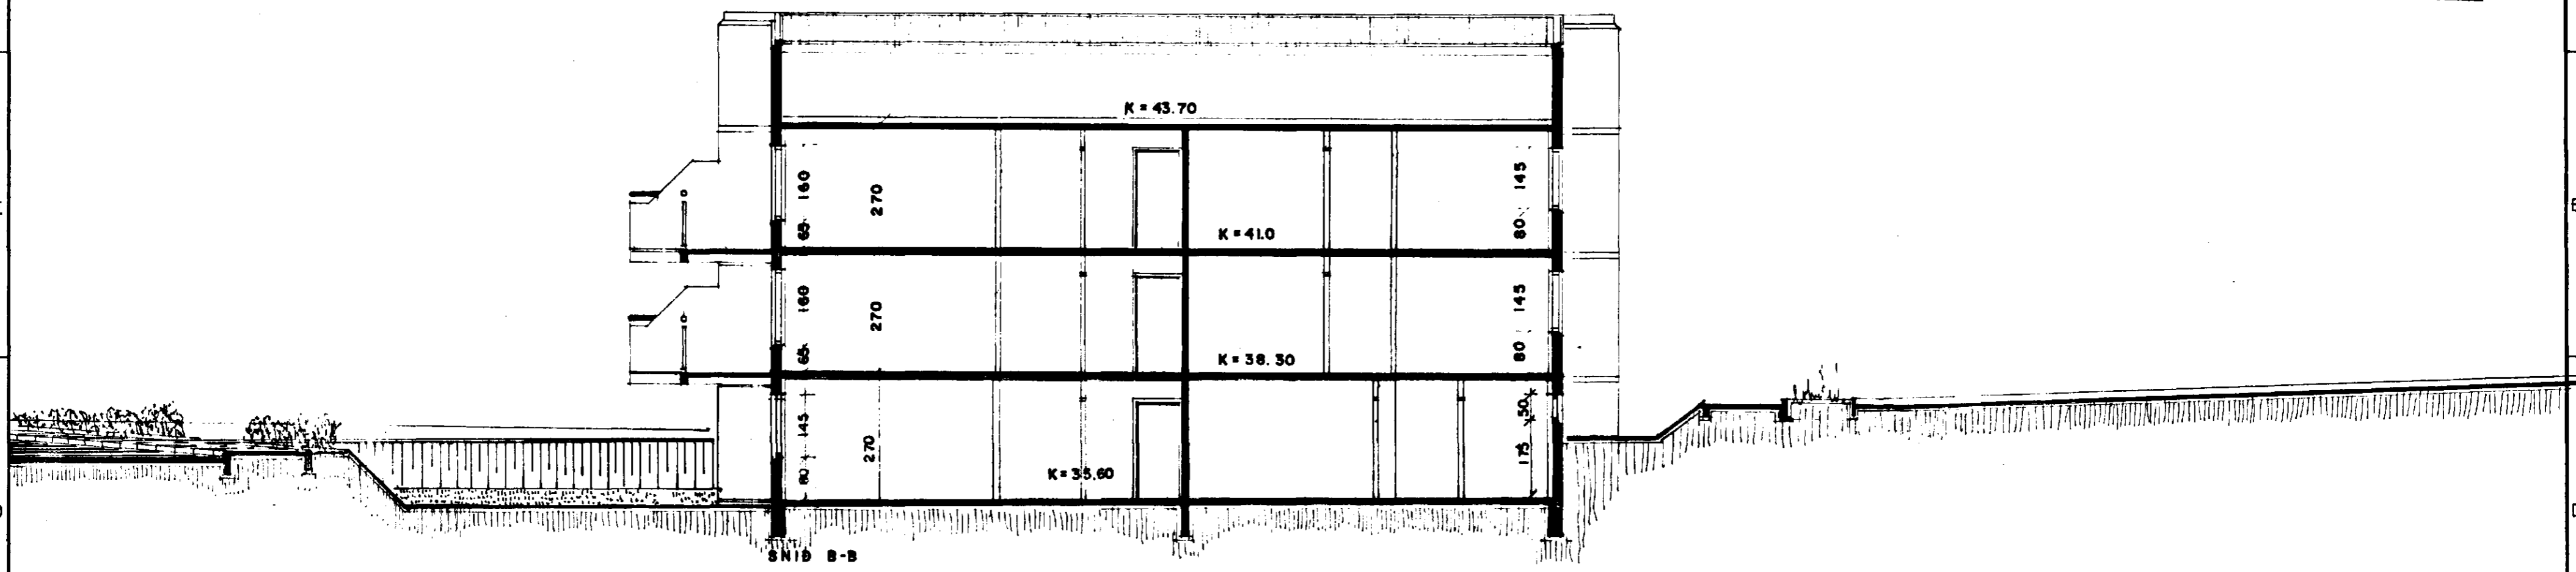

tifftopdf - www.rubissoftware.com - Demo Version

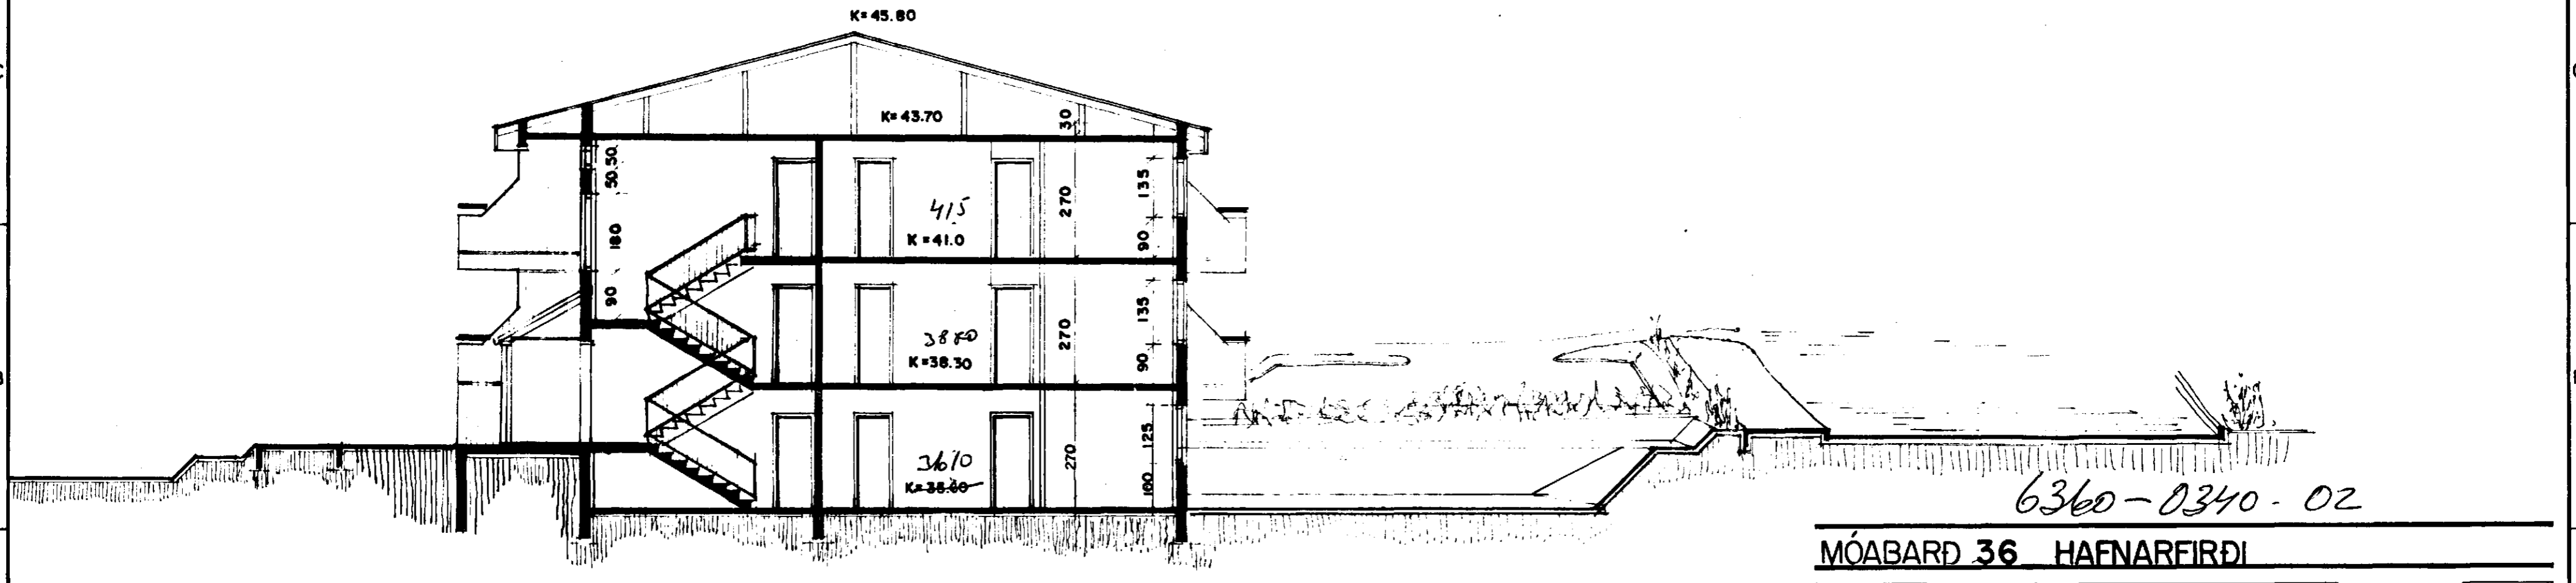

6360-0340-02

MÓABARÐ 36 HAFNARFIRÐI	
VERK : VERKAMANNABÚSTADUR	KVARNI : 1:100
TEIKNING : SNIB	VERK NR : 257 E
TEIKNAR : FEB. 83	TEIKNAR : 107
BREYTT : NOV 83	

**OD** *Ólafur Þorvaldursson*  
**ARKITEKTASTOFAN SF**  
 ÓRMAR ÞÓR GUDMUNDSSON OG ÓRNÓLFUR HALL ARKITEKTAR FAI  
 BORGARTÚN 17, REYKJAVÍK *[Signature]* Sími 26833